


Latitude 39° 40'



Longitude 80° 10'

40 S
.61 W

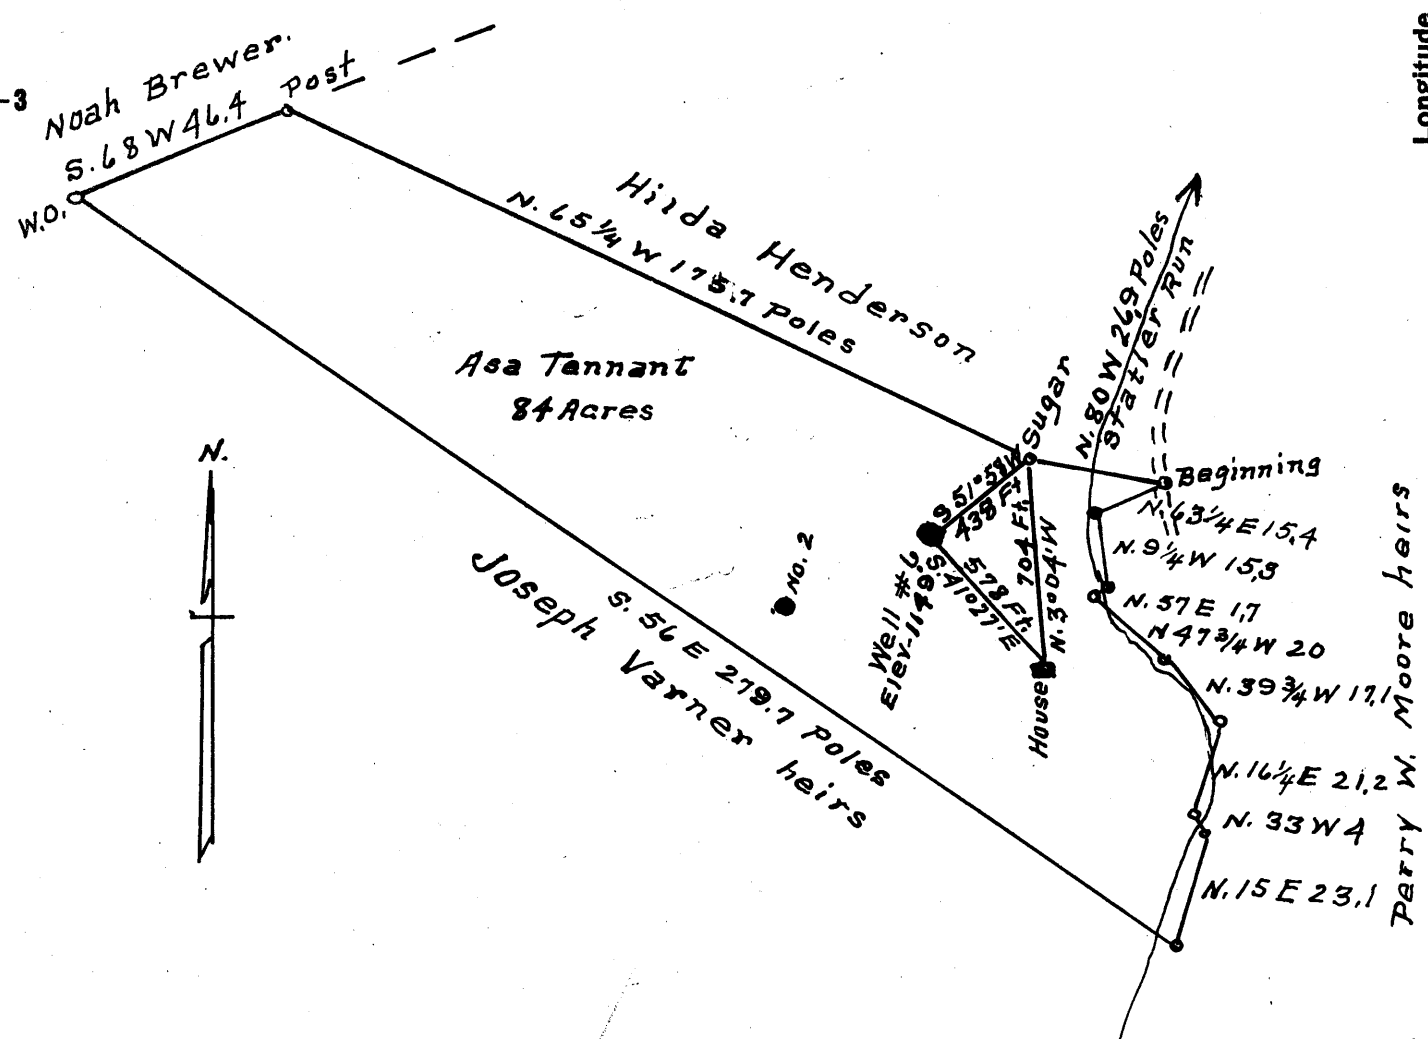

0.6 W
0.4 X

New Location ..
 Drill Deeper
 Abandonment

Surface = Ada Eberhart Michael
 Rivesville W. Va.
 Coal = Louie Eberhart
 R # 3, Fairview W Va.

NOV 23 1959

Company Dunn-Mar Oil & Gas Co.
 Address Waynesburg Pa.
 Farm Asa Tennant
 Tract 1 Acres 84 Lease No. _____
 Well (Farm) No. 6 Serial No. _____
 Elevation (Spirit Level) 1149'
 Quadrangle Blacksville
 County Monongalia District Clay
 Engineer A. G. Headley
 Engineer's Registration No. 2021
 File No. _____ Drawing No. _____
 Date 10-6-1959 Scale 1" = 660'

STATE OF WEST VIRGINIA
 DEPARTMENT OF MINES
 OIL AND GAS DIVISION
 CHARLESTON

WELL LOCATION MAP
 FILE NO. MON-637-A

+ Denotes location of well on United States Topographic Maps, scale 1 to 62,500, latitude and longitude lines being represented by border lines as shown.

- Denotes one inch spaces on border line of original tracing.

Latitude



Longitude

Topo Location

7.5' Loc. _____ 15' Loc. _____
 _____ (calc.) _____

Company Dunm-Man O+G

Farm Asa Tennant #16

15' Quad _____
(sec.)

7.5' Quad Blacksville

District Clay

WELL LOCATION PLAT

County 061 **Permit** 30637

Oil

WELL RECORD

J.H. McDermott Oil

COMPANY

Record of Well No. 6 on Asa Tennant Farm 200 Acres
Jakes Run Field Clay District Monongalia County W. Va. State
 Rig Commenced 19 Completed 19
 Drilling Commenced 19 Completed 19
 Cost Per Foot Contractor Address
 Drillers Names

CONDUCTOR AND CASING USED IN DRILLING

Conductor 13 inch 10 inch 8 1-4 inch 6 5-8 inch 5 3-16 inch 4 inch 3 inch 2 inch

CONDUCTOR AND CASING LEFT IN WELL

Conductor 13 inch 10 inch 8 3-4 inch 6 5-8 inch 5 3-16 inch 4 inch 3 inch 2 inch

Formation	Top	Bottom	Thickness	Formation	Top	Bottom	Thickness
GRAVEL OR QUICK SAND FIRST WATER BLUFF SAND				FORMATION SQUAW			
NATIVE COAL				BEREA			
WBG. COAL				GANTZ			
MAPEL COAL				FIFTY FOOT			
PGL. COAL	<u>635</u>			THIRTY FOOT			
MURPHY SAND				GORDON STRAY			
LITTLE DKRD.				GORDON			
BIG DKRD.				FOURTH			
GAS SAND				FIFTH			
FIRST SALT SAND							
SECOND SALT SAND				BAYARD			
LITTLE LIME							
PENCIL CAVE				ELIZABETH			
BIG LIME							
BIG INJUN							
<u>Oil</u>	<u>2041</u>			TOTAL DEPTH	<u>2059</u>		

Gas Test Open

Minute Test

Oil Production

Well Tubed with

Well Tubed with 2035

Tubing Packer Set in

Tubing 6 Ft. working bbl.

Sand, Top of Packer,

Anchor, Perforation at, 18

Perforation

Air Hole

2047

2001

SHOT RECORD

Date	Amount	Size of Shell	Top	Bottom	Oil on Shot	Results
Nodate	40 qts,					
" "	20 "					
Oct. 18 1899	30 "	3 10qt. Bigs	2040			No good
Sept. 2 1900	60 "	2 30"	2040	2051		12 1/2 bbls.
May 28 1903	60 "	2 " "	2039	2050		6 1/2 "
May 29 1907	70 "	2 20" 3 10 qt.	2038	2047		No good

REMARKS: