

STATE OF WEST VIRGINIA
DEPARTMENT OF ENVIRONMENTAL PROTECTION
OFFICE OF OIL AND GAS

AFFIDAVIT OF PLUGGING AND FILLING WELL

AFFIDAVIT SHOULD BE IN TRIPLICATE, one copy mailed to the Department, one copy to be retained by the Well Operator and the third copy (and extra copies if required) should be mailed to each coal operator at their respective addresses.

Farm name: Estep, William Operator Well No.: Victory A 3617

LOCATION: Elevation: 1477' Quadrangle: Wileyville
District: Proctor County: Wetzel
Latitude: 5715 Feet South of 39 Deg. 42 Min. 30 Sec.
Longitude: 270 Feet West of 80 Deg. 42 Min. 30 Sec.

Well Type: OIL _____ GAS X

Company Columbia Gas Transmission, LLC
1700 MacCorkle Avenue S.E., P.O. Box 1273
Charleston, WV 25325

Coal Operator Consol RCPC, LLC
or Owner 275 Technology Drive, Suite 100
Canonsburg, PA 15317

Agent Brad Nelson, Storage Engineer
Permit Issued Date 4/23/2026

Coal Operator
or Owner

RECEIVED
Office of Oil and Gas

JUL 30 2026

WV Department of
Environmental Protection

AFFIDAVIT

STATE OF WEST VIRGINIA,
County of Wetzel ss:

Brad Nelson and Ray Smith being first duly sworn according to law depose and say that they are experienced in the work of plugging and filling oil and gas wells and were employed by the above named well operator, and participated in the work of plugging and filling the above well say that said work was commenced on the 24th day of June, 2026, and the well was plugged and filled in the following manner:

TYPE	FROM	TO	PIPE REMOVED	LEFT
Class A Cement	0'	506'	N/A	7", 8-5/8", 10-3/4"
Class A Cement	506'	1715'	N/A	7", 8-5/8"
Class A Cement	1715'	1917'	N/A	7"
Cast Iron Bridge Plug (CIBP)	1917'	1963'	N/A	7"
Class A Cement	1963'	2246'	N/A	7"
Class A Cement	2246'	2258'	N/A	N/A

Description of monument: 7" diameter pipe, 4' above GL, API and date affixed and that the work of plugging and filling said well was completed on the 9th day of July, 2026.

And further deponents saith not.

Sworn and subscribe before me this 11th day of July, 2026

My commission expires: 10/23/2024

Commonwealth of Pennsylvania - Notary Seal
Jennifer Lupi, Notary Public
Washington County
My commission expires October 23, 2027
Commission number 1282201

Notary Public
Digitally signed by Stephen
Mccoy
Date: 2026.07.23 08:51:26 -04'00'

Stephen Mccoy

Affidavit reviewed by the Office of Oil and Gas: _____ Title: _____

08/07/2026


~ not to scale ~

Victory A 3617

API 47-103-00266


Post P&A

(as of 7/14/2026)

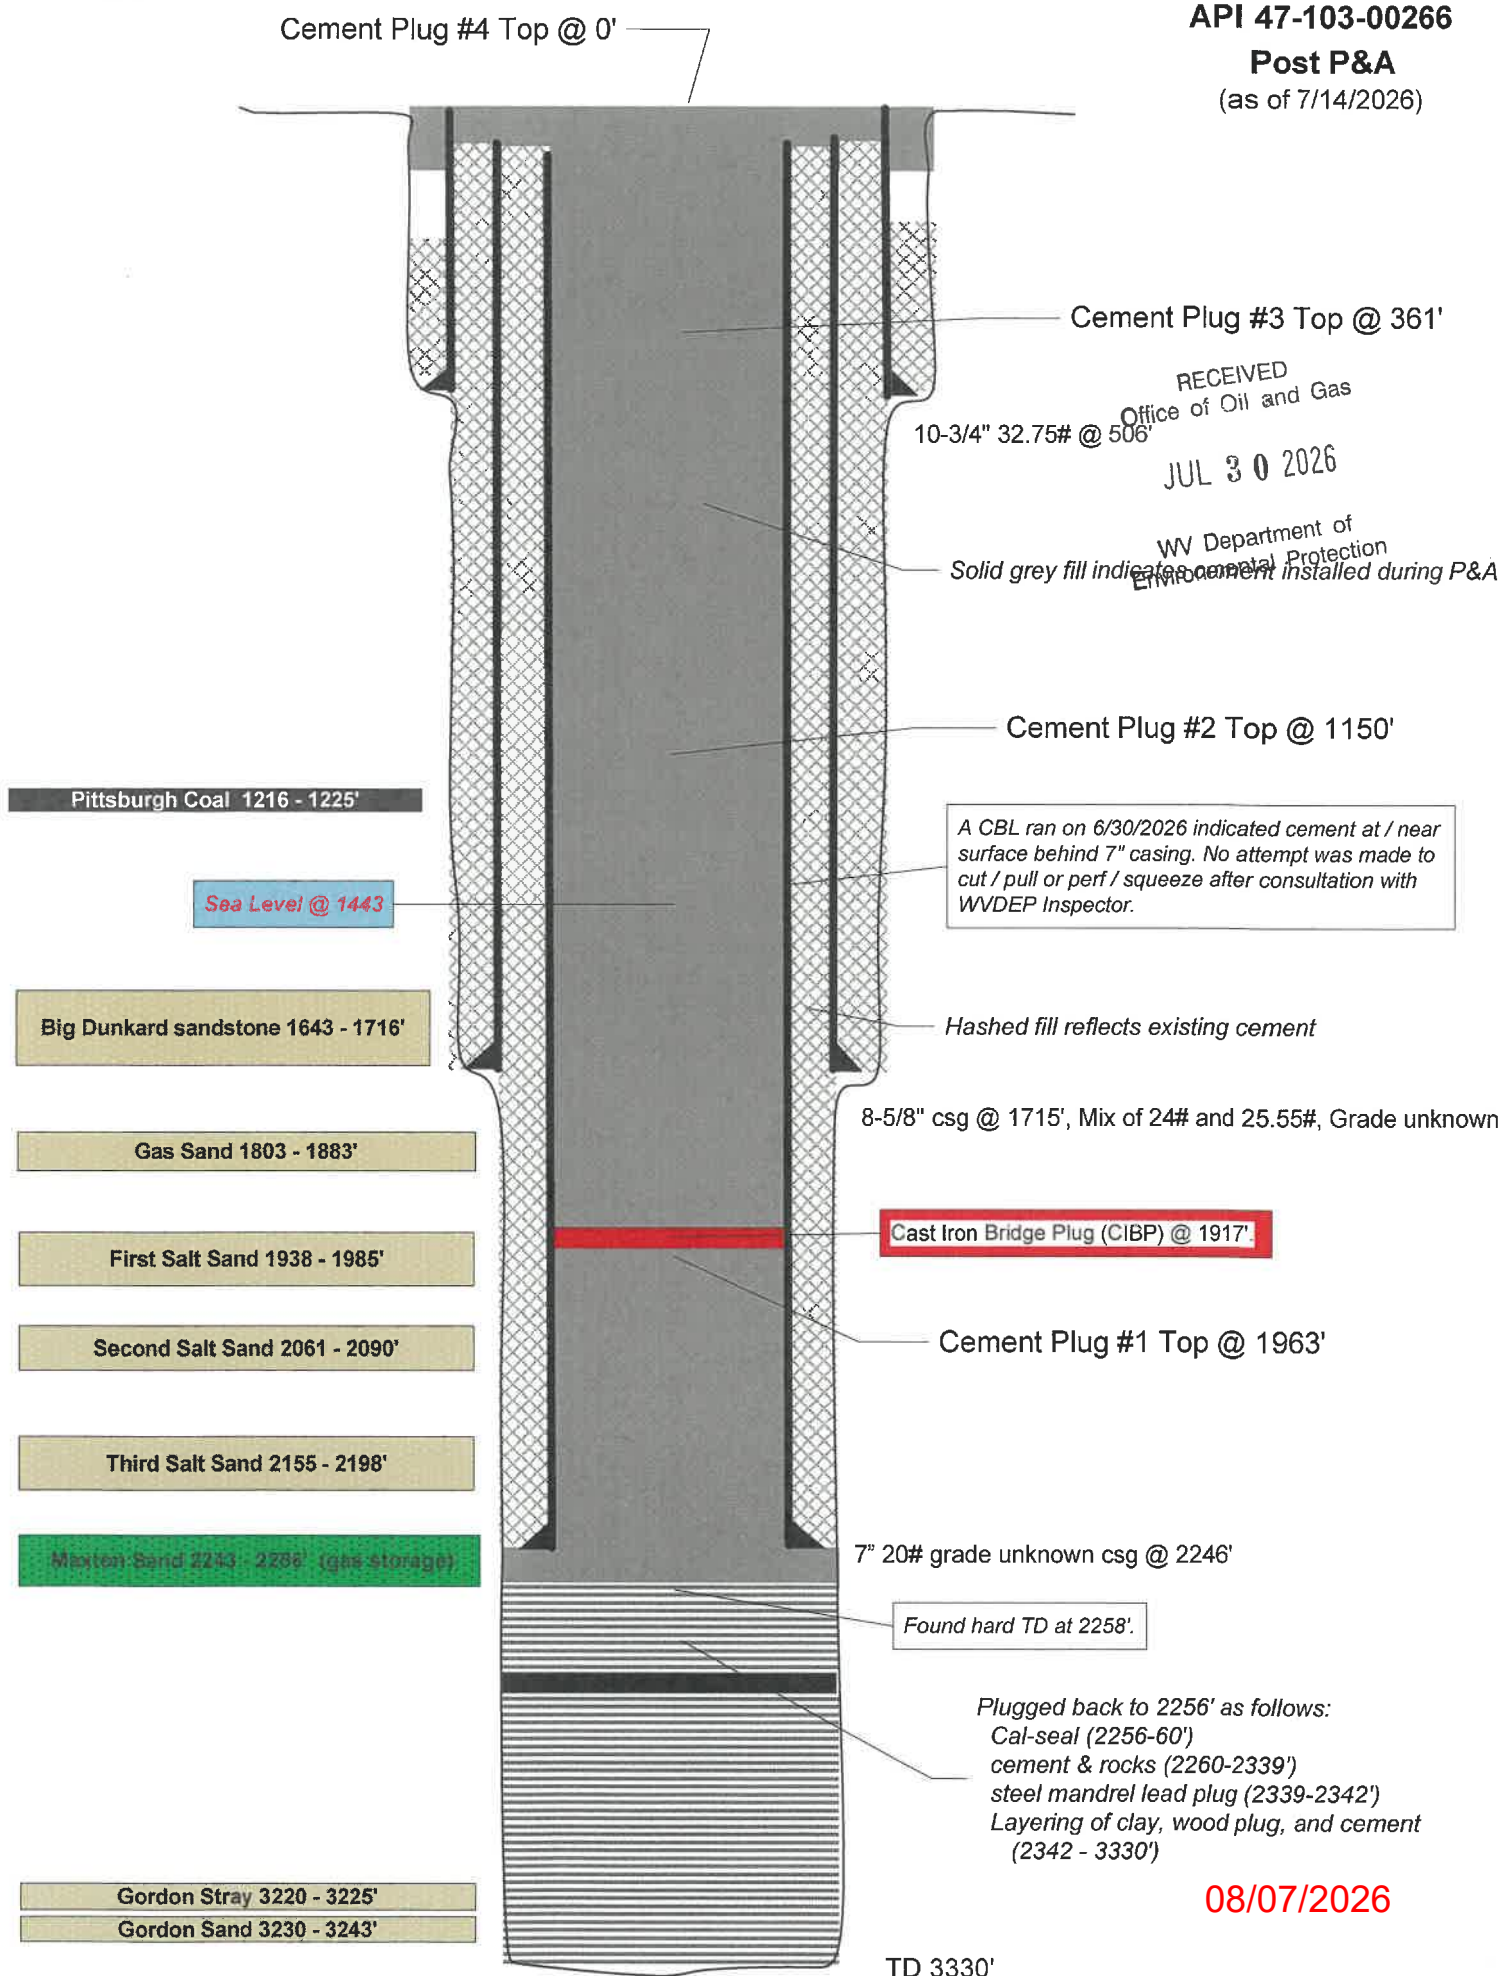

~ not to scale ~

Victory A 3617
API 47-103-00266
Prior to P&A
(as of 3/16/24)

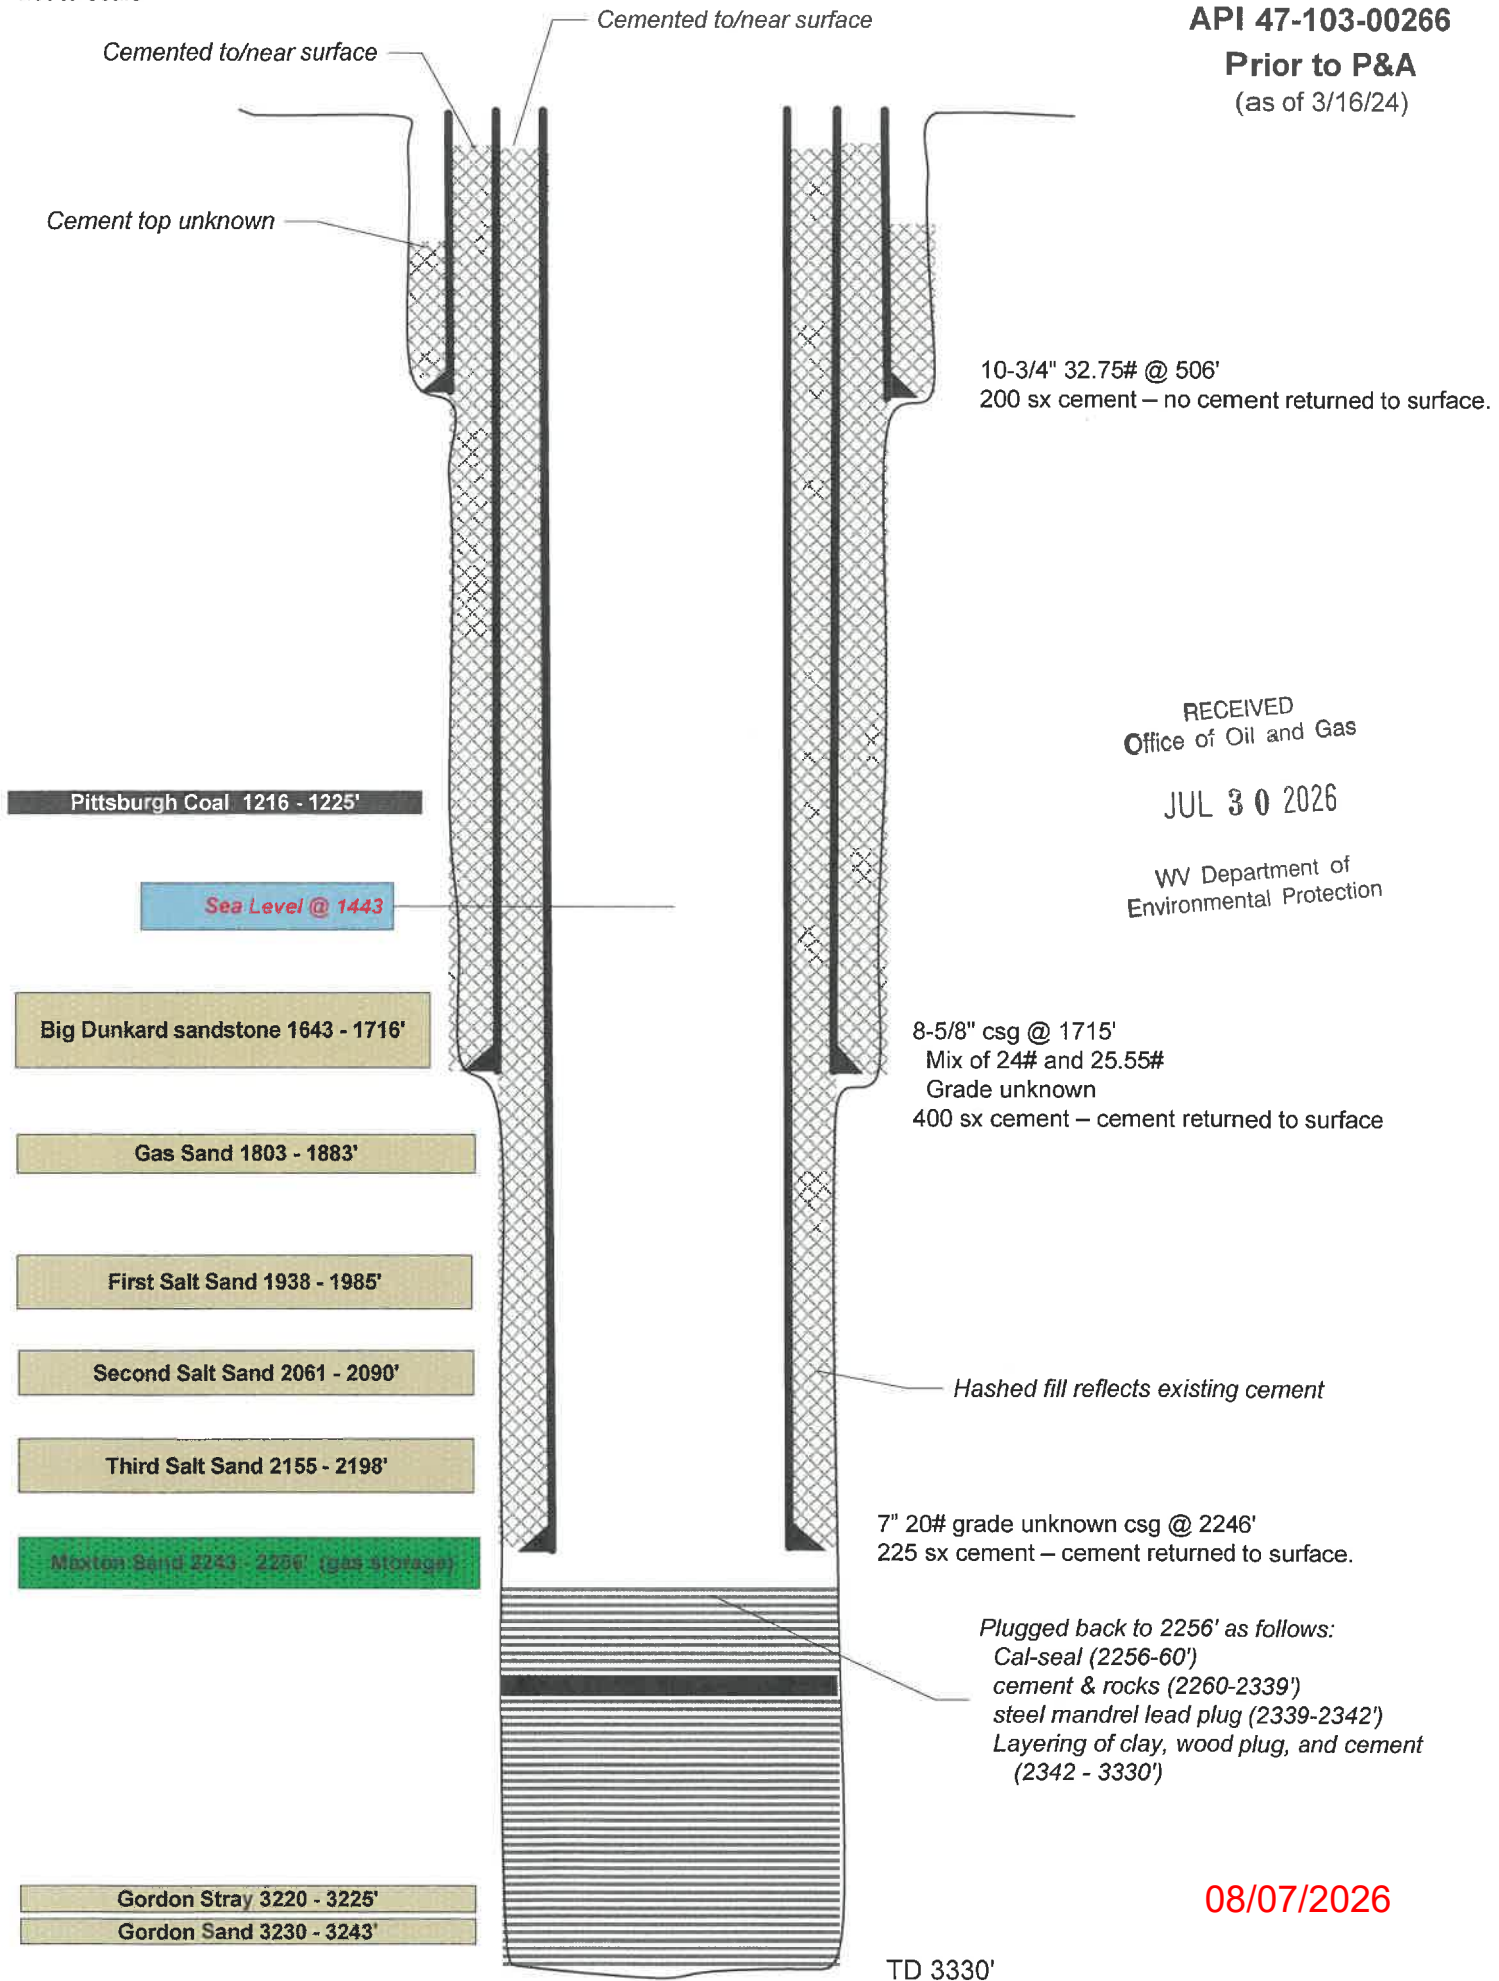

RECEIVED
Office of Oil and Gas
JUL 30 2026
WV Department of
Environmental Protection

08/07/2026