

0.95 W
3.50 S


Coal owned by:
S Austin Smith
E'
State of West Virginia

J. B. Dewhurst Lease
3100%

Surface Owned by:
C. Burke Morris
Oral P. Kyler
S. Austin Smith
Clarksburg
W. Va.

Blackshere Wells & Co.

John Price
Surface

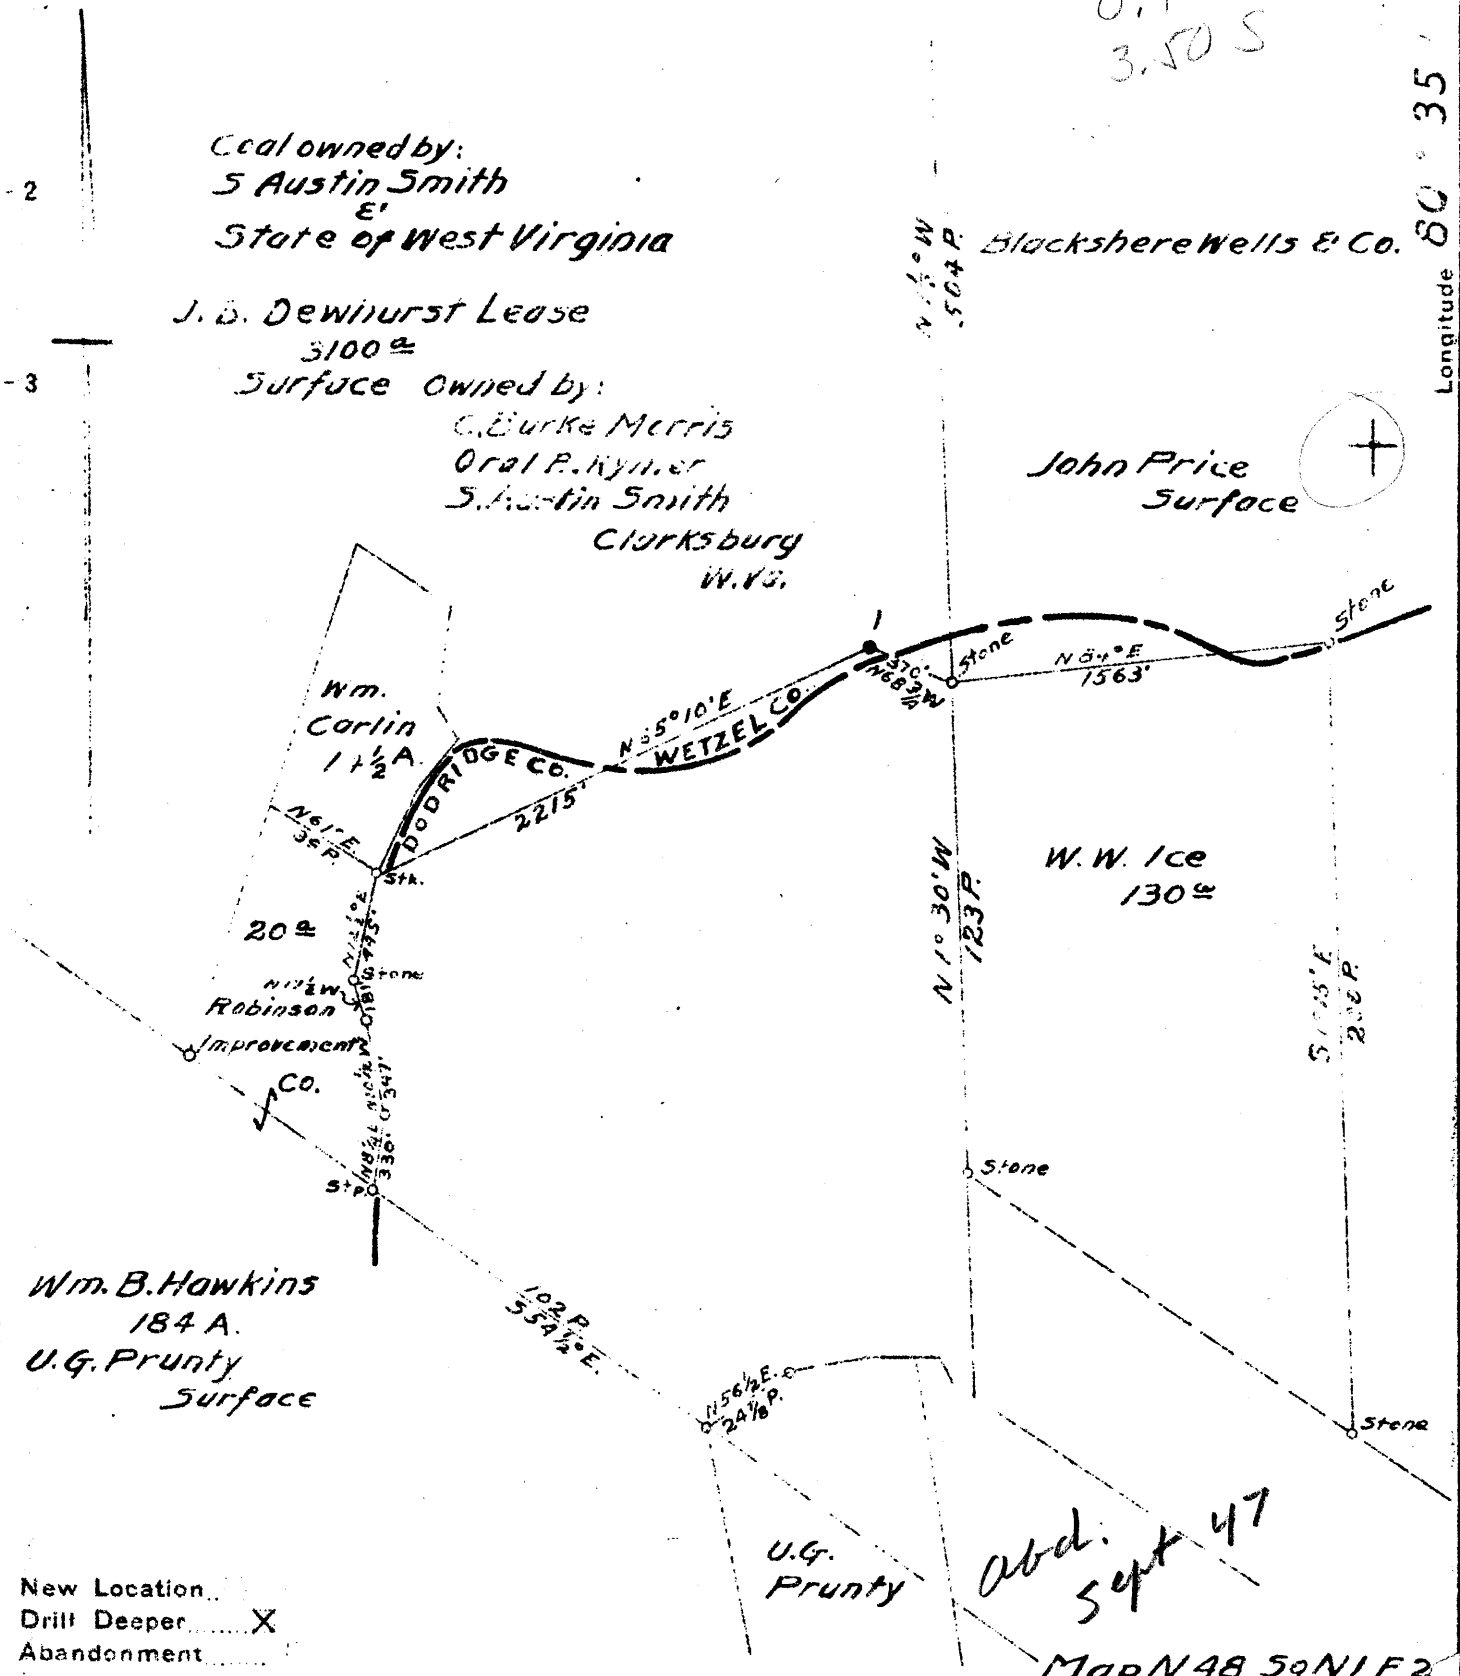

New Location
Drill Deeper X
Abandonment

Company South Penn Nat. Gas Co.
Address Farkersburg, W. Va.
Farm J. B. Dewhurst
Tract _____ Acres 1262 Lease No. 10253
Well (Farm) No. 1 Serial No. _____
Elevation (Spirit Level) 1335.8 Ground
Quadrangle Center Point
County Wetzel District Grant
Engineer A. C. Hilbert
Engineer's Registration No. _____
File No. _____ Drawing No. _____
Date Aug. 8, 1944 Scale 1" = 800'

STATE OF WEST VIRGINIA
DEPARTMENT OF MINES
OIL AND GAS DIVISION
CHARLESTON

WELL LOCATION MAP
FILE NO. WET-319

+ Denotes location of well on United States Topographic Maps, scale 1 to 62,500, latitude and longitude lines being represented by border lines as shown.

- Denotes one inch spaces on border line of original tracing.

WEST VIRGINIA DEPARTMENT OF MINES
OIL & GAS DIVISION
W E L L R E C O R D

Permit No. Wet 319		Gas Well
Centerpoint Quad.		CASING & TUBING
Company	South Penn Natural Gas Company	
Address	Union Trust Bldg., Parkersburg, W.Va.	
Farm	J.B. Dewhurst Acres 1262	5 3/16 3129 Sm.
Location	Buffalo Run	
Well No.	1-Drill deeper Elev 1335.8	
District	Grant Wetzel County	
Surface	S.A. Smith et al, Clarksburg, W.Va.	
Mineral	Same	
Commenced	January 22, 1945 (deeper)	
Completed	Feb. 16, 1945 "	
Not shot		
Open flow	52/10ths W in 1"	
Volume	53,794 C.F.	
Rock Pressure	144 lbs. 24 hrs.	
No oil		

Drilled Deeper

Commenced drilling deeper	2507	
Big Injun Sand	2410 2542	
Slate & Lime	2542 2572	
Slate	2572 2590	
Lime	2590 2608	
Slate	2608 2615	
Lime	2615 2655	
Slate	2655 2663	
Lime	2663 2735	
Slate	2735 2742	
Lime	2742	
Slate	2760 2777	
Lime	2777 2792	
Slate	2792 2816	
Gritty Lime	2816 2835	
Slate	2835 2862	
Gritty Lime	2862 2873	
Slate	2873 2883	
Lime	2883 2896	
Sand	2896 2920	
Slate	2920 2935	
Lime Shell	2935 2974	
Lime	2974 2995	
Slate-Shells	2995 3057	
Lime	3057 3078	
Slate	3078 3094	
Boulder Sand	3094 3119	
Slate & Shells	3119 3160	
Gordon Sand	3160 3176	
Slate & Shells	3176 3222	
4th Sand	3222 3232	
Slate	3232 3241	
Lime	3241 3252	
Slate & Shells	3252 3316	
Lime	3316 3325	
Slate	3325 3338	
Gritty Lime	3338 3348	
Slate	3348 3374	
Lime	3374 3387	
Slate	3387 3393	
5th Sand	3393 3400	
Slate	3400 3413	
Bayard Sand	3413 3414	Gas 3413-14 53,794 C.F.
Slate & Lime	3414 3422	
TOTAL DEPTH	3432	