

STATE OF WEST VIRGINIA
DEPARTMENT OF ENVIRONMENTAL PROTECTION
OFFICE OF OIL AND GAS

AFFIDAVIT OF PLUGGING AND FILLING WELL

AFFIDAVIT SHOULD BE IN TRIPLICATE, one copy mailed to the Department, one copy to be retained by the Well Operator and the third copy (and extra copies if required) should be mailed to each coal operator at their respective addresses.

Farm name: Geho, W.E. Operator Well No.: Victory B 4451

LOCATION: Elevation: 1137' Quadrangle: Wileyville
District: Center County: Wetzel
Latitude: 11060 Feet South of 39 Deg. 45 Min. 00 Sec.
Longitude: 4065 Feet West of 80 Deg. 37 Min. 30 Sec.

Well Type: OIL _____ GAS X

Company	<u>Columbia Gas Transmission, LLC</u>	Coal Operator	<u>Consol RCPC, LLC</u>
	<u>1700 MacCorkle Avenue S.E., P.O. Box 1273</u>	or Owner	<u>275 Technology Drive, Suite 101</u>
	<u>Charleston, WV 25325</u>		<u>Canonsburg, PA 15317</u>
Agent	<u>Brad Nelson, Storage Engineer</u>	Coal Operator	<u>Marshall County Coal Resources, Inc.</u>
Permit Issued Date	<u>4/15/2026</u>	or Owner	<u>46226 National Road West</u>
			<u>St. Clairsville, OH 43950</u>

AFFIDAVIT

STATE OF WEST VIRGINIA,
County of Wetzel ss

RECEIVED
Office of Oil and Gas

JUL 30 2026

Brad Nelson and Steve Simmons being first duly sworn according to law depose and say that they are experienced in the work of plugging and filling oil and gas wells and were employed by the above named well operator, and participated in the work of plugging and filling the above well say that said work was commenced on the 24th day of June, 2026, and the well was plugged and filled in the following manner:

TYPE	FROM	TO	PIPE REMOVED	LEFT
Class A Cement	0'	367'	N/A	7", 8-5/8", 10-3/4"
Class A Cement	367'	1387'	N/A	7", 8-5/8"
Class A Cement	1387'	1680'	N/A	7"
Cast Iron Bridge Plug (CIBP)	1680'	1687'	N/A	7"
Class A Cement	1687'	2020'	N/A	7"
Class A Cement	2020'	2285'	N/A	N/A

Description of monument: 7" diameter pipe, 4' above GL, API affixed and that the work of plugging and filling said well was completed on the 13th day of July, 2026.

And further deponents saith not.

Commonwealth of Pennsylvania - Notary Seal
Jennifer Lupi, Notary Public
Washington County
My commission expires October 23, 2027
Commission number 1282201

Sworn and subscribe before me this 16th day of July, 2026


My commission expires: 10/23/2027

Stephen McCoy
Notary Public
Digitally signed by Stephen McCoy
Date: 2026.07.23 08:52:22 -04'00'

Affidavit reviewed by the Office of Oil and Gas: _____ Title: 08/07/2026

~ not to scale ~

Victory B 4451
API 47-103-00450
Post P&A
(as of 7/15/2026)

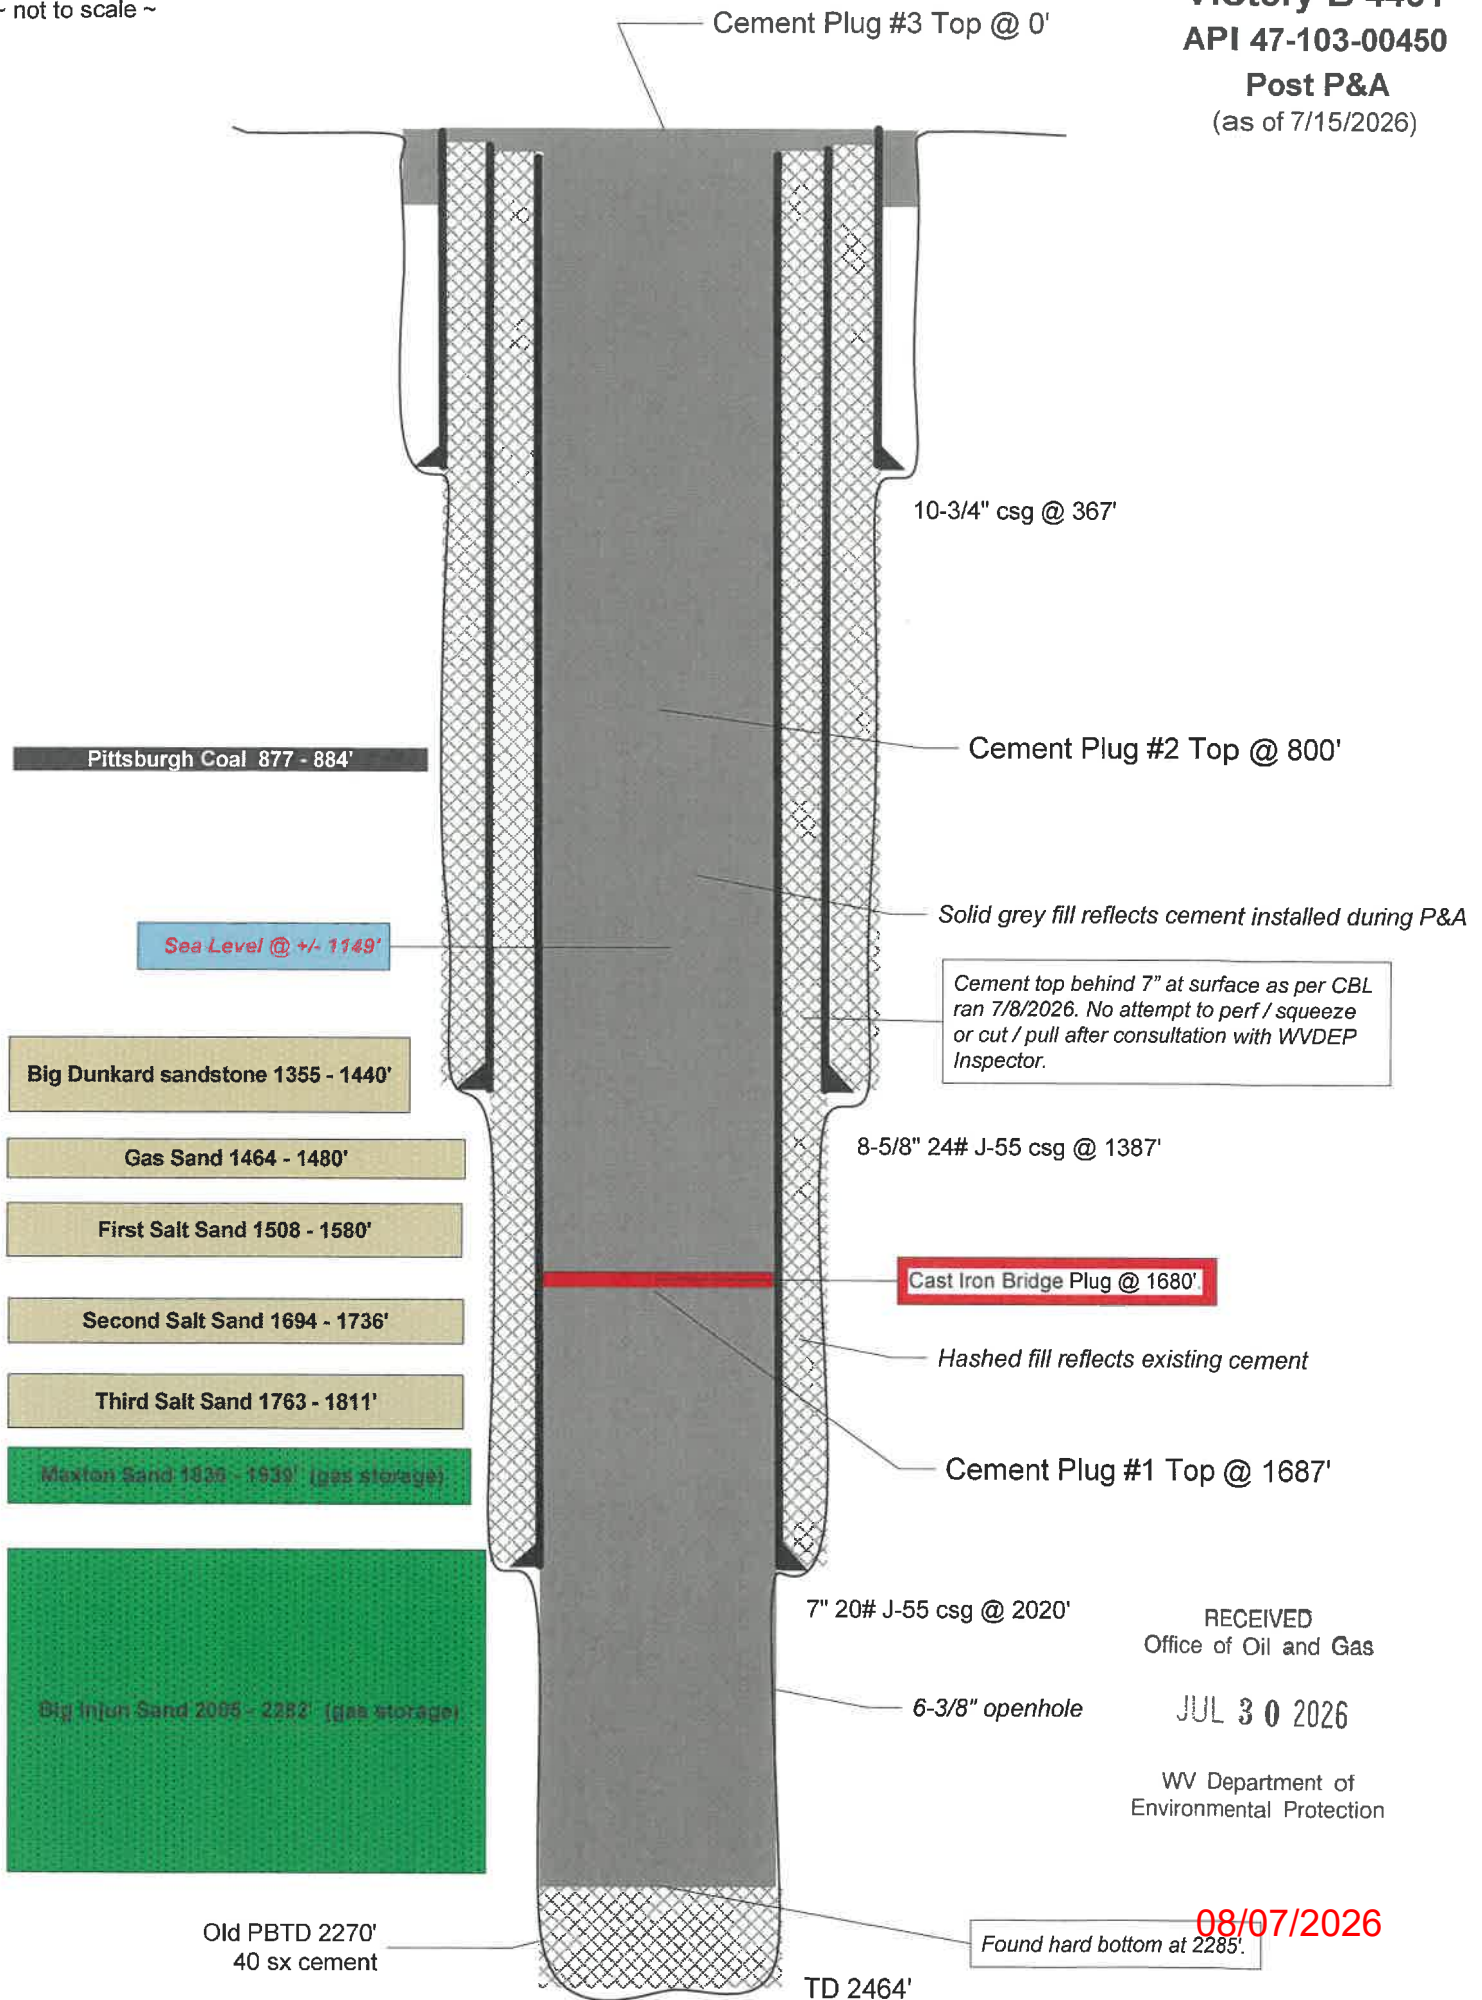

RECEIVED
Office of Oil and Gas


JUL 30 2026

WV Department of
Environmental Protection

08/07/2026

~ not to scale ~

Victory B 4451
API 47-103-00450
Prior to P&A
(as of 2/23/24)

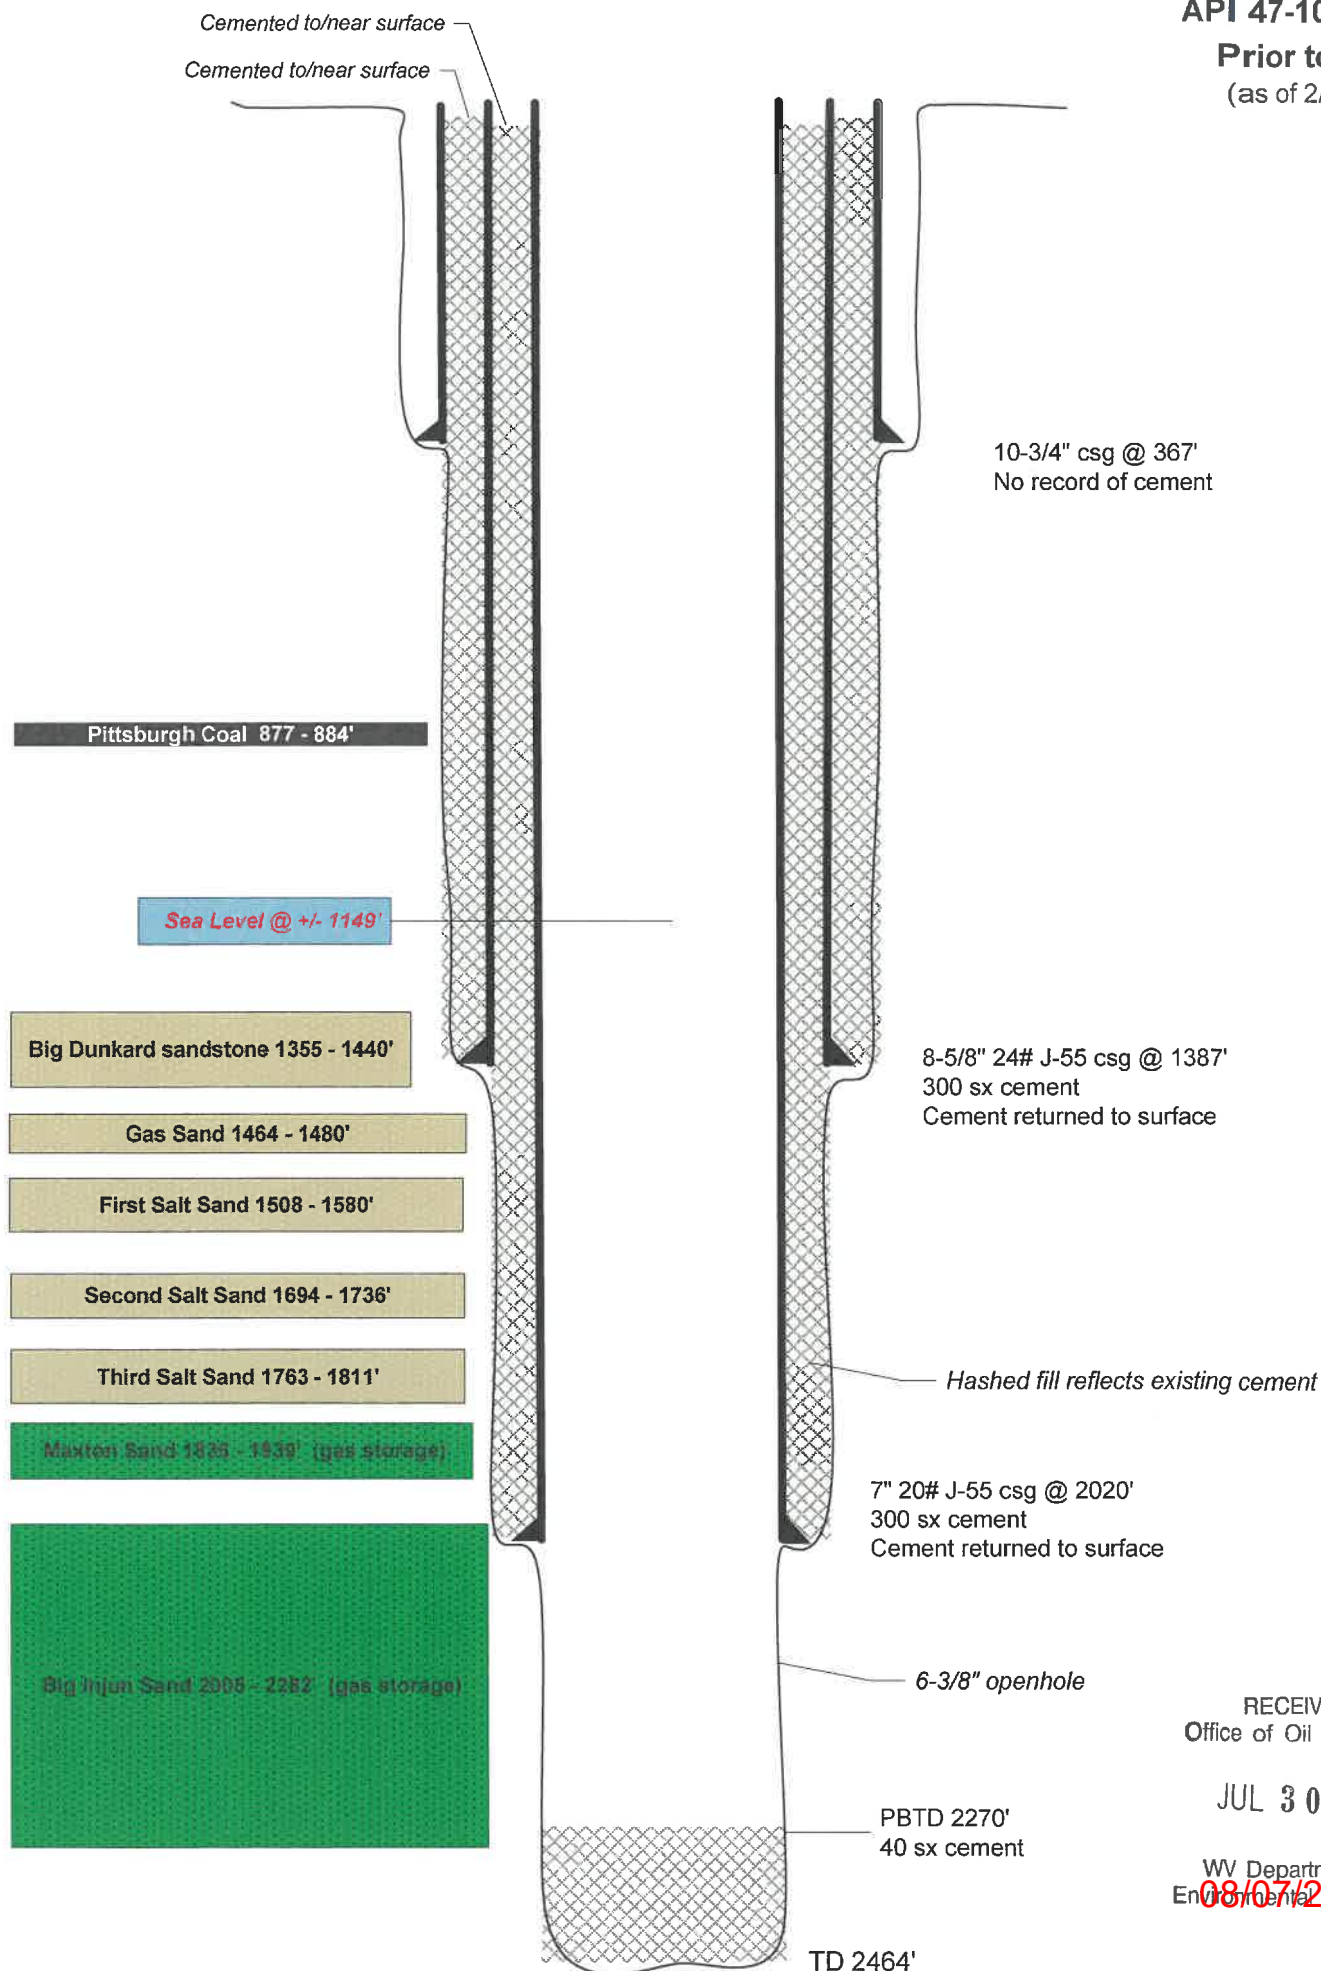

RECEIVED
Office of Oil and Gas

JUL 30 2026

WV Department of
Environmental Protection

08/07/2026