

LATITUDE 39° 30' 00"

80° 35' 00"

LONGITUDE

7'5 OGIS topo location

7.5' loc	<u>1.435</u>	15' loc	_____
	<u>0.09w</u>	(calc.)	_____

Company \_\_\_\_\_

Farm \_\_\_\_\_

Quad Folsom 7 1/2'

County WETZEL

District GRANT

### WELL LOCATION MAP

File No. 103-0679

(100)

SENT TO W.C. 7-9-07  
RETURNED BY


HOPE NATURAL GAS CO. *W.C.*

ORIGINAL

LOCATION FOR WELL No. 987  
Wetzel DISTRICT

On L.G. Robinson Farm, on waters of Shreves River  
Grant District, Wetzel County, West Virginia.

Lease No. 739. Acres 1314. Range N. 3 E. 3 S. W.  
Scale 1" = 800' Made Purchase 7-5-07

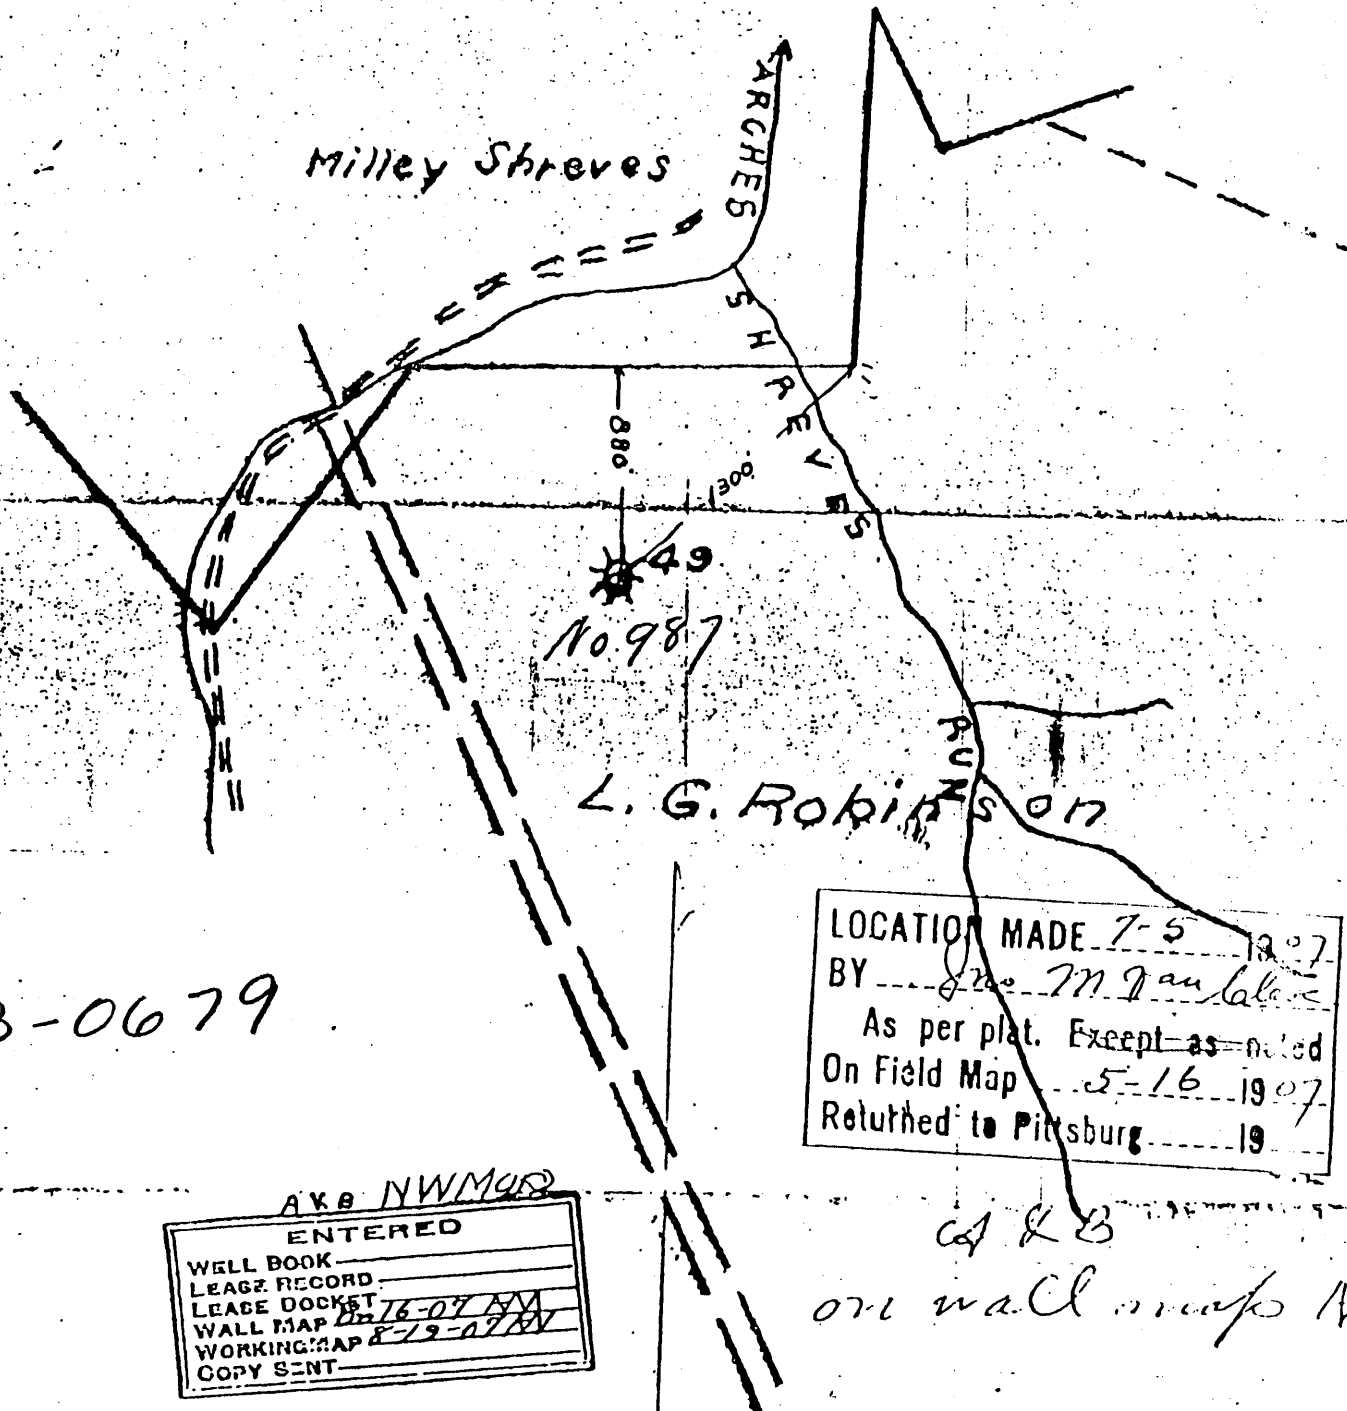

103-0679

LOCATION MADE 7-5-1907  
BY Jno M Paulk  
As per plat. Except as noted  
On Field Map 5-16-1907  
Returned to Pittsburg 19

AKB NWMAS  
ENTERED  
WELL BOOK  
LEASE RECORD  
LEASE DOCKET  
WALL MAP 7-16-07 AM  
WORKING MAP 8-19-07  
COPY SENT

*A & B*  
*on wall map N*

RESERVE: Same lease on which is located well No. 224

SPECIAL INSTRUCTIONS: Purchased from South Run Oil Co July 8, 1907 it has been checked against well L.G. Robinson

# WELL RECORD.

*L. G. Robinson* Farm \_\_\_\_\_ Acres  
*Grant* District *Hetzell* County *W. Va.* State  
 Well No. *987 (49)*  
 Rig Commenced \_\_\_\_\_ 190 \_\_\_\_\_  
 Rig Completed \_\_\_\_\_ 190 \_\_\_\_\_ Contractor.  
 Drilling Commenced *11-14-97* 190 \_\_\_\_\_  
 Drilling Completed *1-3-98* 190 \_\_\_\_\_ Contractor.

ROCK FORMATION.	TOP	BOTTOM.	REMARKS.
<i>Conductor</i>		<i>16</i>	
<i>Pittsburg coal</i>	<i>995</i>		
<i>Big Spring</i>	<i>2355</i>	<i>2115</i>	
<i>1st pay</i>	<i>2410</i>		
<i>3rd pay</i>	<i>3070</i>	<i>3050</i>	<i>Steel line mess,</i>
<i>Stray &amp; Gordon</i>	<i>3108</i>	<i>3122</i>	"
<i>Gas</i>	<i>3114</i>		"
<i>Total depth</i>		<i>3122</i>	"

*Drilled from  
Injun to Gordon  
May 20 - '07  
July 6 - '07*

*Well shot 11-98  
Rise 309 to  
Length shell 6 ft  
Top of shot 2407*

*There was no  
break between  
the Stray and  
Gordon in this  
well. The stray  
was merely a  
shell on top of  
the Gordon sand.*

*W X B*

ENTERED	<i>July 7-22-07</i>
WELL BOOK	<i>✓</i>
LEASE RECORD	<i>✓</i>
LEASE DOCKET	<i>✓</i>
WALL MAP	<i>7-26-07 AM</i>
WORKING MAP	<i>7-24-07 AM</i>
COPY SENT	<i>✓</i>

## CASING RECORD.

Size.	Charged to Well.		Put in Well.		Pulled Out.		Left in Well.		Transferred Before Completion.		Left at Well, Not in Use.	
	Feet.	In.	Feet.	In.	Feet.	In.	Feet.	In.	Feet.	In.	Feet.	In.
<i>10</i>			<i>414</i>		<i>414</i>							
<i>8 1/4</i>			<i>1558</i>		<i>1558</i>							
<i>6 3/8</i>			<i>2300</i>				<i>2300</i>					
<i>5 7/16</i>			<i>2575</i>				<i>2575</i>					

Production First 24 hours } .....

Approved by *G. B. Meredith* Supt.

PROOF—Sum of Three right hand columns equals first or "Charged to Well," use as many sheets as necessary to make a complete record. In making out this record please use copying ink or an indelible pencil.