

39° 40' 00"

Latitude



80° 25' 00"

Longitude

Topo Location

7.5' Loc. 1.195 15' Loc. 1.195
0.55W (calc.) 0.55W

Company Greenridge Oil Co.
Farm Alie Edgell #1
15' Quad Mannington (WC)
(sec.)
7.5' Quad Hundred
District Church

WELL LOCATION PLAT

County 103 Permit 1617N
30945 ?


1) Attach a photo copy of the location of the well on a 7.5 minute Quadrangle with the corresponding longitude and Latitude.
 2) Designate the location of the well with the symbol (+).

Environmental Permitting
 MAR 28 94
 Office of Oil & Gas

2900 39°40'

49° E 89° N

152025

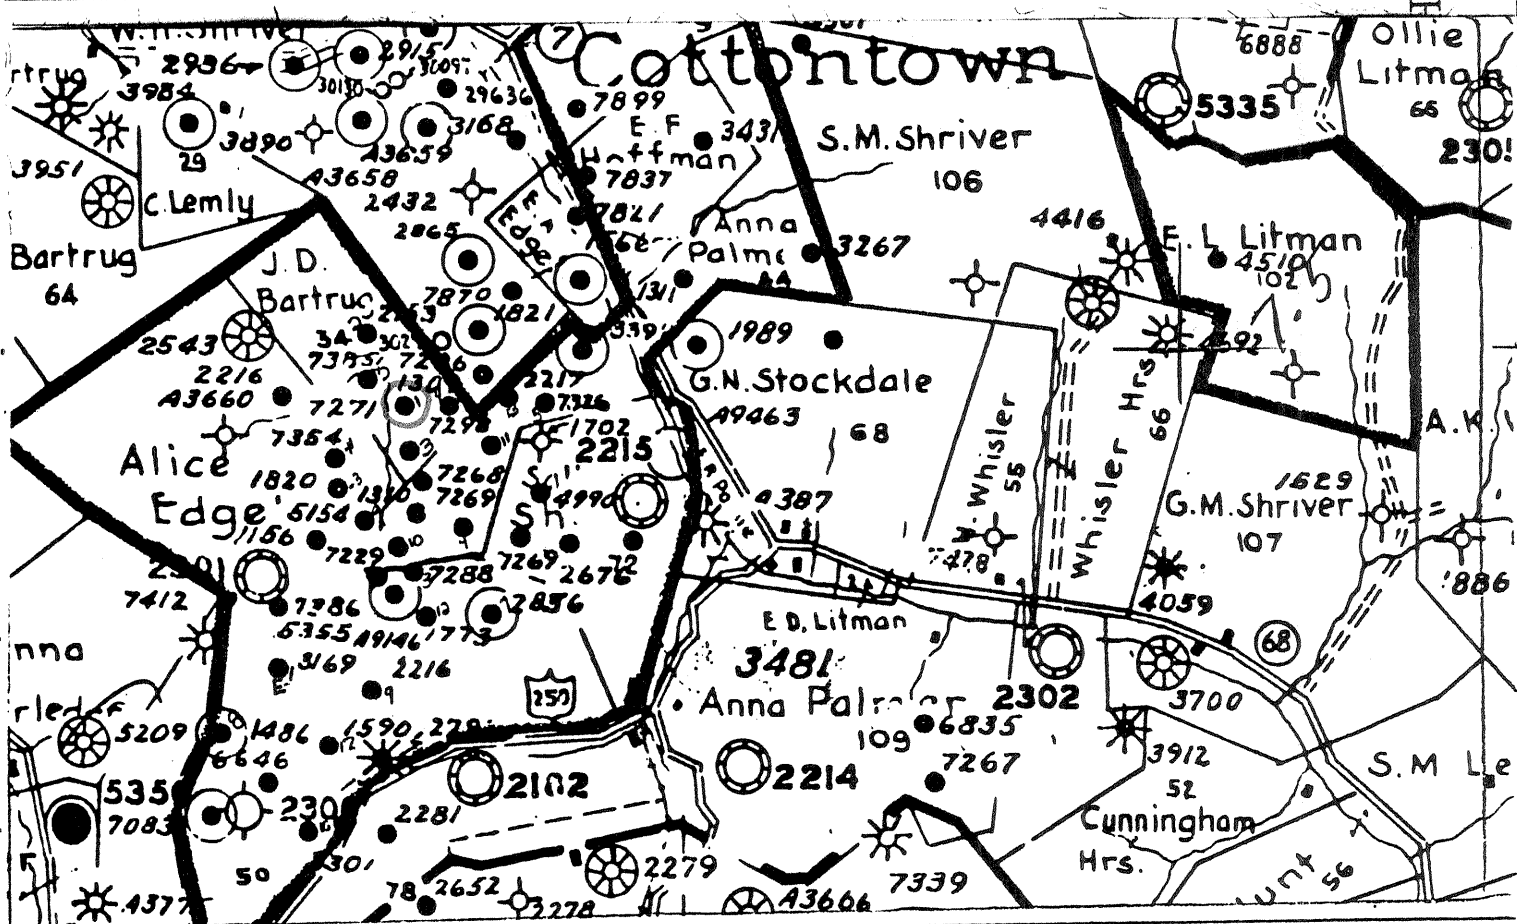

I, the undersigned, hereby certify that this plat is correct to the best of my knowledge and belief.

SIGNED Ralph C. Condon
 TITLE President

Well Name - Alice Edgell # 1

DATE 1/8, 19 93
 OPERATORS WELL NO. 1 (1309?)
 API WELL NO. 103 ~~1617-N~~

RECEIVED

WV Division of Environmental Protection

JAN 26 93

Permitting Office of Oil & Gas

STATE OF WEST VIRGINIA
 DEPARTMENT OF ENERGY
 OIL AND GAS DIVISION

TYPE: OIL GAS LIQUID INJECTION WASTE DISPOSAL
 " AS" PRODUCTION STORAGE DEEP SHALLOW

LOCATION: ELEVATION 1200 WATER SHED Fish Creek
 DISTRICT Church COUNTY Wetzel
 QUADRANGLE ~~271204~~ 271204

SURFACE OWNER Hundred ACREAGE _____
 OIL & GAS ROYALTY OWNER _____ LEASE ACREAGE 200
 LEASE NO. _____

PRODUCING FORMATION Maxton Sand TOTAL DEPTH 2391

WELL OPERATOR Greengate Oil Co. DESIGNATED AGENT John Lavelle

ADDRESS R.D. #1 Box 267 ADDRESS R.D. 1 Box 72

New Freeport, PA 15352 Knob Fork, WV 26579

STATE OF WEST VIRGINIA
DIVISION OF ENVIRONMENTAL PROTECTION
SECTION OF OIL AND GAS

WELL REGISTER ASSIGNMENT

This API Number 47-103-01617, issued to GREENRIDGE OIL, INC. is evidence of permission to operate the well that is referenced at the location described on the attached plat, subject to the provisions of Chapters 22 and 22B of the West Virginia Code of 1931, as amended, and all rules and regulations promulgated thereunder. The name and telephone number of the Oil and Gas Inspector for this well is RANDAL MICK -
304-986-3324.

Spills or emergency discharges must be reported to 1-800-654-3312.

Failure to abide by all statutory and regulatory provisions governing all duties and operations hereunder may result in suspension or revocation of your permits and in addition may result in civil and/or criminal penalties.

The enclosed WR-35 must be completed by you and returned to this office. In addition annual production reports must be submitted on this well and failure to do so may require you to plug the well.

Theodore M. Streit
Chief

By: 

Title: _____

Operator's Well No: 1

Farm Name: EDGELL, ALICE

API Well Number : 47-103-01617 N

Date Issued : 05/02/94