

39° 40' 00"

Latitude ✓

80° 25' 00"

Longitude

Topo Location

7.5' Loc. 1.00S 15' Loc. 1.00S
0.43W (calc.) 0.43W

Company Greenridge Oil Co.
Farm Shay #13
15' Quad Mannington (wc)
(sec.)
7.5' Quad Hundred
District Church

WELL LOCATION PLAT

County 103 Permit 16274/N

13 ?

1) Attach a photo copy of the location of the well on a 7.5 minute Quadrangle with the corresponding longitude and Latitude.

2) Designate the location of the well with the symbol(+).


RECEIVED WV Division of Environmental Protection

MAR 28 94 Permitting Office of Oil & Gas

2300'

39° 40'

80° 25'

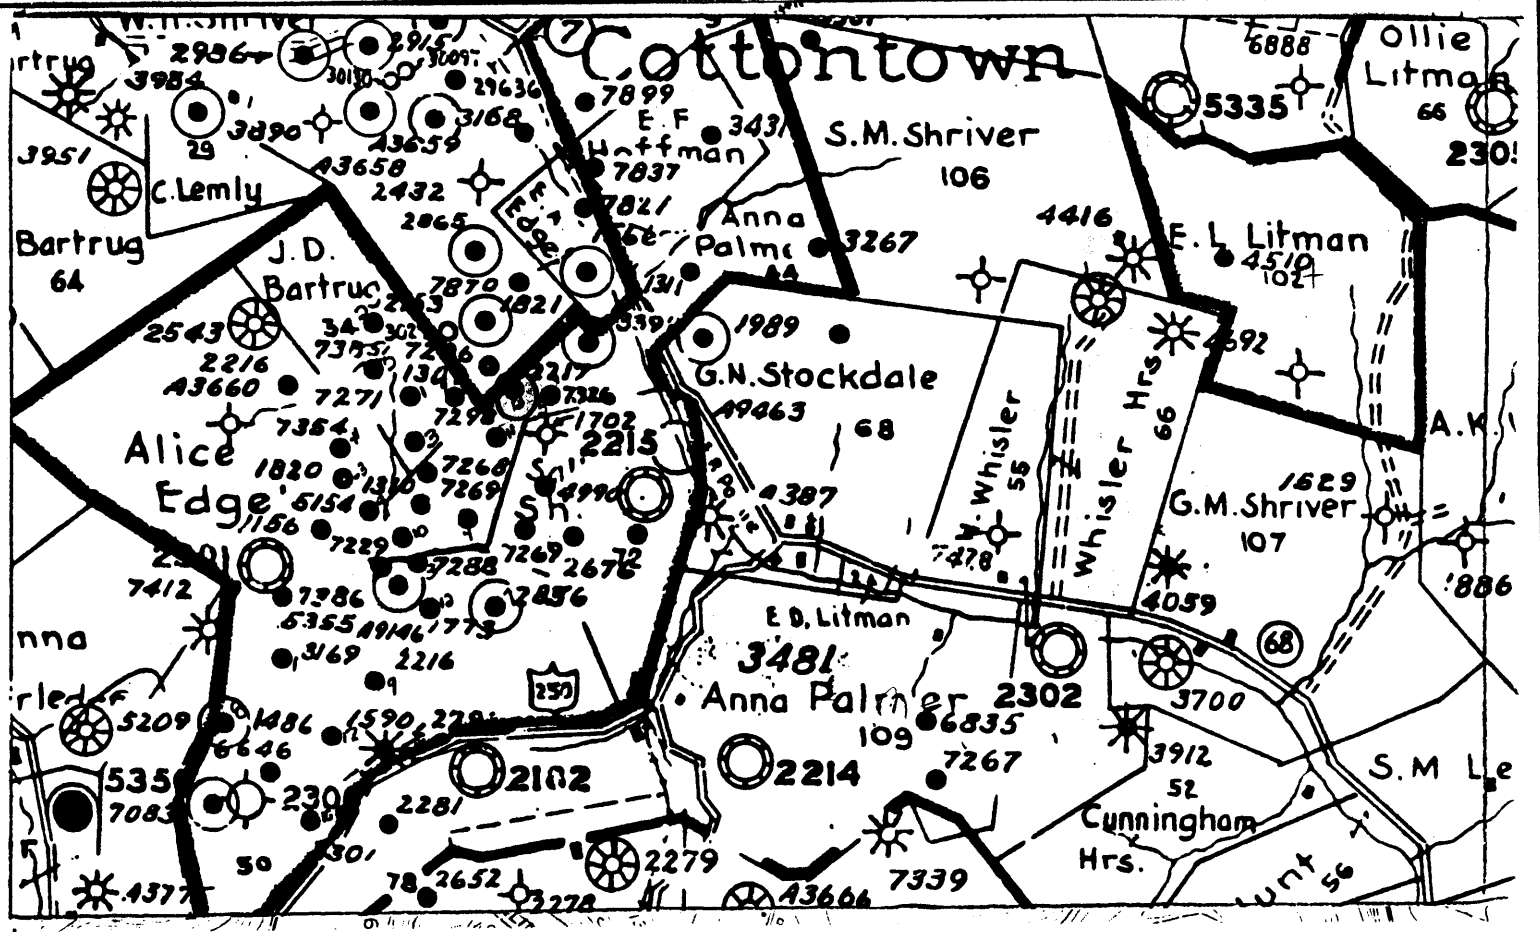

I, the undersigned, hereby certify that this plat is correct to the best of my knowledge and belief.

RECEIVED WV Division of Environmental Protection

SIGNED Ralph O. Conklin
TITLE President

Well NAME - Shay # 13

JUN 26 93 Permitting Office of Oil & Gas

DATE 1-8, 1993
OPERATORS WELL NO. 13 (2217)
API WELL NO. 103-1624-N

STATE OF WEST VIRGINIA
DEPARTMENT OF ENERGY
OIL AND GAS DIVISION

TYPE: OIL GAS LIQUID INJECTION WASTE DISPOSAL
AS" PRODUCTION STORAGE DEEP SHALLOW

LOCATION: ELEVATION 1200 WATER SHED Fish Creek
DISTRICT Church COUNTY Wetzel
QUADRANGLE 37° 30' x 40'

SURFACE OWNER Hundred ACREAGE _____
OIL & GAS ROYALTY OWNER _____ LEASE ACREAGE 75
LEASE NO. _____

PRODUCING FORMATION Maxton Sand #970 TOTAL DEPTH 2409
WELL OPERATOR Greeneidge oil Co DESIGNATED AGENT John Lavelle
ADDRESS R.D.#1 Box 267 ADDRESS RD 1 Box 72
New Freeport, PA. 15352 Knob Fork, WV 26579

18939

STATE OF WEST VIRGINIA
DIVISION OF ENVIRONMENTAL PROTECTION
SECTION OF OIL AND GAS

WELL REGISTER ASSIGNMENT

This API Number 47-103-01624, issued to GREENRIDGE OIL, INC. is evidence of permission to operate the well that is referenced at the location described on the attached plat, subject to the provisions of Chapters 22 and 22B of the West Virginia Code of 1931, as amended, and all rules and regulations promulgated thereunder. The name and telephone number of the Oil and Gas Inspector for this well is RANDAL MICK -
304-986-3324.

Spills or emergency discharges must be reported to 1-800-654-3312.

Failure to abide by all statutory and regulatory provisions governing all duties and operations hereunder may result in suspension or revocation of your permits and in addition may result in civil and/or criminal penalties.

The enclosed WR-35 must be completed by you and returned to this office. In addition annual production reports must be submitted on this well and failure to do so may require you to plug the well.

Theodore M. Streit
Chief

By:  _____

Title: _____

Operator's Well No: 13

Farm Name: SHAY

API Well Number : 47-103-01624 N

Date Issued : 05/02/94