

LATITUDE 39-37-30

SCALED COOR:

7,115' SOUTH
3,120' WEST

LONGITUDE 80-32-30

LONGITUDE 80-32-30

NORTH

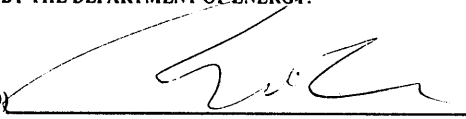
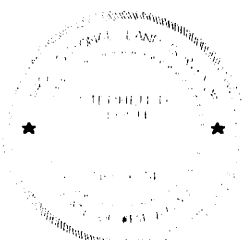
WELL REFERENCES:

S42-00W, 116.50' TO 8" PERSIMMON
S71-00W, 154.50' TO 7" RED MAPLE

NAD 27 WV NORTH SPC:

E-243 = 404,337.45'
1,703,470.36'

(+) DENOTES LOCATION OF WELL ON UNITED STATES TOPOGRAPHIC MAPS

<p>FILE NUMBER: _____ DRAWING NUMBER: <u>EXCEASLEY1.PCS</u> SCALE: <u>1" = 400'</u> MINIMUM DEGREE OF ACCURACY: <u>1 IN 200</u> PROVEN SOURCE OF ELEVATION: <u>DGPS SURVEY 11/29/00</u> <u>SUBMETER SYSTEM</u></p>	<p>I THE UNDERSIGNED, HEREBY CERTIFY THAT THIS PLAT IS CORRECT TO THE BEST OF MY KNOWLEDGE AND BELIEF AND SHOWS ALL THE INFORMATION REQUIRED BY LAW AND THE REGULATIONS ISSUED AND PRESCRIBED BY THE DEPARTMENT OF ENERGY.</p> <p>(SIGNED)  STEPHEN D. LOSH, P.S. #674</p>	<p>PLACE SEAL HERE</p> 
---	---	--

<p>STATE OF WEST VIRGINIA DIVISION OF ENVIRONMENTAL PROTECTION FORM WW-6 OFFICE OF OIL AND GAS #10 McJUNKIN ROAD NITRO, WV 25143-2506</p>	<p>LAND SURVEYING SERVICES 21 CEDAR LANE, BRIDGEPORT, WV 26330 PHONE: 304-842-2018 OR 842-5762</p>	<p>DATE: <u>NOVEMBER 29, 2000</u> OPERATORS WELL NO.: <u>E-243</u> API WELL NO. <u>47 - 103 - 01820</u> STATE COUNTY PERMIT</p>
<p>WELL TYPE: OIL ___ GAS <u>X</u> LIQUID INJECTION ___ WASTE DISPOSAL ___ (IF "GAS") PRODUCTION <u>X</u> STORAGE ___ DEEP ___ SHALLOW <u>X</u> LOCATION: ELEVATION <u>1,430.87'</u> WATERSHED <u>ROCKCAMP RUN</u> DISTRICT <u>GRANT</u> COUNTY <u>WETZEL</u> QUADRANGLE <u>BIG RUN</u> LEASE NUMBER _____</p>		
<p>SURFACE OWNER <u>EARL STONEKING</u> ACREAGE <u>45.50</u> OIL & GAS ROYALTY OWNER <u>ROXIE H. EASLEY & HERBERT K. BAER</u> LEASE ACREAGE <u>46</u></p>		
<p>PROPOSED WORK: DRILL <u>X</u> CONVERT ___ DRILL DEEPER ___ REDRILL ___ FRACTURE OR STIMULATE ___ PLUG OFF OLD FORMATION ___ PERFORATE NEW FORMATION ___ OTHER PHYSICAL CHANGE (SPECIFY) _____ TARGET FORMATION <u>BAYARD</u> ESTIMATED DEPTH <u>3,760'</u> WELL OPERATOR <u>EXCEL ENERGY, INC.</u> DESIGNATED AGENT <u>HARRY BARNETT</u> ADDRESS <u>P. O. BOX 1020 BRIDGEPORT, WV 26330</u> ADDRESS <u>P. O. BOX 1020 BRIDGEPORT, WV 26330</u></p>		

COUNTY NAME PERMIT 1820

FEB 23 2001