

WW-7
8-30-06



West Virginia Department of Environmental Protection
Office of Oil and Gas
WELL LOCATION FORM: GPS

API: 47-103-02257 WELL NO.: WV 518475 (J. B. Dewhurst #50)

FARM NAME: J. B. Dewhurst

RESPONSIBLE PARTY NAME: EQT Production Company

COUNTY: Wetzel DISTRICT: Grant

QUADRANGLE: Center Point 7.5'

SURFACE OWNER: West Virginia Department of Natural Resources

ROYALTY OWNER: John W. Kerns Heirs Trust, et al.

UTM GPS NORTHING: 4369417

UTM GPS EASTING: 532253 GPS ELEVATION: 284 m (933 ft)

The Responsible Party named above has chosen to submit GPS coordinates in lieu of preparing a new well location plat for a plugging permit or assigned API number on the above well. The Office of Oil and Gas will not accept GPS coordinates that do not meet the following requirements:

1. Datum: NAD 1983, Zone: 17 North, Coordinate Units: meters, Altitude: height above mean sea level (MSL) – meters.
2. Accuracy to Datum – 3.05 meters
3. Data Collection Method:

Survey grade GPS _____ : Post Processed Differential _____
Real-Time Differential _____

Mapping Grade GPS X : Post Processed Differential X
Real-Time Differential _____

4. **Letter size copy of the topography map showing the well location.**

I the undersigned, hereby certify this data is correct to the best of my knowledge and belief and shows all the information required by law and the regulations issued and prescribed by the Office of Oil and Gas.


Signature

PS# 2180
Title

7/27/18
Date

RECEIVED
Office of Oil and Gas

SEP 26 2018

West Virginia Department of
Environmental Protection


47-103-02257P

11/09/2018

T	Center Point 7.5	S	1" = 2000'	Office of Oil and Gas
C	Wetzel	D	July 27, 2018	SEP 26 2018
D	Grant	Pr	40-34-00-09	WV Department of Environmental Protection

47-103-02257 WV 518475 (J. B. Dewhurst #50)

To

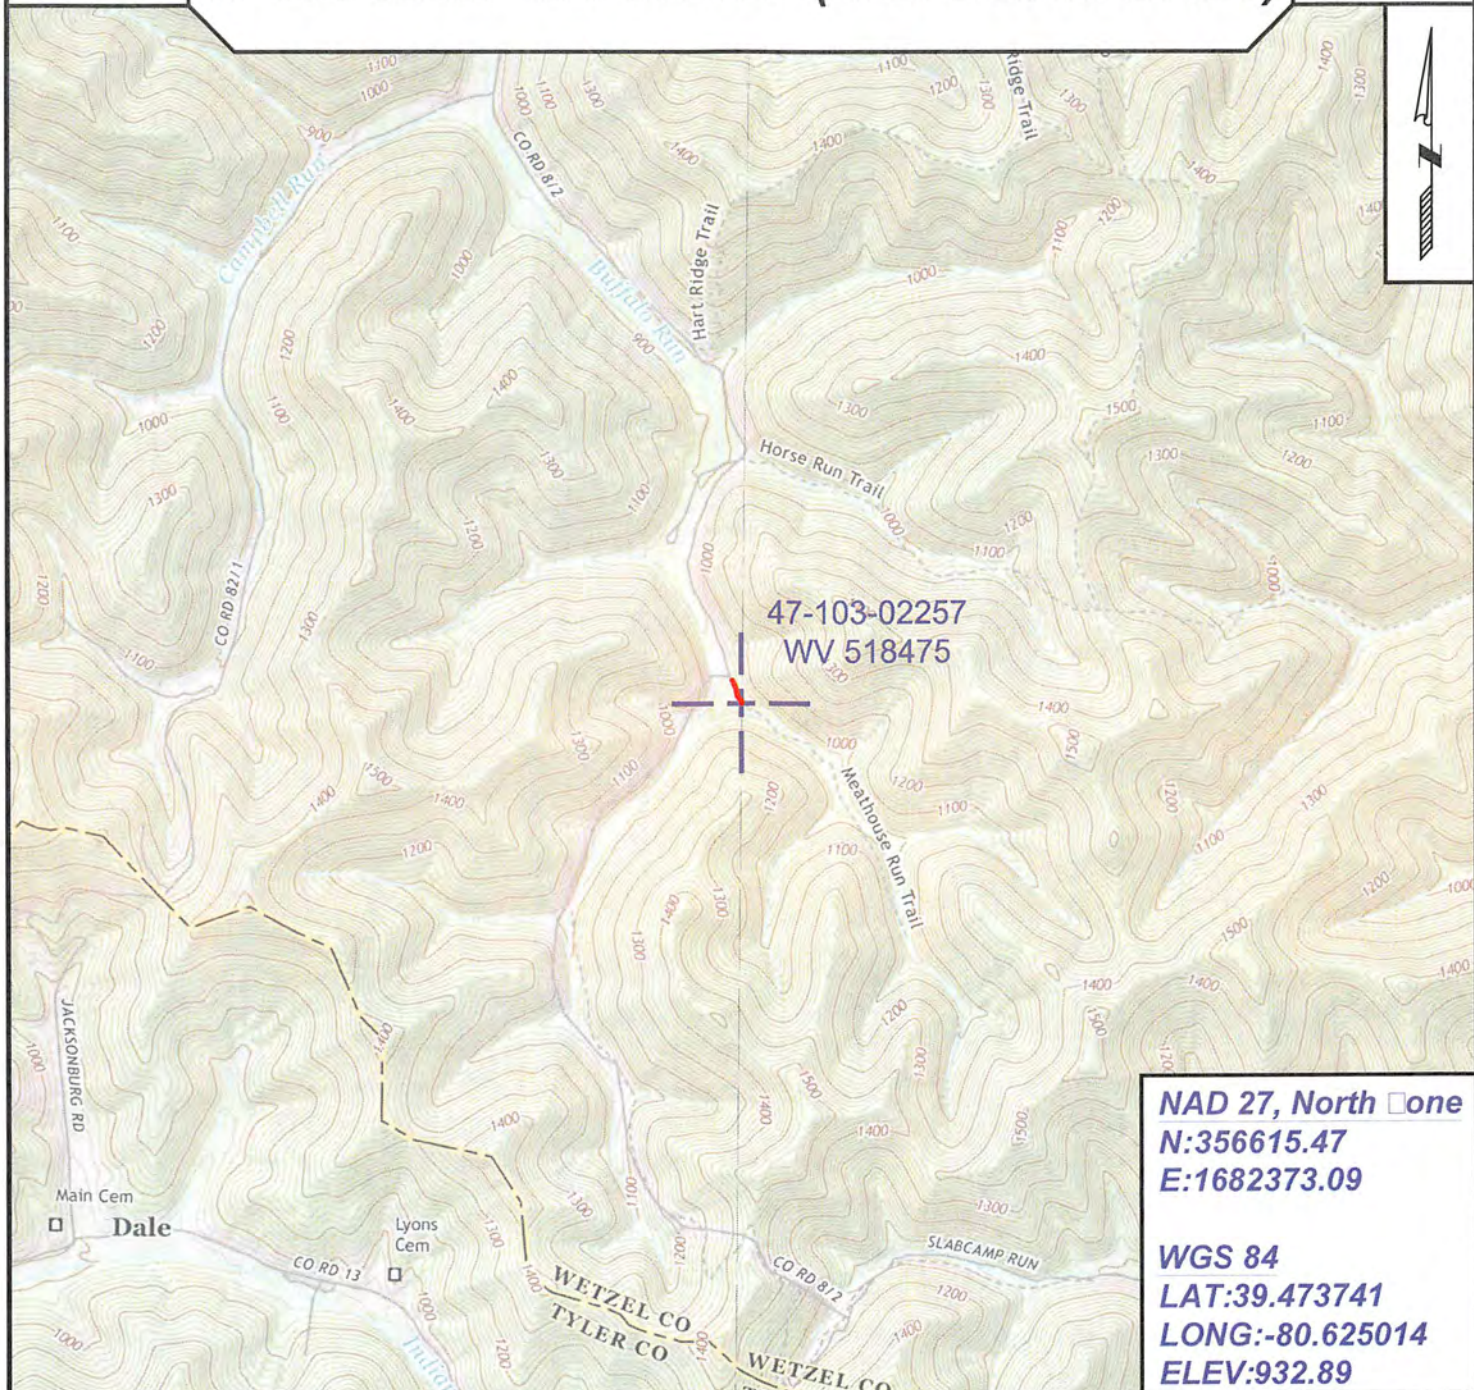

NAD 27, North one
N:356615.47
E:1682373.09

WGS 84
LAT:39.473741
LONG:-80.625014
ELEV:932.89



SURVEYING AND MAPPING SERVICES PERFORMED BY:
ALLEGHENY SURVEYS, INC.
 1-800-482-8606
 237 Birch River Road
 Birch River, WV 26610
 PH: (304) 649-8606
 FAX: (304) 649-8608

PREPARED FOR:
EQT Production Company
 2400 Ansys Drive
 Canonsburg, PA 15317