

WW-7
8-30-06



RECEIVED
Office of Oil and Gas

SEP 26 2018

WV Department of
Environmental Protection

West Virginia Department of Environmental Protection
Office of Oil and Gas
WELL LOCATION FORM: GPS

API: 47-103-02286 WELL NO.: WV 518476 (J. B. Dewhurst #73)

FARM NAME: J. B. Dewhurst

RESPONSIBLE PARTY NAME: EQT Production Company

COUNTY: Wetzel DISTRICT: Grant

QUADRANGLE: Folsom 7.5'

SURFACE OWNER: West Virginia Department of Natural Resources

ROYALTY OWNER: John W. Kerns Heirs Trust, et al.

UTM GPS NORTHING: 4369956

UTM GPS EASTING: 534856 GPS ELEVATION: 269 m (884 ft)

The Responsible Party named above has chosen to submit GPS coordinates in lieu of preparing a new well location plat for a plugging permit or assigned API number on the above well. The Office of Oil and Gas will not accept GPS coordinates that do not meet the following requirements:

1. Datum: NAD 1983, Zone: 17 North, Coordinate Units: meters, Altitude: height above mean sea level (MSL) – meters.
2. Accuracy to Datum – 3.05 meters
3. Data Collection Method:

Survey grade GPS _____: Post Processed Differential _____
 Real-Time Differential _____
 Mapping Grade GPS X: Post Processed Differential X
 Real-Time Differential _____

4. Letter size copy of the topography map showing the well location.

I the undersigned, hereby certify this data is correct to the best of my knowledge and belief and shows all the information required by law and the regulations issued and prescribed by the Office of Oil and Gas.

[Signature]
Signature

PS # 2180
Title

7/27/18
Date

47-103-02286P

11/09/2018

Topo Quad: Folsom 7.5'

Scale: 1" = 2000'

Office of Oil and Gas

County: Wetzel

Date: July 27, 2018

SEP 26 2018


District: Grant

Project No: 40-34-00-09

WV Department of Environmental Protection

47-103-02286 WV 518476 (J. B. Dewhurst #73)

Topo

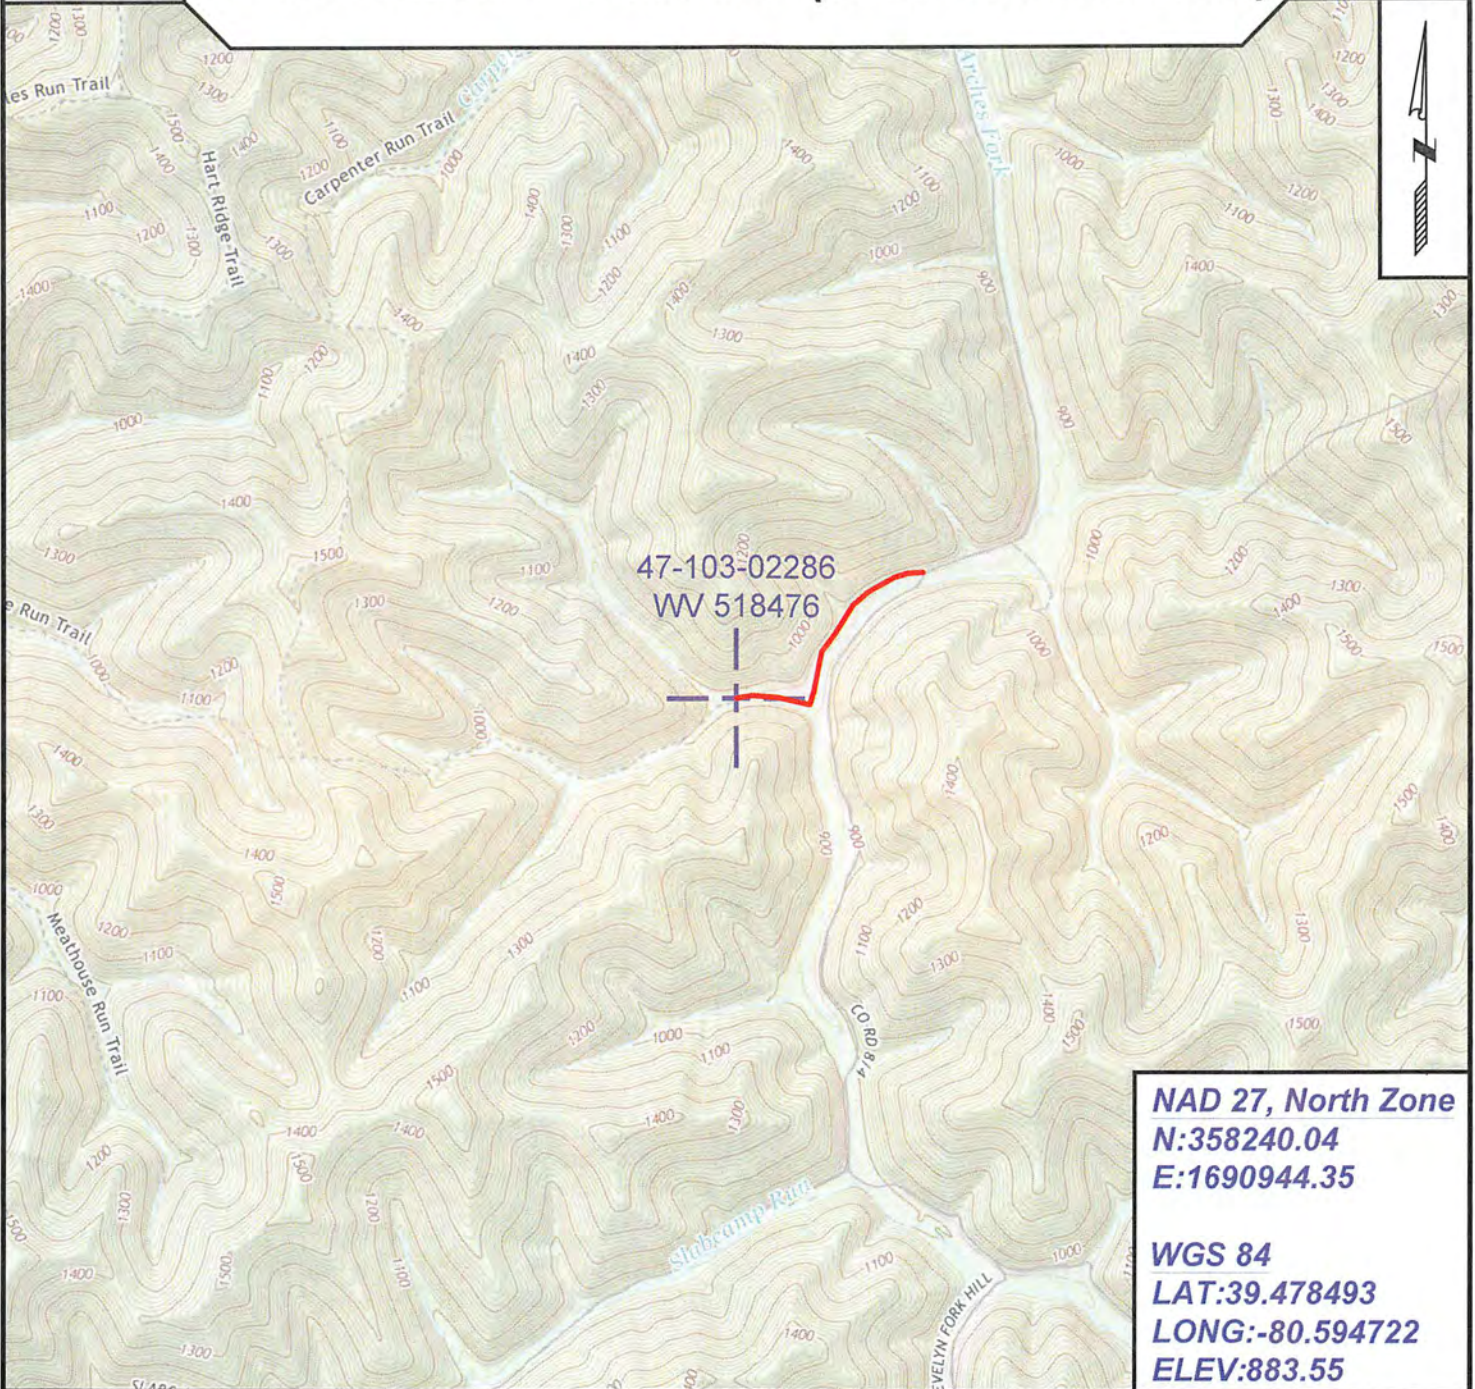

NAD 27, North Zone
N:358240.04
E:1690944.35

WGS 84
LAT:39.478493
LONG:-80.594722
ELEV:883.55



SURVEYING AND MAPPING SERVICES PERFORMED BY:

ALLEGHENY SURVEYS, INC.

1-800-482-8606
 237 Birch River Road
 Birch River, WV 26610
 PH: (304) 649-8606
 FAX: (304) 649-8608

PREPARED FOR:

EQT Production Company

2400 Ansys Drive,
 Canonsburg, PA 15317