

39° 30' 00"

Latitude

Longitude

80° 30' 00"

+ 2.47s
.74w

Topo Location

7.5' Loc. _____ 15' Loc. _____
_____ (calc.) _____

Company South Penn Oil Co

Farm GENINE ROBINSON #20

15' Quad _____
(sec.)

7.5' Quad Folsom


District GRANT

WELL LOCATION PLAT

County 103 Permit 30075

30075

GRANT

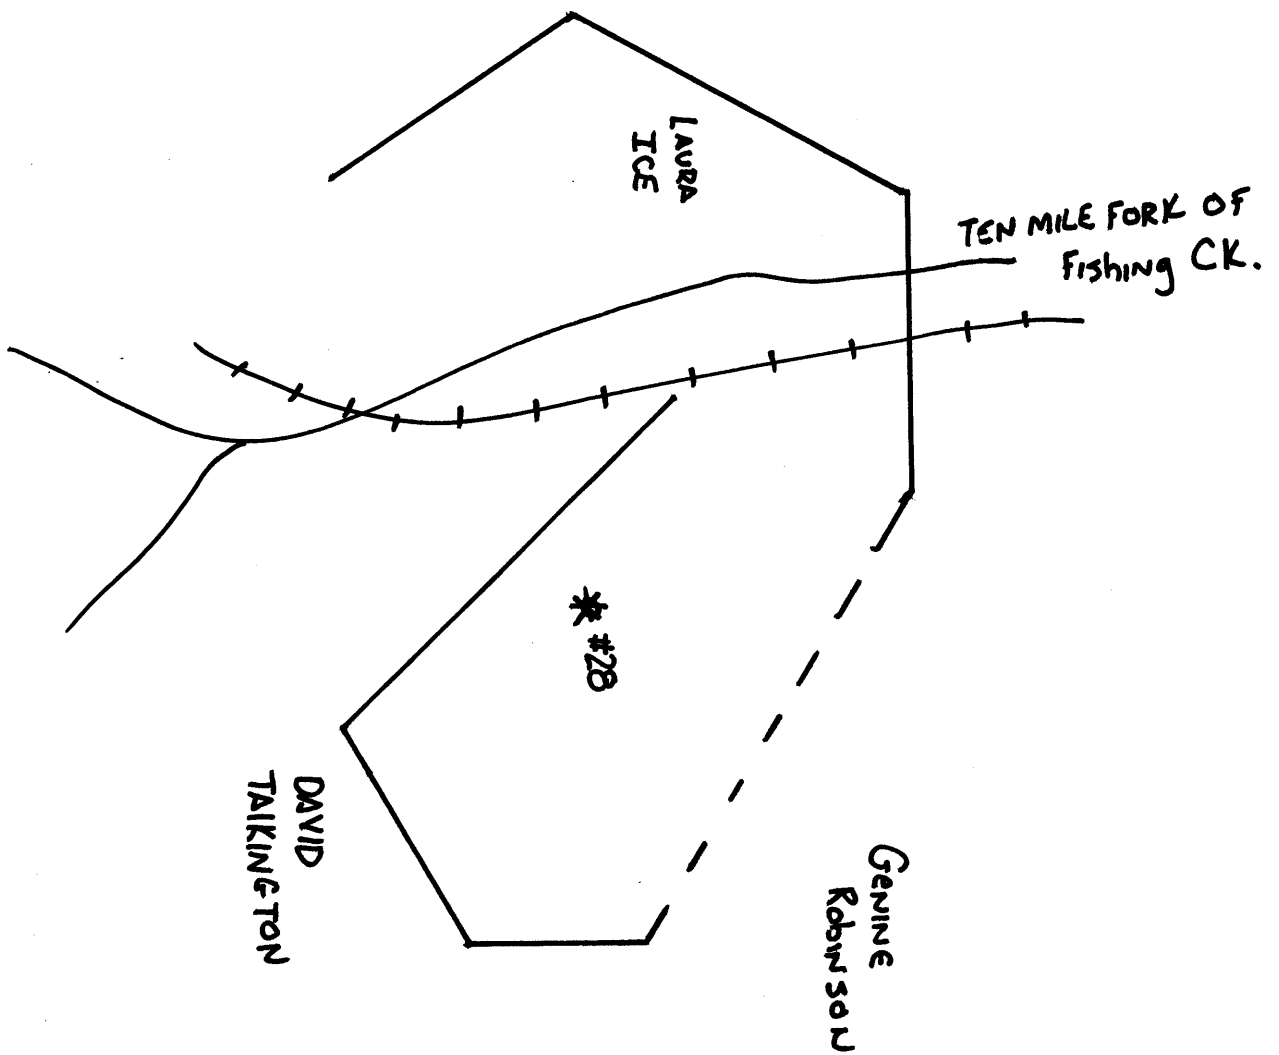

Grant District, Wetzel County, W. Va.
 By South Penn Oil Co., Drawer 1255, Pittsburgh, Pa.
 On 2600 acres, surface and minerals owned by Robinson Improvement Co.,
 B. R. Lewis, The Plains, Virginia.

Elevation, 1225' L.

18' conductor; 10" casing, 327' (pulled); 8 $\frac{1}{4}$ " 1557' (pulled);
 6-5/8", 2409'.

Coal was encountered at 1093-1101'.

Abandonment reported to Dept. of Mines Jan 23, 1932.

Well was shot in Gordon and Stray.

No water.

Oil well.

	Top.	Bottom.
Conductor	0	18
Pittsburgh Coal	1093	1101
Dunkard Sand	1557	1569
Salt Sand	1851	2094
Big Lime	2262	2365
Big Injun Sand	2365	2475
50-Ft. Sand	2922	2947
30-Ft. Sand	3007	3044
Stray Sand (oil, 3146')	3106	3171
Gordon Sand (oil, 3190')	3183	3201
Total depth		3203