

Latitude

Longitude

1425
81w

Topo Location

7.5' Loc. _____ 15' Loc. _____
(calc.) _____

Company Manufac Lt + Ht

Farm SS Main #1715


15' Quad _____
(sec.)

7.5' Quad Littleton

District Church

WELL LOCATION PLAT

County 103 Permit 30093

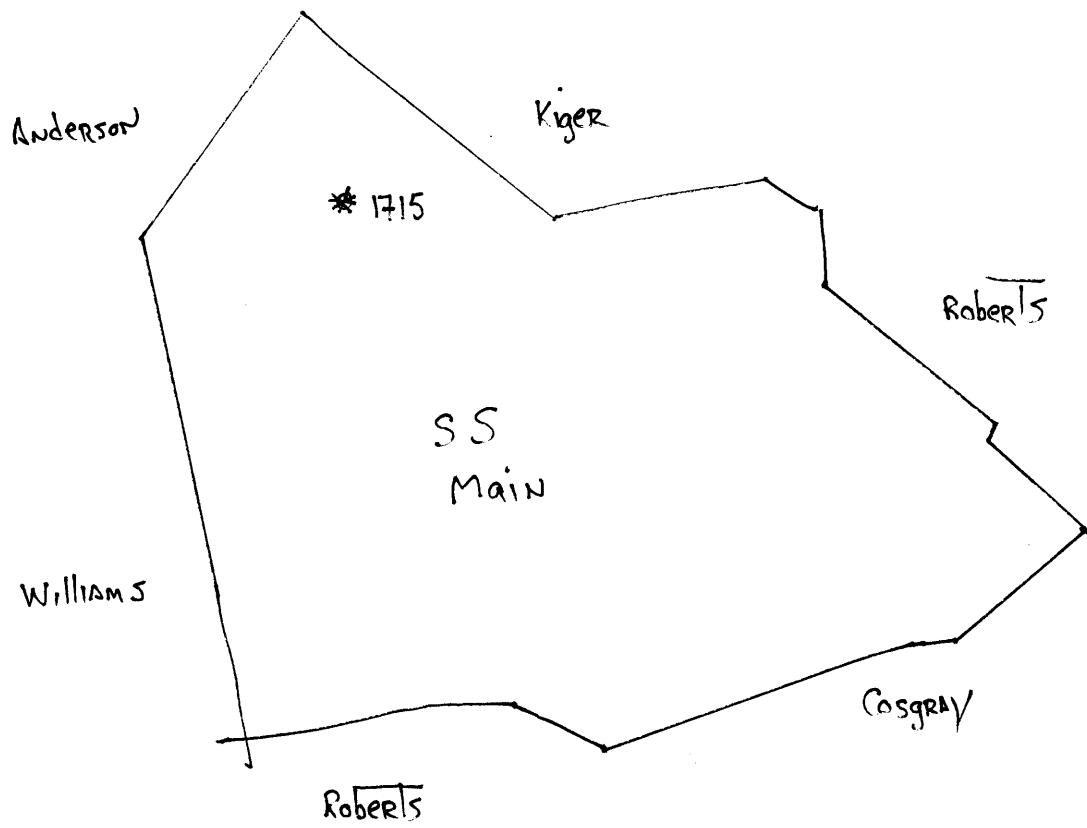

WET-93-A

Church District, Wetzel County, W. Va.

By The Manufacturers Light & Heat Co., 800 Union Trust Bldg.,
Pittsburgh, Pa.On 51 acres, surface owned by S. S. Main, Bank of Hundred,
Hundred, W. Va., and mineral rights by ML&N Co., Pgh., Pa.

Drilled prior to June 1, 1929.

Elevation, 1397' L.

10" casing, 256'; 8 $\frac{1}{2}$ ", 1540'; 6-5/8", 2316'.

Coal was encountered at 1095-1103'.

Abandonment reported to Dept. of Mines Sept. 2, 1932.

Gas well.

| | Top. | Bottom. | Thickness. |
|------------------------------------|------|---------|------------|
| Pittsburgh Coal | 1095 | - 1103 | 8 |
| Little Dunkard Sand | 1440 | - 1470 | 30 |
| Big Dunkard Sand (show of oil) | 1585 | - 1615 | 30 |
| 1st Salt Sand | 1840 | - 1935 | 95 |
| Slate | 1935 | - 2035 | 100 |
| 2nd Salt Sand (gas, 2037') | 2035 | - 2150 | 115 |
| Little Lime | 2220 | - 2265 | 45 |
| Pencil Cave | 2265 | - 2280 | 15 |
| Big Lime | 2280 | - 2350 | 70 |
| Big Injun Sand (break, 2450-2458') | 2350 | - 2600 | 250 |
| Gants Sand | 2920 | - 2927 | 7 |
| 30-Ft. Sand | 3040 | - 3045 | 5 |
| Gordon Stray Sand | 3117 | - 3122 | 5 |
| Gordon Sand (show of oil, 3213') | 3175 | - 3228 | 53 |
| 4th Sand (gas, 3264') | 3256 | - 3270 | 14 |
| 5th Sand | 3313 | - 3338 | 25 |
| Total depth | | 3457 | |