

Surface: Sarah Newman
 New Martinsville, W.Va.
 Coal: State of West Virginia

New Location _____
 Drill Deeper _____
 Abandonment

✓ JUL 30 1940

1.06 ~~1.18~~ W
 5.52 ~~5.6~~ Q

Company South Penn Natural Gas Co.
 Address Parkersburg West Va.
 Farm Sarah Newman
 Tract _____ Acres 250 Lease No. 14919
 Well (Farm) No. 1 Serial No. _____
 Elevation (Spirit Level) 1392.22
 Quadrangle Littleton
 County Wetzel District Clay
 Engineer E.C. Tabler
 Engineer's Registration No. _____
 File No. _____ Drawing No. _____
 Date May 4 1940 Scale 1" = 800'

STATE OF WEST VIRGINIA
 DEPARTMENT OF MINES
 OIL AND GAS DIVISION
 CHARLESTON

WELL LOCATION MAP
 FILE NO. WET-334 A

+ Denotes location of well on United States Topographic Maps, scale 1 to 62,500, latitude and longitude lines being represented by border lines as shown.
 - Denotes one inch spaces on border line of original tracing.

STATE OF WEST VIRGINIA
DEPARTMENT OF MINES
OIL AND GAS DIVISION

804

WELL RECORD

Permit No. **334-A**

Oil or Gas Well **OIL-GAS**
(KIND)

Company **South Penn Natural Gas Company**
 Address **Union Trust Bldg. Parkersburg, W. Va.**
 Farm **Sarah Newman** Acres **250**
 Location (waters) **Long Draw & Sugar Run**
 Well No. **1** Elev. **1392.22'**
 District **Clay** County **Wetzel**
 The surface of tract is owned in fee by **Sarah Newman**
New Martinsville Address **W. Va.**
 Mineral rights are owned by **J. W. Newman**
New Martinsville Address **W. Va.**
 Drilling commenced **March 22, 1900 D.D. ?**
 Drilling completed **April 23, 1900 D.D. Mar. 17, 1905**
 Date shot **See Below** Depth of shot **--**
 Open Flow /10ths Water in **--** Inch
 /10ths Merc. in **--** Inch
 Volume **-- ?** Cu. Ft.
 Rock Pressure **--** lbs. **--** hrs.
 Oil **?** bbls., 1st 24 hrs.
 Fresh water **--** feet **--** feet
 Salt water **2090** feet **--** feet


Casing and Tubing	Used in Drilling	Left in Well	Packers
Size			Kind of Packer
16			
13			
10	300' 2"		Size of
8 1/4	1545' 4"		
6 5/8	2351'		Depth set
5 3/16			
3			Perf. top
			Perf. bottom
Liners Used			Perf. top
Cond.	14'		Perf. bottom

CASING CEMENTED **--** SIZE **--** No. Ft. **--** Date **--**
 COAL WAS ENCOUNTERED AT **1108** FEET **72** INCHES
-- FEET **--** INCHES **--** FEET **--** INCHES
-- FEET **--** INCHES **--** FEET **--** INCHES

Formation	Color	Hard or Soft	Top	Bottom	Oil, Gas or Water	Depth Found	Remarks
Pittsburgh Coal			1108	1114			
Red Rock			1164	1522			
Dunkard Sand			1595	1640			
Gas Sand			1854	1900	Gas	1864	
Salt Sand			1975	2122	Gas	2065	
Lime			2220		Water	2090	
Pencil Cave			2310				
Big Lime			2312	2362			
Stray Sand			2362	2375			
Big Injun Sand			2375	2584	Gas	2385-2395	Strong
DRILLED DEEPER:							
Hole reduced			2580				
Stray			3140		Oil	3216	
Total Depth:				3240			

SHOT RECORD.

Oct. 14, 1905 20 ft.
 Nov. 22, 1905 40 "
 June 6, 1918 60 "
 Dec. 16, 1919 80 " **Stray**

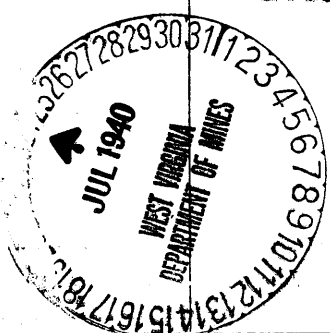

Formation	Color	Hard or Soft	Top	Bottom	Oil, Gas or Water	Depth Found	Remarks

Date **July 25,** 194 **0**

APPROVED **SOUTH PENN NATURAL GAS COMPANY**, Owner

By *Elton E. [Signature]* Land Agent
(Title)