


0 1 2 3 + + Latitude 39° 40'

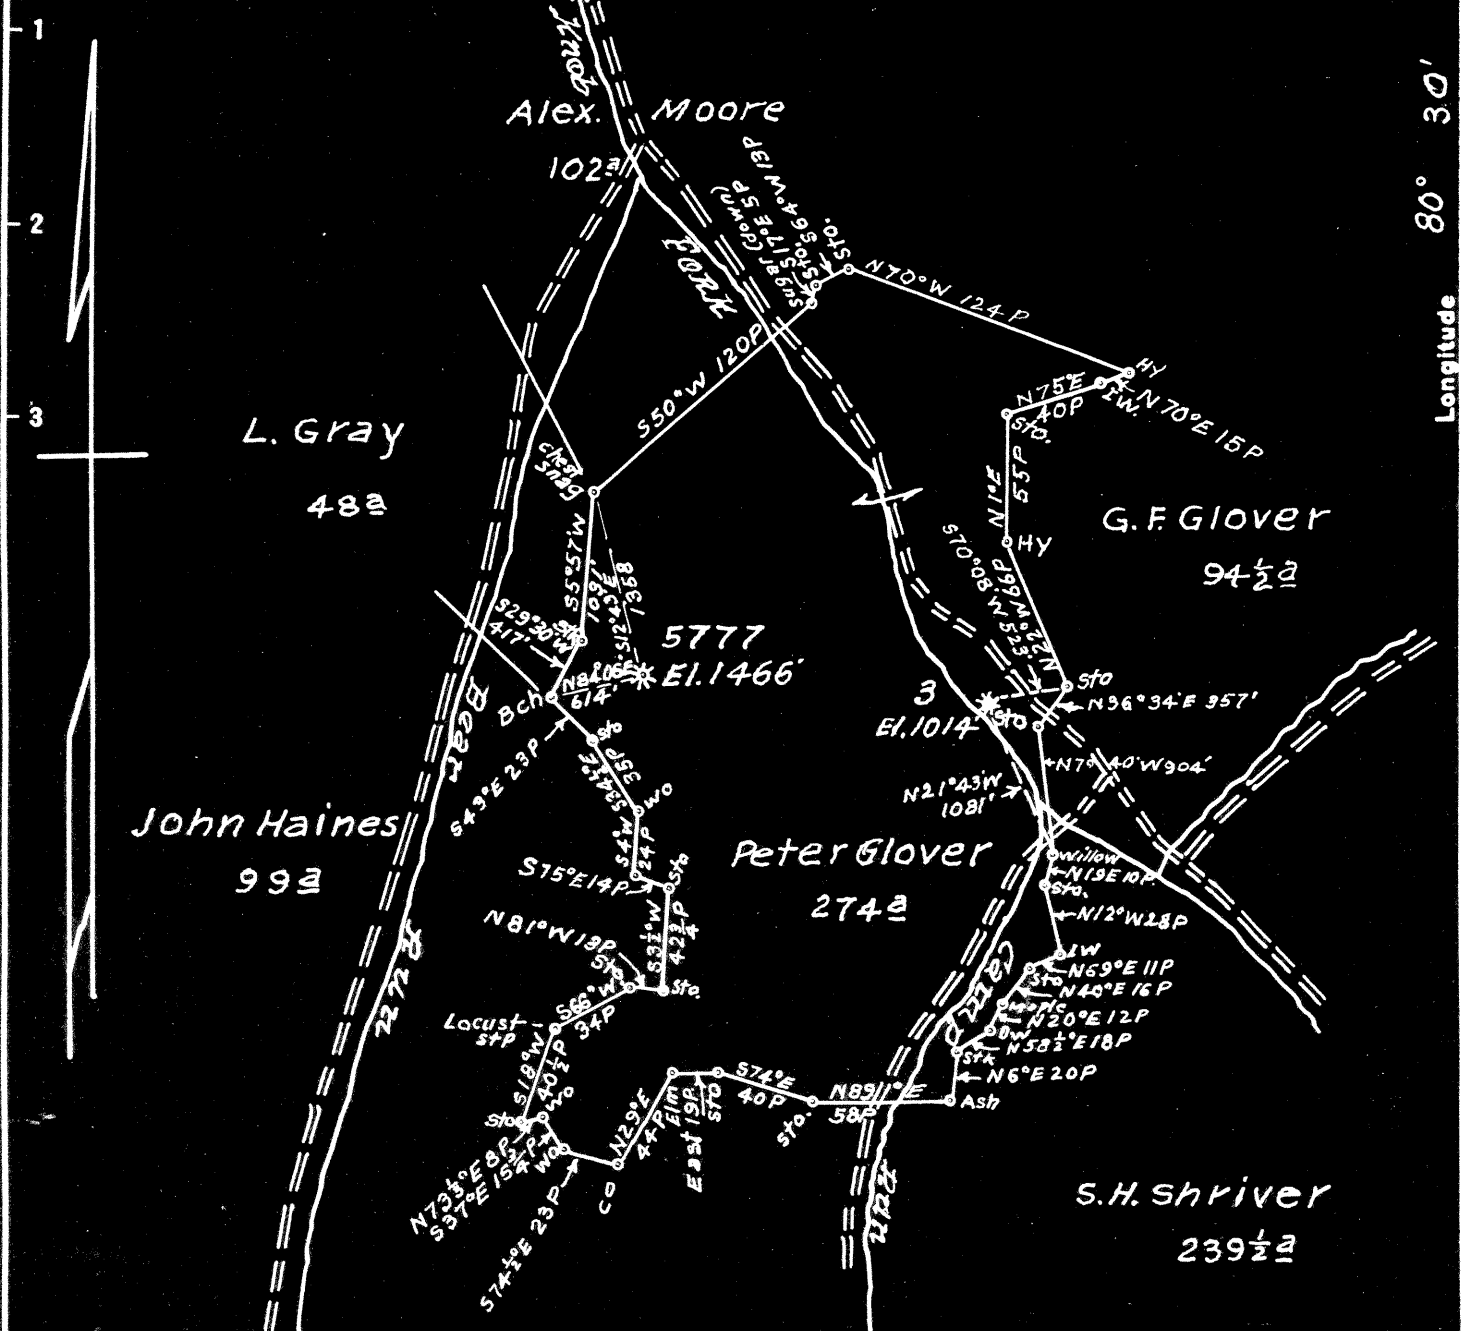

Longitude 80° 30'

#5777	0.27	S
	3.42	W
#3	0.25	S
	3.00	W

New Location...
 Drill Deeper.....
 Abandonment..... 5777

FB. 932 P-1.
 Map Sh.32 N15E 4-5 FB929 P37-38

Company Hope Natural Gas Co
 Address Clarksburg W.Va.
 Farm Peter Glover
 Tract _____ Acres 274 Lease No. 243
 Well (Farm) No. _____ Serial No. As Shown
 Elevation (Spirit Level) As Shown
 Quadrangle Littleton
 County Wetzel District Center
 Engineer Wm Bowers
 Engineer's Registration No. 900
 File No. _____ Drawing No. _____
 Date 5-2-49 Scale 1" = 1320'

STATE OF WEST VIRGINIA
 DEPARTMENT OF MINES
 OIL AND GAS DIVISION
 CHARLESTON

WELL LOCATION MAP
 FILE NO. Wct-808-A-#5777

+ Denotes location of well on United States Topographic Maps, scale 1 to 62,500, latitude and longitude lines being represented by border lines as shown.

- Denotes one inch spaces on border line of original tracing.



STATE OF WEST VIRGINIA
DEPARTMENT OF MINES
OIL AND GAS DIVISION

1275

WELL RECORD

Permit No. 808A

Oil or Gas Well ~~XXXX~~
(KIND)

Company Hope Natural Gas Company
Address 445 West Main St., Clarksburg, W.Va.
Farm Peter Glover Acres 274
Location (waters) _____
Well No. 5777 Elev. 1466
District Center County Wetzel
The surface of tract is owned in fee by _____
Address _____
Mineral rights are owned by _____
Address _____
Drilling commenced Feb. 23, 1920
Drilling completed Apr. 22, 1920
Date Shot Not From _____ To _____
With _____


Casing and Tubing	Used in Drilling	Left in Well	Packers
Size			Kind of Packer
16			
13			
10	505	None	Size of
8 3/4	1735	1735	
6 5/8	2445	2445	Depth set
5 3/16			
3			Perf. top
2			Perf. bottom
Liners Used			Perf. top
			Perf. bottom

Open Flow /10ths Water in _____ Inch
/10ths Merc. in _____ Inch
Volume _____ Cu. Ft.
Rock Pressure _____ lbs. _____ hrs.
Oil _____ bbls., 1st 24 hrs.
Fresh water _____ feet _____ feet
Salt water 2160 feet 2370 feet

CASING CEMENTED Not SIZE _____ No. Ft. _____ Date _____

COAL WAS ENCOUNTERED AT 1135 FEET 60 Est. INCHES
1235 FEET 84 INCHES FEET INCHES
FEET INCHES FEET INCHES

Formation	Color	Hard or Soft	Top	Bottom	Oil, Gas or Water	Depth Found	Remarks
Coal			1135	1140-Est.			
Pgh Coal			1235	1242			
Big Dunkard			1710	1780			
Gas Sand			1840	1935			
First Salt			2085	2270	Water	2160	Hole full
Maxon			2340	2405	Water	2370	
P. Cave			2405	2410			
Big Lime			2410	2462			
Big Injun			2462		Gas	2483	
TOTAL DEPTH				2518			

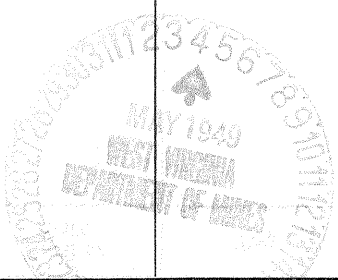

MAY 6 1950

