


Latitude 39° 35' Longitude 80° 45'

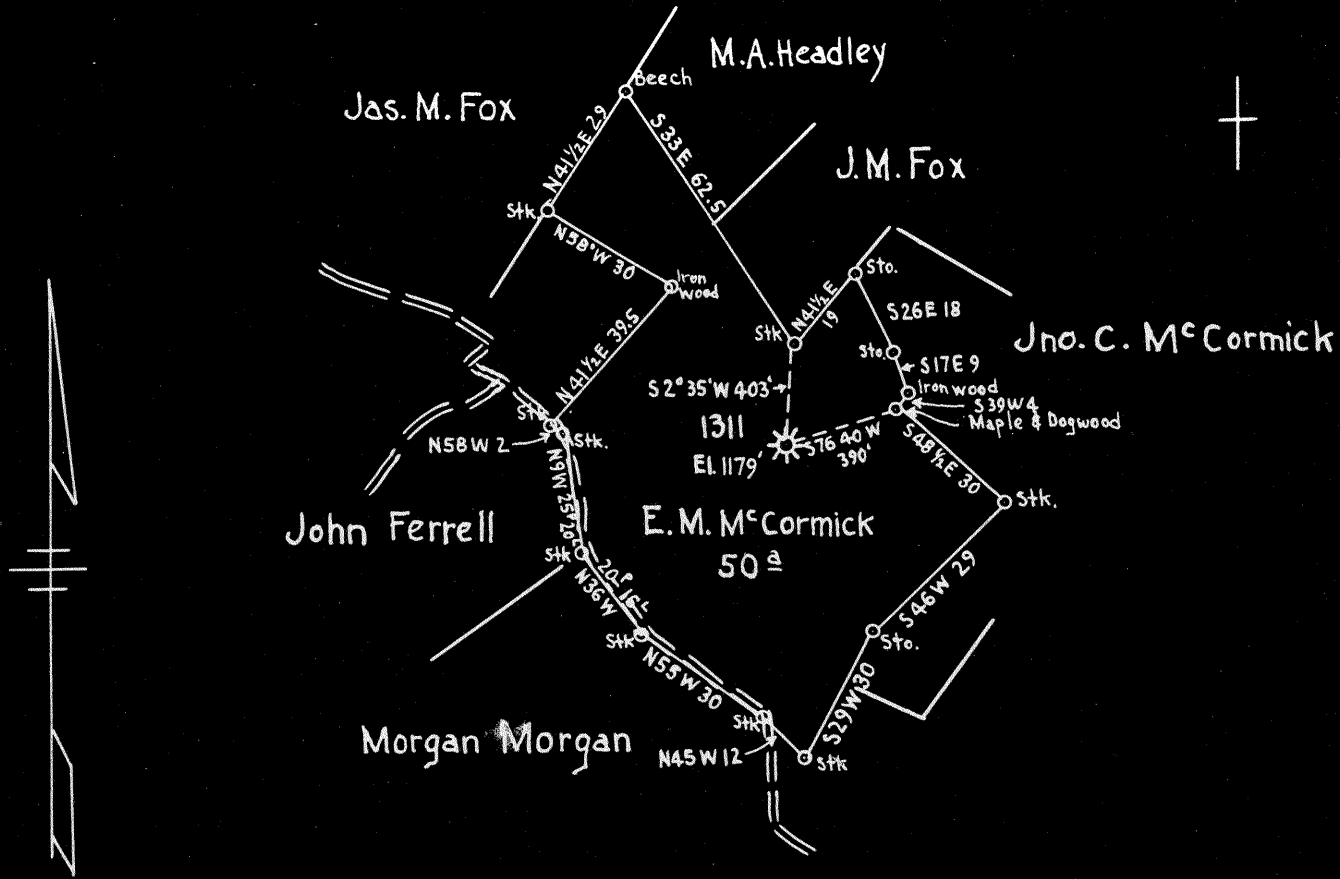

3.74 S
0.88 W

New Location
 Drill Deeper
 Abandonment

FB.45 P.90 Sh 47 N7W8 FB.940P9

Company HOPE NATURAL GAS CO.
 Address CLARKSBURG, W. VA.
 Farm E.M. MCCORMICK
 Tract _____ Acres 50^a Lease No. 15443
 Well (Farm) No. _____ Serial No. 1311
 Elevation (Spirit Level) 1179
 Quadrangle NEW MARTINSVILLE
 County Wetzel District Greene
 Engineer Wm Bowers
 Engineer's Registration No. 900
 File No. _____ Drawing No. _____
 Date 23 Sept. 49 Scale 1" = 40 P.

STATE OF WEST VIRGINIA
 DEPARTMENT OF MINES
 OIL AND GAS DIVISION
 CHARLESTON

WELL LOCATION MAP
 FILE NO. Wet-833-A

+ Denotes location of well on United States Topographic Maps, scale 1 to 62,500, latitude and longitude lines being represented by border lines as shown.
 - Denotes one inch spaces on border line of original tracing.



STATE OF WEST VIRGINIA
DEPARTMENT OF MINES
OIL AND GAS DIVISION

1284

WELL RECORD

Permit No. 833-A Oil or Gas Well (KIND)

Company Hope Natural Gas Company
 Address 445 West Main St. Clarksburg, W. Va.
 Farm E.M. McCormick Acres 50
 Location (waters) _____
 Well No. 1311 Elev. 1179
 District Green County Wetzel
 The surface of tract is owned in fee by _____
 Address _____
 Mineral rights are owned by _____
 Address _____
 Drilling commenced _____
 Drilling completed about 1909
 Date Shot _____ From _____ To _____
 With _____
 Open Flow _____ /10ths Water in _____ Inch
 _____ /10ths Merc. in _____ Inch
 Volume _____ Cu. Ft.
 Rock Pressure _____ lbs. _____ hrs.
 Oil _____ bbls., 1st 24 hrs.
 Fresh water no record feet _____ feet
 Salt water no record feet _____ feet

Casing and Tubing	Used in Drilling	Left in Well	Packers
Size			Kind of Packer
16			
13			
10			Size of
8 1/4	1336	Pulled	
6 3/4	2135	Pulled	Depth set
5 3/16	2245	2245	
3	2943	2943	Perf. top
2			Perf. bottom
Liners Used			Perf. top
			Perf. bottom

CASING CEMENTED NOT SIZE _____ No. Ft. _____ Date _____
 COAL WAS ENCOUNTERED AT 851 FEET 487 INCHES
 _____ FEET _____ INCHES FEET _____ INCHES
 _____ FEET _____ INCHES FEET _____ INCHES

Formation	Color	Hard or Soft	Top	Bottom	Oil, Gas or Water	Depth Found	Remarks
Coal			851	855 Est			
Salt			1551	1865			
Maxon			1970	1990			
Big Lime			/	?			
Fifty foot			2635	2657			
Gordon			2921	2943	gas	?	
Total depth				2943			



MAR 6 1950

Formation	Color	Hard or Soft	Top	Bottom	Oil, Gas or Water	Depth Found	Remarks

Date October 18, 1949, 19

APPROVED Hope Natural Gas Company., Owner

By _____

(Title) _____