WV NORTH NAD 27 SPC		
North	East	Description
255892.28000'	1849705.74000'	PHL28AHS
255126.71020'	1849937.90993'	LANDING PT.
250949.49457'	1851556.94348'	BOT. HOLE

WELL REFERENCES:

N01-03E, 385.59' TO NAIL IN 8" APPLE
N28-02W, 470.84' TO NAIL IN 36" SUGAR

Id	Bearing	Distance
L1	S 76°51'22" E	592.27'
L2	N 15°02'53" E	342.41'
L3	N 46°21'08" W	674.20'
L4	S 16°52'14" E	800.00'

UTM NAD 83 COOR. IN METERS

4,339,580.53 m	583,744.44 m	PHL28AHS
4,339,348.45 m	583,819.05 m	LAND. PT.
4,338,083.98 m	584,333.46 m	BOT. HOLE

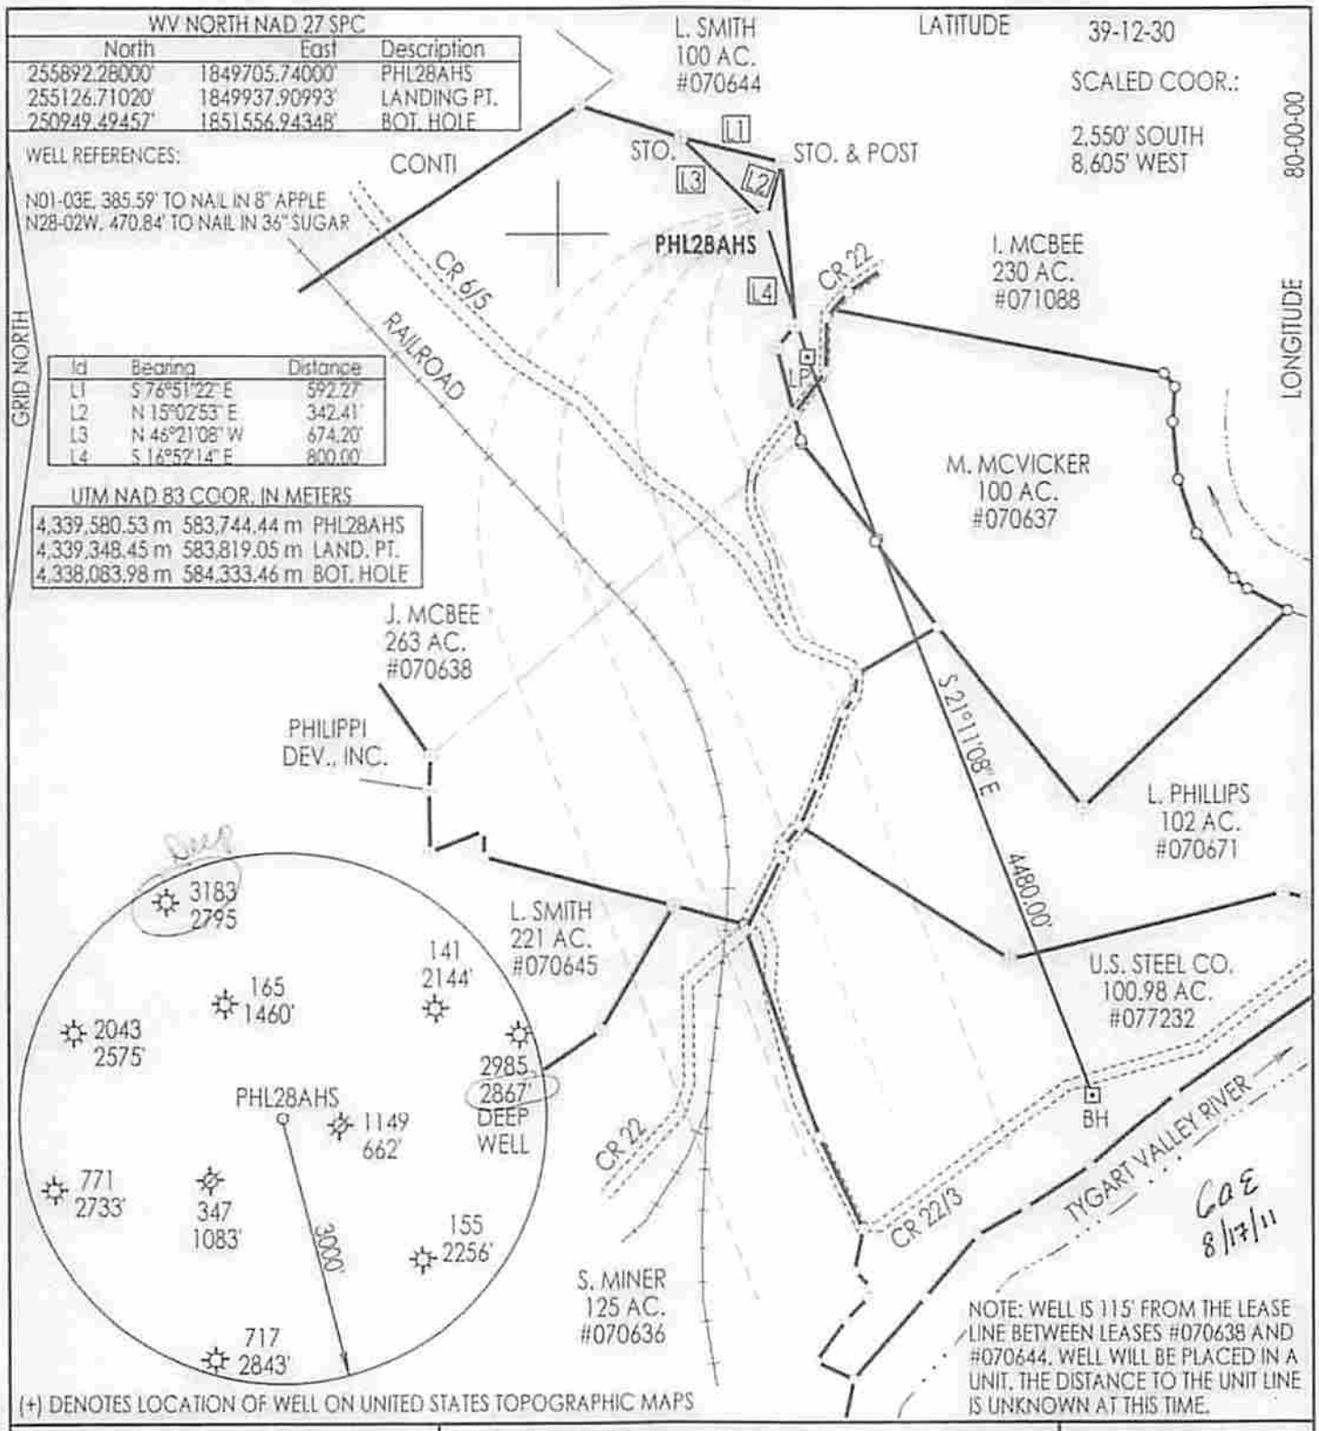

NOTE: WELL IS 115' FROM THE LEASE LINE BETWEEN LEASES #070638 AND #070644. WELL WILL BE PLACED IN A UNIT. THE DISTANCE TO THE UNIT LINE IS UNKNOWN AT THIS TIME.

(+) DENOTES LOCATION OF WELL ON UNITED STATES TOPOGRAPHIC MAPS

FILE NUMBER: _____
DRAWING NUMBER: CGCPHL28AHS.PCS
SCALE: 1" = 1000'
MINIMUM DEGREE OF ACCURACY: CENTIMETER
PROVEN SOURCE OF ELEVATION: DGPS SURVEY
RTK CENTIMETER SYSTEM

I THE UNDERSIGNED, HEREBY STATE THAT THIS PLAT IS CORRECT TO THE BEST OF MY KNOWLEDGE AND BELIEF AND SHOWS ALL THE INFORMATION REQUIRED BY LAW AND THE REGULATIONS ISSUED AND PRESCRIBED BY THE DEPARTMENT OF ENERGY.

(SIGNED) _____

STEPHEN D. LOSH, P.S. #674

PLACE SEAL HERE

STATE OF WEST VIRGINIA
DIVISION OF ENVIRONMENTAL PROTECTION
OFFICE OF OIL AND GAS
#10 MCJUNKIN ROAD
NITRO, WV 25143-2506

FORM WW-6

LAND SURVEYING SERVICES
21 CEDAR LANE, BRIDGEPORT, WV 26330
PHONE: 304-842-2018 OR 842-5762

DATE: AUGUST 02, 2011
OPERATORS WELL NO.: PHL28AHS
API WELL NO.
47 — 001 — 03259H
STATE COUNTY PERMIT

CANCELLED

WELL TYPE: OIL ___ GAS X LIQUID INJECTION ___ WASTE DISPOSAL ___ CBM ___
(IF "GAS") PRODUCTION X STORAGE ___ DEEP X SHALLOW ___

LOCATION: ELEVATION 1423' (GROUND) 1412' (AS BUILT) WATERSHED TAYLOR DRAIN
DISTRICT PLEASANT COUNTY BARBOUR
QUADRANGLE PHILIPPI LEASE NUMBER SEE ABOVE
SURFACE OWNER ROBERT L. MCBEE ACREAGE 71.41 (19-8.1)
OIL & GAS ROYALTY OWNER J. MCBEE, ET. AL. LEASE ACREAGE 1,011.98

PROPOSED WORK: DRILL X CONVERT ___ DRILL DEEPER ___ REDRILL ___ FRACTURE OR STIMULATE X PLUG OFF OLD FORMATION ___
PERFORATE NEW FORMATION ___ OTHER PHYSICAL CHANGE (SPECIFY) _____
PLUG & ABANDON ___ CLEAN OUT & REPLUG ___

TARGET FORMATION ORISKANY, MARCELLUS ESTIMATED DEPTH TVD = 7,800' TMD = 13,500'
WELL OPERATOR CNX GAS COMPANY LLC DESIGNATED AGENT KENT WRIGHT
ADDRESS P. O. BOX 1248 JANE LEW, WV 26378 ADDRESS P. O. BOX 1248 JANE LEW, WV 26378

COUNTY NAME
PERMIT

08/15/2014