

Farm name: Gerald Gourley BRK 3H Operator Well No.: 835867

LOCATION: Elevation: 1,160' Quadrangle: Steubenville East, WV.

District: Cross Creek County: Brooke
Latitude: 5,110' Feet South of 40 Deg. 20 Min. 00 Sec.
Longitude 5,460' Feet West of 80 Deg. 32 Min. 30 Sec.

Company: Chesapeake Appalachia, L.L.C.

Address:	Casing & Tubing	Used in drilling	Left in well	Cement fill up Cu. Ft.
P.O. Box 18496 Oklahoma City, OK 73154-0496	20"	138'	138'	247 Cu. Ft.
Agent: Eric Gillespie	13 3/8"	575'	575'	640 Cu. Ft.
Inspector: Bill Hendershot	9 5/8"	1,570'	1,570'	696 Cu. Ft.
Date Permit Issued: 8-30-2012	5 1/2"	11,100'	11,100'	1,061 Cu. Ft.
Date Well Work Commenced: 11-3-2012				
Date Well Work Completed: 7-18-2013				
Verbal Plugging:				
Date Permission granted on:				
Rotary <input checked="" type="checkbox"/> Cable <input type="checkbox"/> Rig <input type="checkbox"/>				
Total Vertical Depth (ft): 5,674'				
Total Measured Depth (ft): 11,110'				
Fresh Water Depth (ft.): 520'				
Salt Water Depth (ft.): 676'				
Is coal being mined in area (N/Y)? N				
Coal Depths (ft.): 704'				
Void(s) encountered (N/Y) Depth(s) Y 704'				

Received
Office of Oil & Gas
JUL 30 2015

OPEN FLOW DATA (If more than two producing formations please include additional data on separate sheet)

Producing formation Marcellus Pay zone depth (ft) 5,900-10,855
Gas: Initial open flow _____ MCF/d Oil: Initial open flow _____ Bbl/d
Final open flow 1,199* MCF/d Final open flow 228 Bbl/d
Time of open flow between initial and final tests 72 Hours *Calculated
Static rock Pressure 3,688* psig (surface pressure) after 72 Hours

Second producing formation _____ Pay zone depth (ft) _____
Gas: Initial open flow _____ MCF/d Oil: Initial open flow _____ Bbl/d
Final open flow _____ MCF/d Final open flow _____ Bbl/d
Time of open flow between initial and final tests _____ Hours
Static rock Pressure _____ psig (surface pressure) after _____ Hours

RECEIVED
Office of Oil and Gas

FEB 27 2015

I certify under penalty of law that I have personally examined and am familiar with the information submitted on this document and all the attachments and that, based on my inquiry of those individuals immediately responsible for obtaining the information I believe that the information is true, accurate, and complete.

Marilyn Williams
Signature

2-26-15
Date

WV Department of
Environmental Protection

9-00149

Were core samples taken? Yes _____ No N

Were cuttings caught during drilling? Yes Y No _____

Were Electrical, Mechanical or Geophysical logs recorded on this well? If yes, please list _____
LWD GR from 5020-11110' MD.

NOTE: IN THE AREA BELOW PUT THE FOLLOWING: 1). DETAILS OF PERFORATED INTERVALS, FRACTURING OR STIMULATING, PHYSICAL CHANGE, ETC. 2). THE WELL LOG WHICH IS A SYSTEMATIC DETAILED GEOLOGICAL RECORD OF THE TOPS AND BOTTOMS OF ALL FORMATIONS, INCLUDING COAL ENCOUNTERED BY THE WELLBORE FROM SURFACE TO TOTAL DEPTH.

Perforated Intervals, Fracturing, or Stimulating:

See attached

Plug Back Details Including Plug Type and Depth(s):

Formations Encountered: _____ Top Depth _____ / _____ Bottom Depth _____
Surface: _____

See attached

Received
Office of Oil & Gas
JUL 30 2015

RECEIVED
Office of Oil and Gas

FEB 27 2015

WV Department of
Environmental Protection

04/08/2016

9-00149

LATERAL WELLBORE (no vertical pilot hole associated with this well)

Maximum TVD of wellbore: 5674 ft TVD @ 5998 ft MD

Formation/Lithology	Top Depth, MD (ft)	Top Depth, TVD (ft)	Bottom Depth, MD (ft)	Bottom Depth, TVD (ft)
SS	0	0	704	704
PITTSBURG COAL (VOID)	704	704	708	708
SS	708	708	758	758
COAL	758	758	766	766
SS	766	766	1110	1110
BIG LIME	1110	1110	1220	1220
BIG INJUN (SS)	1220	1220	1343	1343
SHALE	1343	1343	5545	5499
GENESEO (SH)	5545	5499	5565	5514
TULLY (LS)	5565	5514	5637	5564
HAMILTON (SH)	5637	5564	5785	5636
MARCELLUS (SH)	5785	5636		
TD OF LATERAL			11110	5614

Received
Office of Oil & Gas
JUL 30 2015

RECEIVED
Office of Oil and Gas

FEB 27 2015

WV Department of
Environmental Protection


04/08/2016

9-00149



Project: Brooke County, WV
Site: Gerald Gourley
Well: Gerald Gourley BRK 3H
Wellbore: HZ
Design: HZ

Received
Office of Oil & Gas
JUL 30 2015
CATHEDRAL


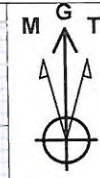


Azimuths to Grid North
True North: 0.68°
Magnetic North: -8.14°

Magnetic Field
Strength: 52978.7snT
Dip Angle: 67.73°
Date: 11/14/2012
Model: IGRF2010

Northing		Ground Level: 1160.0		
+N/-S	+E/-W	Easting	Latitude	Longitude
0.0	0.0	664059.06	1704417.07	40° 19' 6.085 N 80° 33' 35.856 W

TARGET LINE
5688' TVD @ 0° VS; 90.8°

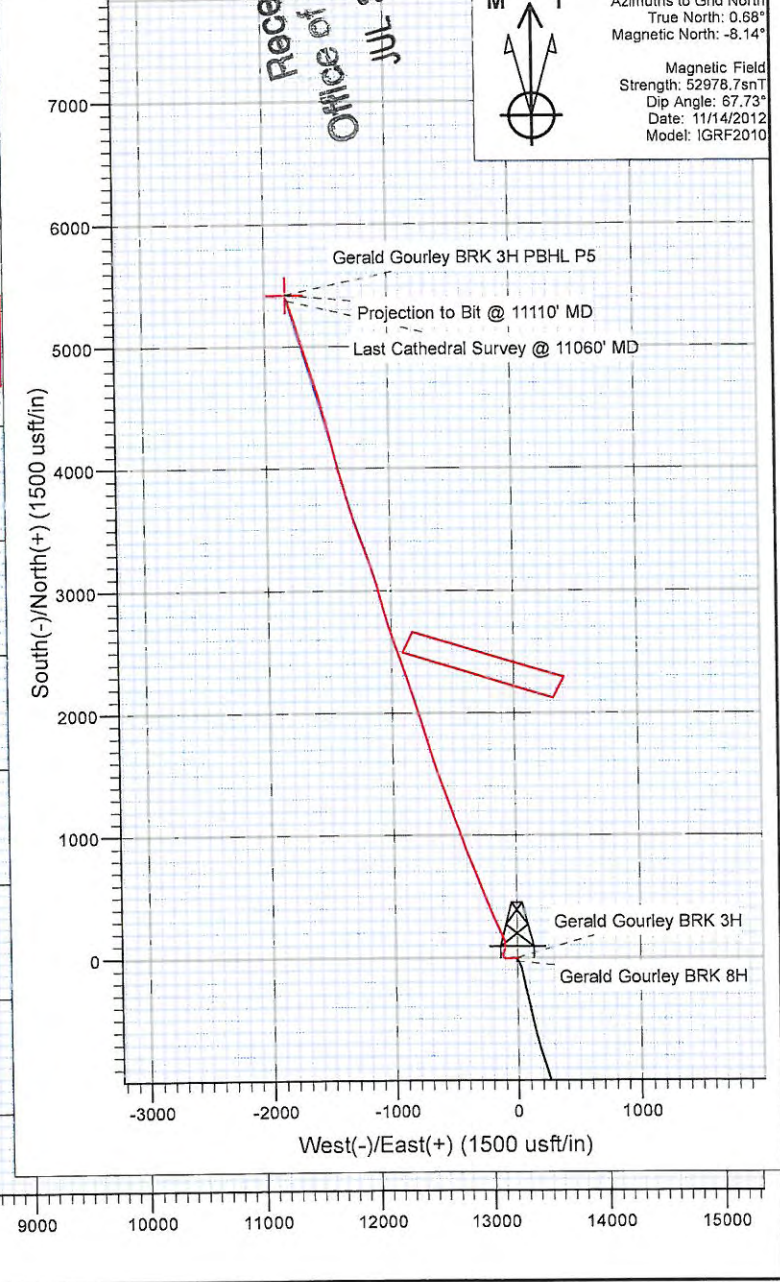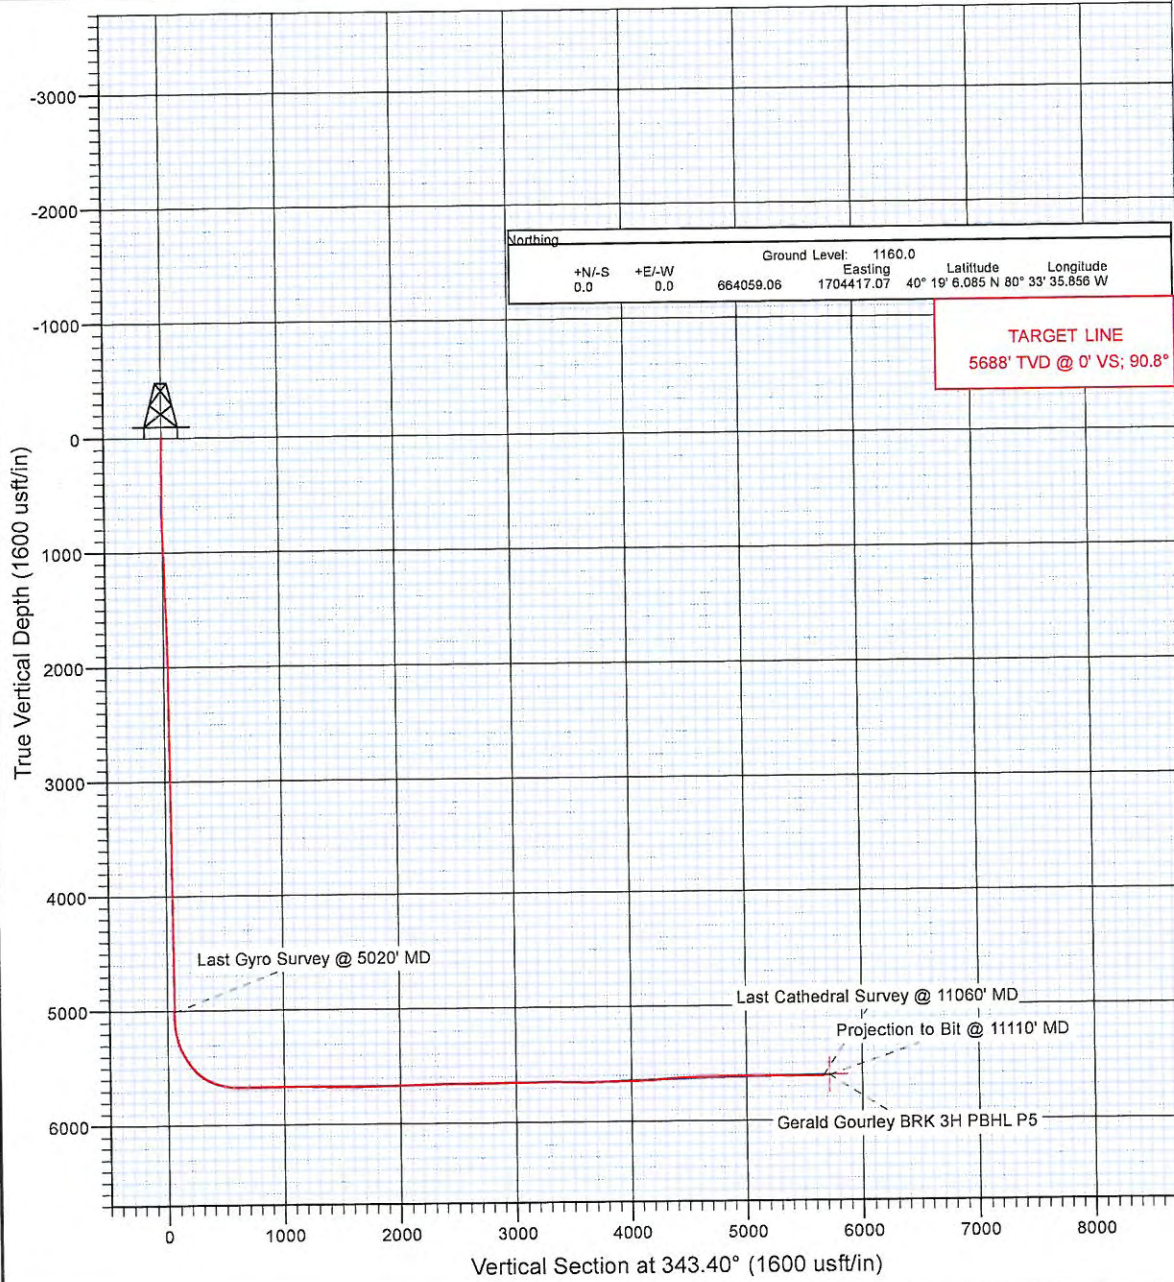

Cathedral Energy Services

9.00149

Survey Report

Company:	Chesapeake Energy Corp	Local Co-ordinate Reference:	Well Gerald Gourley BRK 3H
Project:	Brooke County, WV	TVD Reference:	WELL @ 1178.0usft (Original Well Elev)
Site:	Gerald Gourley	MD Reference:	WELL @ 1178.0usft (Original Well Elev)
Well:	Gerald Gourley BRK 3H	North Reference:	Grid
Wellbore:	HZ	Survey Calculation Method:	Minimum Curvature
Design:	HZ	Database:	USA EDM 5000 Multi Users DB

Project	Brooke County, WV		
Map System:	US State Plane 1927 (Exact solution)	System Datum:	Mean Sea Level
Geo Datum:	NAD 1927 (NADCON CONUS)		Using geodetic scale factor
Map Zone:	West Virginia North 4701		

Site	Gerald Gourley				
Site Position:		Northing:	664,030.25 usft	Latitude:	40° 19' 5.800 N
From:	Lat/Long	Easting:	1,704,413.33 usft	Longitude:	80° 33' 35.900 W
Position Uncertainty:	0.0 usft	Slot Radius:	13-3/16"	Grid Convergence:	-0.68 °

Well	Gerald Gourley BRK 3H					
Well Position	+N/-S	0.0 usft	Northing:	664,059.06 usft	Latitude:	40° 19' 6.085 N
	+E/-W	0.0 usft	Easting:	1,704,417.07 usft	Longitude:	80° 33' 35.856 W
Position Uncertainty		0.0 usft	Wellhead Elevation:	usft	Ground Level:	1,160.0 usft

Wellbore	HZ				
Magnetics	Model Name	Sample Date	Declination (°)	Dip Angle (°)	Field Strength (nT)
	IGRF2010	11/14/2012	-8.81	67.73	52,979

Design	HZ				
Audit Notes:					
Version:	1.0	Phase:	ACTUAL	Tie On Depth:	0.0
Vertical Section:	Depth From (TVD) (usft)	+N/-S (usft)	+E/-W (usft)	Direction (°)	
	0.0	0.0	0.0	343.40	

Survey Program	Date	12/4/2012			
From (usft)	To (usft)	Survey (Wellbore)	Tool Name	Description	
100.0	5,020.0	Gyro 2 (HZ)	Gyro	Gyro	
5,114.0	11,110.0	Survey #4 (HZ)	MWD	Geolink MWD	

Measured Depth (usft)	Inclination (°)	Azimuth (°)	Vertical Depth (usft)	+N/-S (usft)	+E/-W (usft)	Vertical Section (usft)	Dogleg Rate (°/100usft)	Build Rate (°/100u)	Formations / Comments
0.0	0.00	0.00	0.0	0.0	0.0	0.0	0.00	0.00	
100.0	0.76	196.93	100.0	-0.6	-0.2	-0.6	0.76	0.76	
200.0	0.73	190.41	200.0	-1.9	-0.5	-1.7	0.09	-0.03	
300.0	0.48	189.14	300.0	-2.9	-0.7	-2.6	0.25	-0.25	
400.0	0.13	190.29	400.0	-3.5	-0.8	-3.1	0.35	-0.35	
500.0	0.52	122.07	500.0	-3.8	-0.4	-3.5	0.49	0.39	
600.0	0.48	138.39	600.0	-4.4	0.3	-4.3	0.15	-0.04	
700.0	1.08	261.30	700.0	-4.8	-0.4	-4.5	1.40	0.60	
800.0	3.26	269.20	799.9	-5.0	-4.2	-3.6	2.20	2.18	
900.0	6.38	278.38	899.5	-4.2	-12.5	-0.5	3.20	3.12	
1,000.0	8.80	276.21	998.6	-2.6	-25.6	4.8	2.44	2.42	
1,100.0	10.13	262.42	1,097.3	-2.9	-41.9	9.2	2.62	1.33	

Received
Office of Oil & Gas
JUL 30 2015

04/08/2016

Cathedral Energy Services

Survey Report

9-00149

Company:	Chesapeake Energy Corp	Local Co-ordinate Reference:	Well Gerald Gourley BRK 3H
Project:	Brooke County, WV	TVD Reference:	WELL @ 1178.0usft (Original Well Elev)
Site:	Gerald Gourley	MD Reference:	WELL @ 1178.0usft (Original Well Elev)
Well:	Gerald Gourley BRK 3H	North Reference:	Grid
Wellbore:	HZ	Survey Calculation Method:	Minimum Curvature
Design:	HZ	Database:	USA EDM 5000 Multi Users DB

Survey									
Measured Depth (usft)	Inclination (°)	Azimuth (°)	Vertical Depth (usft)	+N/-S (usft)	+E/-W (usft)	Vertical Section (usft)	Dogleg Rate (°/100usft)	Build Rate (°/100u)	Formations / Comments
1,200.0	8.72	258.81	1,195.9	-5.6	-58.1	11.3	1.53	-1.41	
1,300.0	6.65	261.90	1,295.0	-7.8	-71.3	12.8	2.11	-2.07	
1,400.0	5.50	278.48	1,394.5	-8.0	-81.7	15.7	2.09	-1.15	
1,500.0	3.96	291.34	1,494.1	-6.0	-89.7	19.9	1.86	-1.54	
1,600.0	3.58	294.13	1,593.9	-3.5	-95.8	24.0	0.42	-0.38	
1,700.0	2.61	289.00	1,693.8	-1.4	-100.8	27.4	1.01	-0.97	
1,800.0	1.96	292.37	1,793.7	-0.1	-104.5	29.8	0.66	-0.65	
1,900.0	1.09	297.49	1,893.7	1.0	-106.9	31.5	0.88	-0.87	
2,000.0	1.01	299.55	1,993.6	1.9	-108.5	32.8	0.09	-0.08	
2,100.0	0.77	311.07	2,093.6	2.8	-109.8	34.0	0.30	-0.24	
2,200.0	0.54	315.94	2,193.6	3.6	-110.6	35.0	0.24	-0.23	
2,300.0	0.75	328.34	2,293.6	4.5	-111.3	36.1	0.25	0.21	
2,400.0	0.76	329.91	2,393.6	5.6	-112.0	37.4	0.02	0.01	
2,500.0	0.74	334.11	2,493.6	6.7	-112.6	38.6	0.06	-0.02	
2,600.0	0.82	337.24	2,593.6	8.0	-113.2	40.0	0.09	0.08	
2,700.0	0.52	339.56	2,693.6	9.1	-113.6	41.2	0.30	-0.30	
2,800.0	0.33	347.18	2,793.6	9.8	-113.8	41.9	0.20	-0.19	
2,900.0	0.33	351.14	2,893.6	10.3	-113.9	42.5	0.02	0.00	
3,000.0	0.63	357.66	2,993.6	11.2	-114.0	43.3	0.30	0.30	
3,100.0	0.70	352.29	3,093.6	12.3	-114.1	44.4	0.09	0.07	
3,200.0	0.39	354.63	3,193.6	13.3	-114.2	45.4	0.31	-0.31	
3,300.0	0.60	344.71	3,293.6	14.1	-114.4	46.2	0.23	0.21	
3,400.0	0.74	346.78	3,393.6	15.3	-114.7	47.4	0.14	0.14	
3,500.0	0.56	356.95	3,493.5	16.4	-114.8	48.5	0.21	-0.18	
3,600.0	0.51	7.17	3,593.5	17.3	-114.8	49.4	0.11	-0.05	
3,700.0	0.44	5.24	3,693.5	18.1	-114.7	50.1	0.07	-0.07	
3,800.0	0.37	12.73	3,793.5	18.8	-114.6	50.8	0.09	-0.07	
3,900.0	0.39	8.48	3,893.5	19.5	-114.5	51.4	0.03	0.02	
4,000.0	0.53	355.06	3,993.5	20.3	-114.5	52.1	0.18	0.14	
4,100.0	0.56	344.07	4,093.5	21.2	-114.7	53.1	0.11	0.03	
4,200.0	0.47	343.04	4,193.5	22.1	-114.9	54.0	0.09	-0.09	
4,300.0	0.50	336.07	4,293.5	22.9	-115.2	54.8	0.07	0.03	
4,400.0	0.49	334.98	4,393.5	23.6	-115.6	55.7	0.01	-0.01	
4,500.0	0.30	330.56	4,493.5	24.3	-115.9	56.4	0.19	-0.19	
4,600.0	0.69	313.39	4,593.5	24.9	-116.4	57.1	0.41	0.39	
4,700.0	0.69	297.68	4,693.5	25.6	-117.4	58.1	0.19	0.00	
4,800.0	0.51	323.67	4,793.5	26.2	-118.2	58.9	0.32	-0.18	
4,900.0	0.58	332.30	4,893.5	27.0	-118.7	59.8	0.11	0.07	
5,000.0	0.48	338.97	4,993.5	27.9	-119.1	60.7	0.12	-0.10	
5,020.0	0.38	337.07	5,013.5	28.0	-119.1	60.9	0.50	-0.50	Last Gyro Survey @ 5020' MD
5,114.0	2.60	18.90	5,107.4	30.3	-118.6	62.9	2.48	2.36	Received
5,145.0	6.50	18.90	5,138.3	32.6	-117.8	64.9	12.58	12.58	Office of Oil & Gas
5,177.0	10.20	24.10	5,170.0	36.9	-116.0	68.6	11.79	11.56	JUL 30 2015
5,209.0	13.80	29.80	5,201.3	42.8	-113.0	73.3	11.83	11.25	
5,241.0	17.00	27.50	5,232.1	50.3	-108.9	79.3	10.18	10.00	
5,273.0	20.30	23.30	5,262.5	59.6	-104.6	87.0	11.13	10.31	
5,304.0	23.10	17.50	5,291.3	70.3	-100.6	96.1	11.37	9.03	
5,335.0	25.20	9.60	5,319.6	82.6	-97.7	107.1	12.42	6.77	
5,367.0	27.30	1.80	5,348.3	96.7	-96.3	120.2	12.61	6.56	
5,398.0	28.90	354.20	5,375.6	111.2	-96.8	134.3	12.64	5.16	
5,430.0	29.70	345.50	5,403.5	126.6	-99.6	149.8	13.53	2.50	
5,462.0	31.50	337.90	5,431.1	142.0	-104.7	166.0	13.32	5.63	
5,494.0	34.50	337.20	5,457.9	158.1	-111.4	183.4	9.45	9.38	

04/08/2016

Cathedral Energy Services

Survey Report

9-00149

Company:	Chesapeake Energy Corp	Local Co-ordinate Reference:	Well Gerald Gourley BRK 3H
Project:	Brooke County, WV	TVD Reference:	WELL @ 1178 0usft (Original Well Elev)
Site:	Gerald Gourley	MD Reference:	WELL @ 1178 0usft (Original Well Elev)
Well:	Gerald Gourley BRK 3H	North Reference:	Grid
Wellbore:	HZ	Survey Calculation Method:	Minimum Curvature
Design:	HZ	Database:	USA EDM 5000 Multi Users DB

Measured Depth (usft)	Inclination (°)	Azimuth (°)	Vertical Depth (usft)	+N/-S (usft)	+E/-W (usft)	Vertical Section (usft)	Dogleg Rate (°/100usft)	Build Rate (°/100u)	Formations / Comments
5,526.0	37.00	338.30	5,483.9	175.4	-118.5	202.0	8.07	7.81	
5,556.0	39.60	338.60	5,507.4	192.7	-125.3	220.5	8.69	8.66	
5,588.0	43.90	337.20	5,531.3	212.5	-133.3	241.7	13.75	13.44	
5,620.0	47.90	336.10	5,553.6	233.6	-142.4	264.5	12.74	12.50	
5,651.0	52.70	335.00	5,573.4	255.3	-152.3	288.2	15.72	15.48	
5,684.0	56.70	335.00	5,592.4	279.7	-163.7	314.8	12.12	12.12	
5,716.0	61.70	335.80	5,608.8	304.7	-175.1	342.0	15.77	15.62	
5,747.0	66.40	336.10	5,622.4	330.1	-186.5	369.6	15.19	15.16	
5,779.0	70.10	336.70	5,634.2	357.3	-198.4	399.1	11.69	11.56	
5,811.0	73.20	337.70	5,644.3	385.3	-210.2	429.3	10.13	9.69	
5,843.0	75.40	338.00	5,653.0	413.9	-221.8	460.0	6.93	6.87	
5,873.0	77.20	338.20	5,660.1	440.9	-232.6	489.0	6.03	6.00	
5,904.0	80.30	339.10	5,666.1	469.2	-243.7	519.3	10.40	10.00	
5,936.0	83.50	339.20	5,670.6	498.8	-255.0	550.9	10.00	10.00	
5,967.0	86.90	339.30	5,673.2	527.7	-265.9	581.7	10.97	10.97	
5,998.0	90.10	338.70	5,674.0	556.6	-277.0	612.6	10.50	10.32	
6,061.0	91.30	338.30	5,673.3	615.3	-300.1	675.3	2.01	1.90	
6,124.0	91.50	338.40	5,671.7	673.8	-323.4	738.1	0.35	0.32	
6,187.0	91.50	338.00	5,670.1	732.3	-346.7	800.8	0.63	0.00	
6,251.0	90.50	337.50	5,669.0	791.5	-371.0	864.5	1.75	-1.56	
6,314.0	90.40	338.70	5,668.5	849.9	-394.5	927.2	1.91	-0.16	
6,377.0	88.60	339.70	5,669.0	908.8	-416.8	990.0	3.27	-2.86	
6,440.0	89.20	340.60	5,670.2	968.1	-438.2	1,052.9	1.72	0.95	
6,504.0	89.20	340.50	5,671.1	1,028.4	-459.5	1,116.8	0.16	0.00	
6,566.0	89.40	340.50	5,671.9	1,086.9	-480.2	1,178.8	0.32	0.32	
6,629.0	89.90	341.10	5,672.3	1,146.3	-500.9	1,241.7	1.24	0.79	
6,691.0	89.60	340.40	5,672.5	1,204.9	-521.4	1,303.6	1.23	-0.48	
6,754.0	89.60	340.30	5,673.0	1,264.2	-542.6	1,366.5	0.16	0.00	
6,816.0	89.90	340.50	5,673.2	1,322.6	-563.4	1,428.4	0.58	0.48	
6,879.0	90.00	340.20	5,673.3	1,381.9	-584.6	1,491.4	0.50	0.16	
6,942.0	90.00	340.40	5,673.3	1,441.2	-605.8	1,554.2	0.32	0.00	
7,005.0	89.80	340.40	5,673.4	1,500.6	-626.9	1,617.2	0.32	-0.32	
7,068.0	90.80	342.00	5,673.1	1,560.2	-647.2	1,680.1	2.99	1.59	
7,131.0	90.80	342.40	5,672.2	1,620.2	-666.5	1,743.1	0.63	0.00	
7,194.0	90.80	342.60	5,671.3	1,680.3	-685.4	1,806.1	0.32	0.00	
7,255.0	90.70	342.90	5,670.5	1,738.5	-703.5	1,867.1	0.52	-0.16	
7,318.0	90.80	344.00	5,669.7	1,798.9	-721.5	1,930.1	1.75	0.16	
7,443.0	91.20	341.40	5,667.5	1,918.2	-758.6	2,055.0	2.10	0.32	
7,505.0	91.40	342.30	5,666.1	1,977.1	-777.9	2,117.0	1.49	0.32	
7,569.0	91.50	342.60	5,664.5	2,038.1	-797.2	2,181.0	0.49	0.16	
7,694.0	91.80	342.40	5,660.9	2,157.3	-834.8	2,305.9	0.29	0.24	
7,817.0	90.90	341.70	5,658.0	2,274.3	-872.7	2,428.8	0.93	-0.73	
7,944.0	89.70	340.70	5,657.3	2,394.5	-913.6	2,555.7	1.23	-0.94	
8,070.0	90.00	340.50	5,657.6	2,513.3	-955.5	2,681.6	0.29	0.24	
8,196.0	89.80	340.60	5,657.9	2,632.2	-997.4	2,807.4	0.18	-0.16	
8,323.0	91.80	344.40	5,656.1	2,753.2	-1,035.6	2,934.3	3.38	1.57	
8,450.0	90.90	345.00	5,653.1	2,875.7	-1,089.1	3,061.3	0.85	-0.71	
8,574.0	90.90	345.50	5,651.2	2,995.6	-1,100.7	3,185.2	0.40	0.00	
8,701.0	90.00	342.60	5,650.2	3,117.7	-1,135.6	3,312.2	2.39	-0.71	
8,827.0	88.30	340.40	5,652.0	3,237.2	-1,175.5	3,438.1	2.21	-1.35	
8,954.0	87.20	339.50	5,657.0	3,356.4	-1,219.0	3,564.7	1.12	-0.87	
9,080.0	92.30	340.30	5,657.6	3,474.6	-1,262.3	3,690.5	4.10	4.05	
9,204.0	92.20	342.40	5,652.7	3,592.0	-1,301.9	3,814.3	1.69	-0.08	

Received
Office of Oil & Gas
JUL 30 2015

Cathedral Energy Services

Survey Report

9-00149

Company:	Chesapeake Energy Corp	Local Co-ordinate Reference:	Well Gerald Gourley BRK 3H
Project:	Brooke County, WV	TVD Reference:	WELL @ 1178.0usft (Original Well Elev)
Site:	Gerald Gourley	MD Reference:	WELL @ 1178.0usft (Original Well Elev)
Well:	Gerald Gourley BRK 3H	North Reference:	Grid
Wellbore:	HZ	Survey Calculation Method:	Minimum Curvature
Design:	HZ	Database:	USA EDM 5000 Multi Users DB

Measured Depth (usft)	Inclination (°)	Azimuth (°)	Vertical Depth (usft)	+N/-S (usft)	+E/-W (usft)	Vertical Section (usft)	Dogleg Rate (°/100usft)	Build Rate (°/100u)	Formations / Comments
9,331.0	90.00	343.00	5,650.3	3,713.3	-1,339.7	3,941.2	1.80	-1.73	
9,458.0	91.30	344.10	5,648.8	3,835.1	-1,375.7	4,068.2	1.34	1.02	
9,584.0	93.40	343.60	5,643.6	3,956.0	-1,410.7	4,194.1	1.71	1.67	
9,709.0	95.20	345.70	5,634.3	4,076.2	-1,443.7	4,318.7	2.21	1.44	
9,835.0	93.10	346.60	5,625.2	4,198.2	-1,473.7	4,444.2	1.81	-1.67	
9,961.0	91.60	345.80	5,620.0	4,320.4	-1,503.8	4,570.0	1.35	-1.19	
10,086.0	91.70	345.40	5,616.4	4,441.4	-1,534.8	4,694.8	0.33	0.08	
10,212.0	90.80	344.60	5,613.6	4,563.1	-1,567.5	4,820.7	0.96	-0.71	
10,337.0	89.80	342.90	5,613.0	4,683.1	-1,602.4	4,945.7	1.58	-0.80	
10,464.0	90.60	342.90	5,612.5	4,804.5	-1,639.8	5,072.7	0.63	0.63	
10,590.0	88.80	343.00	5,613.2	4,925.0	-1,676.7	5,198.7	1.43	-1.43	
10,717.0	89.00	342.60	5,615.6	5,046.3	-1,714.3	5,325.7	0.35	0.16	
10,842.0	89.40	342.80	5,617.4	5,165.6	-1,751.4	5,450.7	0.36	0.32	
10,966.0	90.40	342.50	5,617.6	5,283.9	-1,788.4	5,574.6	0.84	0.81	
11,060.0	91.40	342.80	5,616.1	5,373.7	-1,816.4	5,668.7	1.11	1.06	Last Cathedral Survey @ 11060' MD
11,110.0	91.40	342.80	5,614.9	5,421.4	-1,831.2	5,718.6	0.00	0.00	Projection to Bit @ 11110' MD

Target Name	Dip Angle (°)	Dip Dir. (°)	TVD (usft)	+N/-S (usft)	+E/-W (usft)	Northing (usft)	Easting (usft)	Latitude	Longitude
Gerald Gourley BRK 3H - hit/miss target - Shape - Point	0.00	360.00	5,620.1	5,421.7	-1,832.6	669,480.88	1,702,584.46	40° 19' 59.444 N	80° 34' 0.343 W
- actual wellpath misses target center by 5.4usft at 11110.0usft MD (5614.9 TVD, 5421.4 N, -1831.2 E)									
Gerald Gourley BRK 3H - hit/miss target - Shape - Point	0.00	360.00	5,590.1	5,421.7	-1,832.6	669,480.88	1,702,584.46	40° 19' 59.444 N	80° 34' 0.343 W
- actual wellpath misses target center by 24.9usft at 11110.0usft MD (5614.9 TVD, 5421.4 N, -1831.2 E)									
Gerald Gourley BRK 3H - hit/miss target - Shape - Point	0.00	360.00	5,608.1	5,421.7	-1,832.6	669,480.88	1,702,584.46	40° 19' 59.444 N	80° 34' 0.343 W
- actual wellpath misses target center by 7.0usft at 11110.0usft MD (5614.9 TVD, 5421.4 N, -1831.2 E)									

Measured Depth (usft)	Vertical Depth (usft)	Local Coordinates		Comment
		+N/-S (usft)	+E/-W (usft)	
5,020.0	5,013.5	28.0	-119.1	Last Gyro Survey @ 5020' MD
11,060.0	5,616.1	5,373.7	-1,816.4	Last Cathedral Survey @ 11060' MD
11,110.0	5,614.9	5,421.4	-1,831.2	Projection to Bit @ 11110' MD

Checked By: _____ Approved By: _____ Date Received: _____

Office of Oil & Gas
JUL 30 2015

04/08/2016

Hydraulic Fracturing Fluid Product Component Information Disclosure

9-00149

Fracture Date:	6/15/2013
State:	WEST VIRGINIA
County:	BROOKE
API Number:	4700900149
Operator Name:	CHESAPEAKE APPALACHIA LLC
Well Name and Number:	GERALD GOURLEY BRK 3H
Longitude:	-80.55996
Latitude:	40.318357
Long/Lat Projection:	NAD27
Production Type:	GAS
True Vertical Depth (TVD):	5,674
Total Water Volume (gal)*:	4,724,160

Received
Office of Oil & Gas
5/10/2015 11:03 AM

RECEIVED
Office of Oil and Gas

FEB 27 2015

WV Department of
Environmental Protection

Hydraulic Fracturing Fluid Composition:

Trade Name	Supplier	Purpose	Ingredients	Chemical Abstract Service Number (CAS #)	Maximum Ingredient Concentration in Additive (% by Mass)**	Maximum Ingredient Concentration in HF Fluid (% by Mass)**	Comments
Fresh Water	CHESAPEAKE ENERGY	Carrier/Base Fluid	Water	007732-18-5	100.00%	80.19879%	
Recycled Produced Water	CHESAPEAKE ENERGY	Carrier/Base Fluid	Water	007732-18-5	100.00%	4.83198%	
EC6110A	NALCO	Anti-Bacterial Agent	Ethanol	000064-17-5	5.00%	0.00136%	
			Glutaraldehyde (Pentanediol)	000111-30-8	60.00%	0.01631%	
			Quaternary Ammonium Compounds	NA	10.00%	0.00272%	
EC6629A	NALCO	Scale Inhibitor	No Hazardous Components	NONE		0.00000%	
Northern White Sand, 100 Mesh Sand, Acid Hydrochloric, J580, J609, B315, L058, A264, J218	SCHLUMBERGER	Proppant - Natural, Acid, Gelling Agent, Friction Reducer, Iron Control Agent, Corrosion Inhibitor, Breaker	Crystalline silica	14808-60-7	98.47696%	14.78121%	
			Hydrogen chloride	7647-01-0	0.99475%	0.14931%	
			Acrylamide sodium acrylate copolymer	25085-02-3	0.21353%	0.03205%	
			Distillates (petroleum), hydrotreated light	64742-47-8	0.19566%	0.02937%	
			Guar gum	9000-30-0	0.03984%	0.00598%	
			Alkylalcohol, ethoxylate >C10	68002-97-1	0.01155%	0.00173%	
			Sorbitan monooleate	1338-43-8	0.01005%	0.00151%	

9-00149

Acrylamide/ammonium acrylate copolymer	26100-47-0	0.00773%	0.00116%	
Thiocyanic acid, ammonium salt	1762-95-4	0.00560%	0.00084%	
Acrylamide, 2-acrylamido-2-methylpropanesulfonic acid, sodium salt polymer	38193-60-1	0.00535%	0.00080%	
Poly(oxyethylene) sorbitol monostearate	9005-67-8	0.00530%	0.00080%	
Ammonium sulfate	7783-20-2	0.00506%	0.00076%	
Ammonium chloride	12125-02-9	0.00483%	0.00072%	
Sodium erythorbate	6381-77-7	0.00393%	0.00059%	
Methanol	67-56-1	0.00372%	0.00056%	
Fatty acids, tall-oil	61790-12-3	0.00273%	0.00041%	
Diammonium peroxidisulphate	7727-54-0	0.00228%	0.00034%	
Thiourea, polymer with formaldehyde and 1-phenylethanone	68527-49-1	0.00225%	0.00034%	
Sodium sulfate	7757-82-6	0.00219%	0.00033%	
Alcohols, C14-15, ethoxylated (7EO)	68951-67-7	0.00105%	0.00016%	
Ethoxylated oleic acid	9004-96-0	0.00097%	0.00014%	
Prop-2-yn-1-ol	107-19-7	0.00070%	0.00010%	
Polymer of 2-acrylamido-2-methylpropanesulfonic acid sodium salt and methyl acrylate	136793-29-8	0.00057%	0.00009%	
Alkenes, C>10 a-	64743-02-8	0.00046%	0.00007%	
Urea	57-13-6	0.00035%	0.00005%	
Sorbitol Tetraoleate	61723-83-9	0.00029%	0.00004%	
Sodium sulfocyanate	540-72-7	0.00025%	0.00004%	
2-Propenoic acid, ammonium salt	10604-69-0	0.00024%	0.00004%	
Non-crystalline silica	7631-86-9	0.00016%	0.00002%	
Alcohols, C12-C14, ethoxylated	68439-50-9	0.00014%	0.00002%	
Alcohols, C12-C16, ethoxylated	68551-12-2	0.00014%	0.00002%	
C14 alpha olefin ethoxylate	84133-50-6	0.00014%	0.00002%	
Tetrasodium ethylenediaminetetraacetate	64-02-8	0.00008%	0.00001%	
2-propenamid	79-06-1	0.00004%	0.00001%	
Dimethyl siloxanes and silicones	63148-62-9	0.00001%	< 0.00001%	
Siloxanes and Silicones, di-Me, reaction products with silica	67762-90-7	< 0.00001%	< 0.00001%	
Octamethylcyclotetrasiloxane	556-67-2	< 0.00001%	< 0.00001%	
Sodium hydroxide	1310-73-2	< 0.00001%	< 0.00001%	
Decamethyl cyclopentasiloxane	541-02-6	< 0.00001%	< 0.00001%	
Dodecamethylcyclohexasiloxane	540-97-6	< 0.00001%	< 0.00001%	

RECEIVED
Office of Oil and Gas

FEB 27 2015

ENVIRONMENTAL PROTECTION
Department of

Additional Ingredients Not Listed on MSDS

9-00149 EC6110A, EC6629A	NALCO	Anti-Bacterial Agent, Scale Inhibitor	Methanol (Methyl Alcohol)	000067-56-1	0.00607%	
			Proprietary Acrylate Polymer	TRADE SECRET	0.00607%	
			Proprietary Quaternary Ammonium Salt	TRADE SECRET	0.00607%	
			Water	007732-18-5	0.02636%	

Received
 Office of Oil & Gas
 FEB 27 2015

* Total Water Volume sources may include fresh water, produced water, and/or recycled water
 ** Information is based on the maximum potential for concentration and thus the total may be over 100%

"Additional Ingredients Not Listed on MSDS" component information were obtained directly from the supplier. As such, the Operator is not responsible for inaccurate and/or incomplete information. Any questions regarding the content of this information should be directed to the supplier who provided it.

RECEIVED
 Office of Oil and Gas

FEB 27 2015

WV Department of
 Environmental Protection