

Thurman Speece BRK 3H
Brooke County, WV
Quail 9

Plan vs Actual

Plan Data for Thurman Speece BRK 3H

DogLeg Severity Unit: 0/100.00ft

MD (USft)	Inc (°)	Az (°)	TVD (USft)	+N/-S (USft)	+E/-W (USft)	VSec (USft)	Position offsets from Slot centre (DLSU)	DLS Toolface Comments
16473.72	90.71	337.47	5841.00	10229.99	-3952.54	10967.01	0.00	0.0 PBHL T53H

Target Set Information:
Name: Thurman Speece BRK 3H
Position offsets from Slot centre
Name TVD +N/-S +E/-W Northing Easting Lat Long
LP T53H 5965.00 705.28 -0.65 14596748.85 1754878.67 40.191547 -88.590135
PBHL T53H 5841.00 10229.99 -3952.54 14606273.56 1750926.78 40.217751 -88.604133

Plan Data for Thurman Speece BRK 3H

Field: SOUTHWESTERN_BROOKE CO, WV UTM NAD 83 (17N)
Map Unit: USFT
Projected Coordinate System: NAD83 / UTM zone 17N

Site: Thurman Speece BRK Pad
Unit: USFeet
Company Name: SOUTHWESTERN ENERGY
Northing: 14596029.99USft Latitude: 40.189573°
Easting: 1754875.81USft Longitude: -88.590157°
North Reference: Grid Grid Convergence: 0.26°
Elevation Above VRD: 1139.50USft

Slot: Thurman Speece BRK 3H
Position:
Offset is from Site centre
+N/-S: 13.58USft Northing: 14596043.57USft Latitude: 40.189610°
+E/-W: 3.51USft Easting: 1754879.32USft Longitude: -88.590144°
Elevation Above VRD: 1139.50USft

Well: Thurman Speece BRK 3H
Type: Main-Well
File Number:
Plan Folder: P2
Plan: P2:V3
Vertical Section: Position offset of origin from Slot centre:
+N/-S: -0.00USft
+E/-W: -0.00USft
Azimuth: 338.88°
Date: 2017-08-11

Magnetic Parameters:
Model: HDGM
Field Strength: 52680(nT)
Dip: 67.67°
Declination: -8.28°





Plan Data for Thurman Speece BRK 3H

Formation Point Information:

Name	TVD (USft)	TVD SS (USft)	MD (USft)
Onondaga Limestone	-4824.00	0.00	-1.00
Base of Fresh Water	263.50	902.00	263.50
Pittsburgh Coal	342.50	823.00	342.51
Top of Salt Water	645.50	520.00	645.53
Maxton	1168.50	5.00	1161.19
Big Lime	1325.50	-160.00	1326.51
Big Injun	1518.50	-353.00	1520.02
Base Big Injun	1633.50	-468.00	1635.24
Berea	1972.50	-807.00	1974.70
Upper Rhinestreet	5418.50	-4253.00	5433.06
Lower Rhinestreet	5525.50	-4360.00	5549.00
Basal Rhinestreet	5586.50	-4421.00	5619.00
Cashoga	5656.50	-4491.00	5704.00
Middlesex	5706.50	-4541.00	5769.00
Lower Middlesex	5730.50	-4565.00	5802.00
Burket	5768.50	-4603.00	5857.00
Tully	5784.50	-4619.00	5881.00
Mahantango	5838.50	-4673.00	5970.00
Levanna	5937.50	-4772.00	6196.00
Upper Marcellus	5947.50	-4782.00	6232.00

Drawing By: Gary Rhodes
Office Name: MidCon DS
Address: 7725 W. Reno Ave, Ste. #220
Oklahoma City, OK 73127
Phone: +1.405.720.4257
Date: 29 October 2017

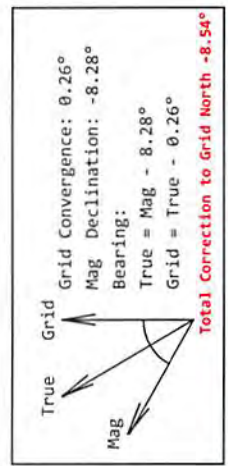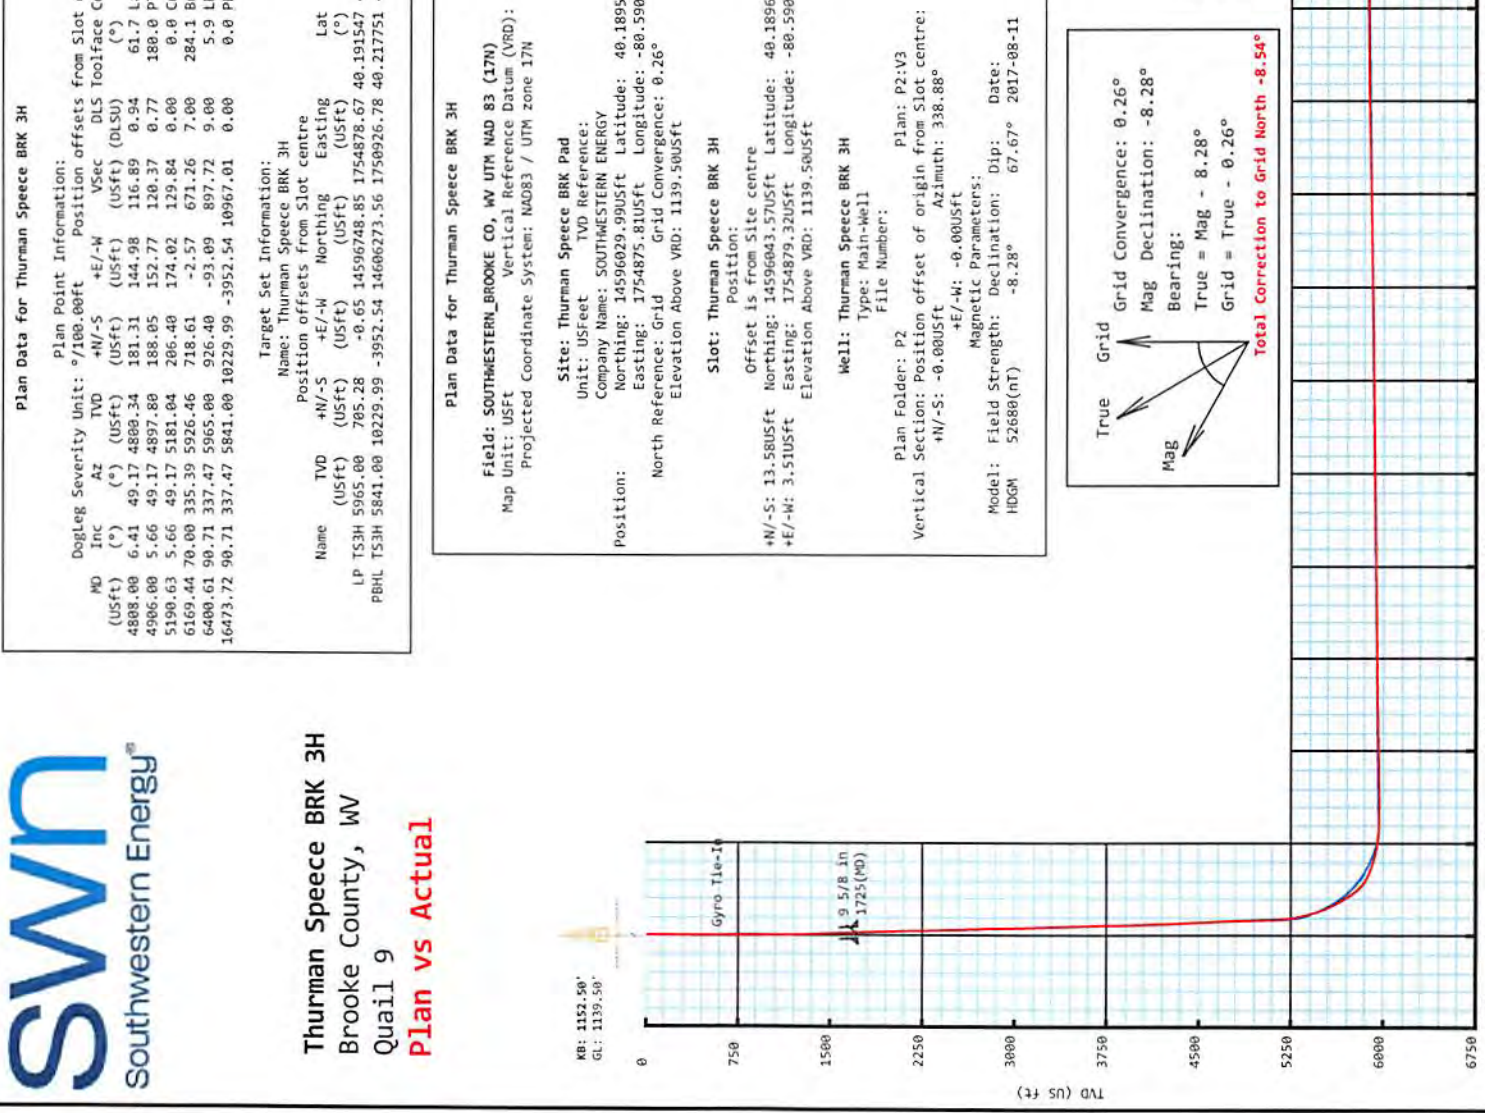

Thurman Speece BRK 3H

	Map Units: US ft	Company Name: SOUTHWESTERN ENERGY
Field Name:	Vertical Reference Datum (VRD):	
SOUTHWESTER N BROOKE CO, WV UTM NAD 83 (17N)	Projected Coordinate System: NAD83 / UTM zone 17N	
	Comment:	
Site:	Units: US ft	North Reference: Grid
	Position:	Convergence Angle: 0.26
	Easting: 1754875.81 US ft	Latitude: 40.189573
	Longitude: -80.590157	
Thurman Speece BRK Pad	Elevation above Field Reference: 1139.50 US ft	
	Comment:	
Slot:	Position (Relative to Site Centre)	
	+N/-S: 13.58 US ft	Northing: 14596043.57 US ft
	+E/-W: 3.51 US ft	Latitude: 40.189610
	Easting: 1754879.32 US ft	Longitude: -80.590144
Thurman Speece BRK 3H	Elevation above Field Reference: 1139.50 US ft	
	Comment:	
Well:	Type: Main well	UWI:
	File Number:	Comment:
Thurman Speece BRK 3H	Closure Distance: 10964.5 US ft	Closure Azimuth: 338.87°
	Vertical Section: Position of Origin (Relative to Slot centre)	
	+N/-S: -0.00 US ft	+E/-W: -0.00 US ft
		Az: 338.88°

Drill floor: Survey Name: Definitive Survey			
Rig Height (Drill Floor): 26.00 US ft	Elevation above Field Reference: 1165.50 US ft	Inclination: 0.00°	Azimuth: 0.00°

Survey Name: Definitive Survey

Date: 10/Aug/2017	Survey Tool: See Survey Tool Ranges below.	Comment:	Company:
--------------------------	--	-----------------	-----------------

Magnetic Model:

Model Name: HDGM	Date: 11/Aug/2017	Field Strength: 52680.0nT	Declination: -8.28°	Dip: 67.67°
-------------------------	--------------------------	-------------------------------------	----------------------------	--------------------

Tie Point:

MD: 0.00 US ft	Inclination: 0.00°	Azimuth: 0.00°	TVD: -0.00 US ft	North Offset: 0.00 US ft	East Offset: 0.00 US ft
-----------------------	------------------------------	-----------------------	----------------------------	---------------------------------	-----------------------------------

Survey Tool Ranges:

Name	Start MD(USFt)	End MD(USFt)	Source Survey
GYRO-NS_OW	0.00	614.00	Gyro_01
MWD	614.00	1635.00	WFT MWD_02
MWD	1635.00	4808.00	WFT MWD_03
MWD	4808.00	5814.00	WFT MWD_04
MWD	5814.00	6465.00	WFT MWD_05
MWD	6465.00	16505.00	WFT MWD_06

Wellpath created using minimum curvature.

RECEIVED
Office of Oil and Gas
MAY 23 2018
WV Department of
Environmental Protection

50 Survey Report

Survey Points: (Relative to Slot centre)(TVD relative to Drill Floor)											Comment
MD (US ft)	Inc (°)	Az (°)	TVD (US ft)	VS (US ft)	N. Offset (US ft)	E. Offset (US ft)	Latitude (° '' ''')	Longitude (° '' ''')	DLS (°/100US ft)		
0.00	0.00	0.00	-0.00	0.00	0.00	0.00	40.189610	-80.590144	0.00		
26.00	0.31	328.81	26.00	0.07	0.06	-0.04	40.189610	-80.590144	1.19		
113.00	0.38	259.25	113.00	0.35	0.21	-0.44	40.189611	-80.590145	0.46		
213.00	0.40	173.13	213.00	0.07	-0.20	-0.73	40.189610	-80.590147	0.53		
263.50	0.45	174.58	263.50	-0.29	-0.57	-0.69	40.189609	-80.590146	0.10	Base of Fresh Water :	
308.00	0.49	175.63	307.99	-0.64	-0.93	-0.66	40.189608	-80.590146	0.10		
342.51	0.32	133.50	342.50	-0.86	-1.15	-0.57	40.189607	-80.590146	0.96	Pittsburgh Coal ;	
349.00	0.32	122.36	348.99	-0.90	-1.17	-0.55	40.189607	-80.590146	0.96		
396.00	0.18	115.75	395.99	-1.06	-1.27	-0.37	40.189607	-80.590145	0.30		
438.00	0.61	150.78	437.99	-1.32	-1.50	-0.20	40.189606	-80.590145	1.13		
481.00	0.29	120.30	480.99	-1.64	-1.75	0.01	40.189605	-80.590144	0.90		
526.00	0.46	126.92	525.99	-1.88	-1.92	0.25	40.189605	-80.590143	0.39		
572.00	0.68	121.82	571.99	-2.25	-2.17	0.63	40.189604	-80.590142	0.49		
614.00	0.68	112.87	613.98	-2.63	-2.40	1.07	40.189604	-80.590140	0.25	Gyro Tie-In	
641.00	1.28	115.04	640.98	-2.95	-2.59	1.49	40.189603	-80.590139	2.23		
645.53	1.31	114.06	645.51	-3.03	-2.63	1.58	40.189603	-80.590138	0.80	Top of Salt Water :	
685.00	1.57	107.09	684.97	-3.68	-2.98	2.51	40.189602	-80.590135	0.80		
729.00	1.76	92.48	728.95	-4.32	-3.18	3.76	40.189601	-80.590130	1.05		
773.00	1.93	74.54	772.93	-4.67	-3.01	5.15	40.189602	-80.590126	1.36		
817.00	2.43	65.69	816.89	-4.69	-2.43	6.72	40.189603	-80.590120	1.37		
861.00	2.65	60.27	860.85	-4.49	-1.54	8.45	40.189606	-80.590114	0.74		
905.00	2.84	59.53	904.80	-4.16	-0.49	10.27	40.189609	-80.590107	0.44		
994.00	3.39	54.37	993.67	-3.14	2.16	14.31	40.189616	-80.590093	0.69		
1081.00	3.96	52.44	1080.49	-1.64	5.49	18.78	40.189625	-80.590077	0.67		
1161.19	3.63	45.11	1160.50	0.16	8.98	22.78	40.189635	-80.590062	0.73	Maxton :	
1168.00	3.61	44.43	1167.30	0.34	9.28	23.08	40.189635	-80.590061	0.73		
1255.00	3.64	34.50	1254.13	3.03	13.51	26.56	40.189647	-80.590049	0.72		
1326.51	3.90	29.93	1325.48	5.84	17.49	29.06	40.189658	-80.590040	0.56	Big Lime :	
1342.00	3.96	29.02	1340.94	6.52	18.42	29.59	40.189660	-80.590038	0.56		
1431.00	4.67	28.81	1429.68	10.82	24.28	32.82	40.189676	-80.590026	0.80		
1519.00	4.03	35.90	1517.43	14.81	29.92	36.36	40.189692	-80.590013	0.95		
1520.02	4.02	35.95	1518.45	14.85	29.98	36.41	40.189692	-80.590013	0.92	Big Injun :	
1607.00	3.29	40.96	1605.25	17.68	34.33	39.83	40.189704	-80.590001	0.92		
1635.00	3.34	39.12	1633.20	18.46	35.57	40.87	40.189707	-80.589997	0.42		
1635.24	3.34	39.12	1633.44	18.46	35.58	40.88	40.189707	-80.589997	0.10	Base Big Injun :	
1725.00	3.42	39.79	1723.05	21.06	39.67	44.25	40.189719	-80.589985	0.10	9 5/8 in	
1732.00	3.43	39.84	1730.03	21.27	39.99	44.51	40.189719	-80.589984	0.10		
1820.00	3.25	38.97	1817.88	23.79	43.95	47.77	40.189730	-80.589972	0.21		
1908.00	2.70	30.75	1905.77	26.31	47.67	50.40	40.189740	-80.589963	0.79		
1974.70	2.06	23.16	1972.41	28.14	50.13	51.67	40.189747	-80.589958	1.06	Berea :	
1996.00	1.87	19.67	1993.70	28.68	50.81	51.94	40.189749	-80.589957	1.06		
2084.00	1.70	15.09	2081.65	30.82	53.42	52.76	40.189756	-80.589954	0.25		
2171.00	1.60	11.14	2168.62	32.89	55.86	53.34	40.189763	-80.589952	0.17		
2258.00	1.65	9.27	2255.58	35.00	58.29	53.77	40.189770	-80.589950	0.08		
2346.00	1.86	14.57	2343.54	37.25	60.92	54.34	40.189777	-80.589948	0.30		
2434.00	1.83	12.28	2431.49	39.58	63.67	54.99	40.189784	-80.589946	0.09		
2523.00	2.47	24.59	2520.43	42.11	66.81	56.09	40.189793	-80.589942	0.88		
2655.00	3.48	29.96	2652.25	46.61	72.86	59.28	40.189810	-80.589930	0.79		
2699.00	3.34	28.32	2696.17	48.28	75.15	60.55	40.189816	-80.589926	0.39		
2787.00	3.33	39.12	2784.03	51.22	79.39	63.38	40.189827	-80.589916	0.71		
2875.00	3.27	40.69	2871.88	53.67	83.27	66.63	40.189838	-80.589904	0.12		
2961.00	3.20	38.86	2957.74	56.03	87.00	69.74	40.189848	-80.589893	0.15		
3047.00	2.93	35.81	3043.62	58.43	90.66	72.53	40.189858	-80.589883	0.37		
3136.00	2.71	31.44	3132.51	60.95	94.29	74.96	40.189868	-80.589874	0.35		
3223.00	3.08	40.63	3219.40	63.31	97.82	77.55	40.189878	-80.589865	0.68		
3311.00	2.92	40.33	3307.28	65.50	101.33	80.54	40.189887	-80.589854	0.18		

RECEIVED
Office of Oil and Gas
MAY 23 2018
WV Department of
Environmental Protection

5D Survey Report

Survey Points: (Relative to Slot centre)(TVD relative to Drill Floor)										
MD (US ft)	Inc (°)	Az (°)	TVD (US ft)	VS (US ft)	N.Offset (US ft)	E.Offset (US ft)	Latitude (° ' ")	Longitude (° ' ")	DLS (°/100US ft)	Comment
3399.00	2.69	36.44	3395.18	67.68	104.70	83.22	40.189897	-80.589844	0.34	
3488.00	2.42	32.99	3484.09	69.90	107.95	85.48	40.189906	-80.589836	0.35	
3575.00	3.07	33.31	3570.99	72.33	111.44	87.76	40.189915	-80.589828	0.75	
3663.00	2.90	31.61	3658.87	75.05	115.31	90.22	40.189926	-80.589819	0.22	
3751.00	3.39	44.72	3746.74	77.46	119.05	93.22	40.189936	-80.589808	0.99	
3839.00	3.06	45.81	3834.60	79.45	122.54	96.73	40.189945	-80.589796	0.38	
3928.00	2.78	44.06	3923.48	81.29	125.74	99.94	40.189954	-80.589784	0.33	
4016.00	2.91	39.86	4011.37	83.27	128.99	102.85	40.189963	-80.589773	0.28	
4104.00	3.68	34.10	4099.23	85.96	133.04	105.87	40.189974	-80.589763	0.95	
4192.00	3.41	30.00	4187.06	89.21	137.65	108.76	40.189987	-80.589752	0.42	
4281.00	3.69	31.96	4275.89	92.60	142.37	111.60	40.190000	-80.589742	0.34	
4369.00	4.93	35.35	4363.64	96.39	147.86	115.29	40.190015	-80.589729	1.44	
4456.00	5.81	39.96	4450.25	100.58	154.28	120.28	40.190032	-80.589711	1.13	
4544.00	5.95	38.75	4537.79	105.02	161.25	125.99	40.190051	-80.589690	0.21	
4633.00	5.89	43.25	4626.32	109.31	168.18	132.01	40.190070	-80.589668	0.53	
4721.00	5.98	42.69	4713.85	113.29	174.84	138.21	40.190089	-80.589646	0.12	
4808.00	6.41	49.17	4800.34	116.93	181.34	144.96	40.190106	-80.589622	0.94	
4903.00	6.35	57.17	4894.75	119.78	187.66	153.39	40.190124	-80.589592	0.94	
4998.00	4.00	50.50	4989.36	121.89	192.61	160.36	40.190137	-80.589567	2.55	
5094.00	3.53	40.06	5085.15	124.38	197.01	164.85	40.190149	-80.589550	0.86	
5145.00	4.42	30.44	5136.03	126.35	199.90	166.85	40.190157	-80.589543	2.17	
5189.00	7.33	25.71	5179.79	129.33	203.89	168.93	40.190168	-80.589536	6.70	
5237.00	9.68	21.15	5227.26	134.41	210.42	171.71	40.190186	-80.589526	5.09	
5286.00	11.48	12.10	5275.43	141.54	219.03	174.22	40.190209	-80.589516	4.99	
5334.00	12.81	353.67	5322.37	150.68	228.99	174.64	40.190237	-80.589515	8.50	
5382.00	14.25	338.96	5369.06	161.74	239.80	171.93	40.190267	-80.589524	7.75	
5430.00	16.50	336.36	5415.34	174.46	251.56	167.07	40.190299	-80.589542	4.90	
5432.69	16.63	336.59	5417.91	175.23	252.26	166.77	40.190301	-80.589543	5.38	Upper Rhinestreet :
5479.00	18.88	340.11	5462.02	189.34	265.39	161.59	40.190337	-80.589561	5.38	
5527.00	21.42	343.86	5507.08	205.84	281.12	156.51	40.190380	-80.589579	5.93	
5546.08	22.48	344.50	5524.78	212.94	287.98	154.56	40.190399	-80.589586	5.71	Lower Rhinestreet :
5575.00	24.10	345.37	5551.34	224.31	299.02	151.59	40.190429	-80.589596	5.71	
5612.96	26.31	346.56	5585.68	240.35	314.71	147.68	40.190473	-80.589610	5.98	Basal Rhinestreet :
5623.00	26.90	346.84	5594.66	244.81	319.08	146.64	40.190485	-80.589614	5.98	
5671.00	29.52	347.91	5636.95	267.24	341.22	141.69	40.190545	-80.589631	5.56	
5692.51	30.75	348.08	5655.55	277.91	351.78	139.45	40.190574	-80.589639	5.74	Cashaqua :
5719.00	32.27	348.28	5678.14	291.57	365.34	136.61	40.190612	-80.589649	5.74	
5751.67	34.31	348.90	5705.44	309.24	382.91	133.07	40.190660	-80.589661	6.32	Middlesex :
5766.00	35.20	349.15	5717.22	317.28	390.93	131.51	40.190682	-80.589667	6.32	
5780.97	36.14	349.70	5729.38	325.87	399.51	129.91	40.190706	-80.589672	6.65	Lower Middlesex :
5814.00	38.23	350.83	5755.69	345.43	419.19	126.54	40.190760	-80.589684	6.65	
5828.86	39.24	350.31	5767.28	354.54	428.36	125.02	40.190785	-80.589689	7.11	Burket :
5841.00	40.06	349.91	5776.63	362.14	435.99	123.69	40.190806	-80.589694	7.11	
5849.71	41.23	349.69	5783.24	367.70	441.57	122.68	40.190821	-80.589697	13.50	Tully :
5873.00	44.35	349.15	5800.33	383.26	457.12	119.78	40.190864	-80.589707	13.50	
5905.00	49.16	347.56	5822.25	406.24	479.94	115.06	40.190927	-80.589724	15.46	
5928.43	52.50	346.86	5837.04	424.21	497.65	111.04	40.190975	-80.589738	14.46	Mahantango :
5937.00	53.73	346.62	5842.19	431.01	504.32	109.47	40.190994	-80.589744	14.46	
5985.00	60.77	342.95	5868.14	471.13	543.23	98.83	40.191101	-80.589781	16.01	
6034.00	66.47	339.69	5889.91	514.96	584.78	84.75	40.191215	-80.589831	13.07	
6082.00	70.11	336.29	5907.67	559.54	626.11	68.03	40.191329	-80.589890	10.04	
6129.00	73.37	334.36	5922.39	604.08	666.65	49.39	40.191440	-80.589956	7.96	
6177.00	76.00	336.98	5935.07	650.29	708.83	30.33	40.191556	-80.590024	7.60	
6177.73	76.03	336.98	5935.25	651.00	709.48	30.05	40.191558	-80.590025	4.09	WV Department of Environmental Protection Levanna :
6221.26	77.81	337.07	5945.10	693.37	748.52	13.50	40.191665	-80.590083	4.09	Upper Marcellus :

RECEIVED
Office of Oil and Gas
MAY 23 2018
WV Department of
Environmental Protection
Levanna :

5D Survey Report

Survey Points: (Relative to Slot centre)(TVD relative to Drill Floor)										
MD (US ft)	Inc (°)	Az (°)	TVD (US ft)	VS (US ft)	N.Offset (US ft)	E.Offset (US ft)	Latitude (° ' ")	Longitude (° ' ")	DLS (%/100US ft)	Comment
6225.00	77.96	337.08	5945.89	697.03	751.89	12.08	40.191675	-80.590088	4.09	
6257.00	79.27	337.16	5952.20	728.38	780.79	-0.12	40.191754	-80.590131	4.10	
6289.00	81.46	336.45	5957.56	759.91	809.79	-12.54	40.191834	-80.590175	7.18	
6322.00	83.57	334.46	5961.86	792.57	839.54	-26.13	40.191916	-80.590224	8.75	
6370.00	88.52	335.21	5965.17	840.32	882.87	-46.49	40.192035	-80.590296	10.43	
6417.00	89.82	332.76	5965.85	887.14	925.10	-67.10	40.192151	-80.590369	5.90	
6465.00	89.14	332.52	5966.28	934.85	967.73	-89.16	40.192269	-80.590447	1.50	
6536.00	88.27	332.05	5967.89	1005.36	1030.57	-122.17	40.192442	-80.590564	1.39	
6632.00	90.86	332.81	5968.62	1100.74	1115.65	-166.60	40.192676	-80.590722	2.81	
6728.00	91.05	334.00	5967.02	1196.29	1201.48	-209.57	40.192912	-80.590874	1.26	
6824.00	90.80	334.78	5965.47	1291.98	1288.04	-251.06	40.193150	-80.591022	0.85	
6921.00	91.11	335.39	5963.85	1388.75	1376.00	-291.91	40.193392	-80.591166	0.71	
7007.00	90.93	335.32	5962.32	1474.58	1454.15	-327.77	40.193608	-80.591294	0.22	
7094.00	90.86	335.09	5960.96	1561.39	1533.12	-364.25	40.193825	-80.591423	0.28	
7181.00	90.86	336.10	5959.66	1648.23	1612.34	-400.19	40.194043	-80.591550	1.16	
7268.00	91.17	339.84	5958.11	1735.19	1692.96	-432.82	40.194265	-80.591666	4.31	
7354.00	91.17	340.26	5956.36	1821.16	1773.78	-462.15	40.194487	-80.591769	0.49	
7441.00	91.05	341.44	5954.67	1908.09	1855.95	-490.69	40.194713	-80.591870	1.36	
7527.00	91.05	340.93	5953.10	1994.00	1937.34	-518.42	40.194937	-80.591968	0.97	
7613.00	90.74	340.01	5951.75	2079.96	2018.38	-547.16	40.195160	-80.592070	1.13	
7700.00	90.68	338.77	5950.68	2166.95	2099.81	-577.79	40.195384	-80.592178	1.43	
7787.00	90.80	339.02	5949.55	2253.94	2180.97	-609.11	40.195607	-80.592289	0.32	
7873.00	90.80	339.10	5948.35	2339.93	2261.28	-639.84	40.195828	-80.592398	0.09	
7960.00	90.74	338.08	5947.18	2426.92	2342.27	-671.60	40.196051	-80.592510	1.17	
8047.00	90.62	338.39	5946.15	2513.91	2423.06	-703.85	40.196273	-80.592624	0.38	
8134.00	90.71	338.94	5945.14	2600.90	2504.09	-735.50	40.196496	-80.592736	0.64	
8220.00	90.25	338.17	5944.42	2686.90	2584.13	-766.95	40.196716	-80.592848	1.04	
8307.00	90.31	336.92	5943.99	2773.87	2664.53	-800.17	40.196937	-80.592965	1.44	
8394.00	90.49	336.14	5943.39	2860.80	2744.33	-834.82	40.197157	-80.593088	0.92	
8481.00	90.74	336.72	5942.45	2947.71	2824.07	-869.61	40.197376	-80.593211	0.73	
8567.00	90.68	338.45	5941.39	3033.68	2903.56	-902.40	40.197595	-80.593327	2.01	
8654.00	90.49	338.76	5940.50	3120.67	2984.56	-934.13	40.197818	-80.593440	0.42	
8741.00	90.49	334.84	5939.75	3207.60	3064.51	-968.40	40.198038	-80.593561	4.51	
8827.00	90.55	334.26	5938.97	3293.35	3142.16	-1005.35	40.198251	-80.593692	0.68	
8914.00	90.80	336.51	5937.95	3380.17	3221.24	-1041.59	40.198469	-80.593821	2.60	
9001.00	90.92	337.65	5936.64	3467.12	3301.37	-1075.46	40.198689	-80.593941	1.32	
9090.00	90.86	337.65	5935.26	3556.09	3383.67	-1109.30	40.198916	-80.594060	0.07	
9179.00	90.93	339.35	5933.87	3645.07	3466.46	-1141.92	40.199144	-80.594176	1.91	
9265.00	90.80	339.86	5932.57	3731.05	3547.06	-1171.88	40.199365	-80.594282	0.61	
9352.00	90.93	338.40	5931.26	3818.04	3628.34	-1202.87	40.199589	-80.594392	1.68	
9439.00	90.92	336.36	5929.85	3905.00	3708.64	-1236.33	40.199810	-80.594510	2.34	
9526.00	90.86	334.94	5928.50	3991.84	3787.89	-1272.19	40.200028	-80.594637	1.63	
9615.00	90.80	334.38	5927.21	4080.59	3868.31	-1310.28	40.200249	-80.594772	0.63	
9702.00	90.80	335.62	5926.00	4167.38	3947.15	-1347.04	40.200466	-80.594903	1.43	
9788.00	90.80	336.34	5924.80	4253.27	4025.70	-1382.05	40.200682	-80.595027	0.84	
9875.00	90.80	336.09	5923.58	4340.16	4105.30	-1417.13	40.200901	-80.595151	0.29	
9962.00	90.80	335.95	5922.37	4427.05	4184.78	-1452.49	40.201120	-80.595276	0.16	
10049.00	90.99	336.95	5921.01	4513.96	4264.53	-1487.24	40.201339	-80.595400	1.17	
10136.00	90.62	338.77	5919.79	4600.93	4345.10	-1520.03	40.201561	-80.595516	2.13	
10222.00	90.55	338.77	5918.91	4686.92	4425.26	-1551.17	40.201782	-80.595626	0.08	
10309.00	90.49	338.93	5918.12	4773.92	4506.40	-1582.55	40.202005	-80.595737	0.20	
10396.00	90.80	338.76	5917.14	4860.92	4587.53	-1613.95	40.202228	-80.595848	0.41	
10483.00	90.62	339.76	5916.06	4947.91	4668.88	-1644.76	40.202452	-80.595957	1.17	
10569.00	90.56	339.76	5915.18	5033.89	4749.57	-1674.51	40.202674	-80.596062	0.07	
10656.00	91.17	337.18	5913.86	5120.87	4830.48	-1706.43	40.202896	-80.596175	3.05	
10744.00	90.99	337.47	5912.20	5208.82	4911.66	-1740.35	40.203120	-80.596295	0.39	
10831.00	90.86	338.81	5910.80	5295.80	4992.40	-1772.73	40.203342	-80.596410	1.55	
10918.00	90.97	338.94	5909.41	5382.79	5073.54	-1804.09	40.203565	-80.596521	0.20	
11005.00	90.86	338.57	5908.02	5469.78	5154.62	-1835.61	40.203788	-80.596633	0.44	

RECEIVED
Office of Oil and Gas
MAY 23 2018
WV Department of
Environmental Protection

5D Survey Report

Survey Points: (Relative to Slot centre)(TVD relative to Drill Floor)										
MD (US ft)	Inc (°)	Az (°)	TVD (US ft)	VS (US ft)	N.Offset (US ft)	E.Offset (US ft)	Latitude (° ' ")	Longitude (° ' ")	DLS (#/100US ft)	Comment
11091.00	91.05	337.02	5906.59	5555.75	5234.22	-1868.10	40.204007	-80.596748	1.82	
11178.00	90.71	335.77	5905.25	5642.66	5313.93	-1902.94	40.204226	-80.596871	1.49	
11265.00	90.92	335.28	5904.01	5729.50	5393.11	-1938.98	40.204444	-80.596999	0.61	
11352.00	90.93	335.37	5902.61	5816.32	5472.15	-1975.29	40.204662	-80.597128	0.10	
11438.00	90.86	335.70	5901.27	5902.16	5550.42	-2010.90	40.204877	-80.597254	0.39	
11525.00	90.99	336.15	5899.86	5989.03	5629.84	-2046.39	40.205096	-80.597380	0.54	
11612.00	90.99	337.88	5898.36	6075.97	5709.92	-2080.35	40.205316	-80.597500	1.99	
11698.00	90.88	337.71	5896.95	6161.95	5789.53	-2112.85	40.205535	-80.597615	0.24	
11785.00	90.92	337.94	5895.59	6248.92	5870.09	-2145.68	40.205757	-80.597732	0.27	
11872.00	90.97	339.47	5894.15	6335.91	5951.14	-2177.27	40.205980	-80.597843	1.76	
11959.00	91.05	340.86	5892.62	6422.87	6032.96	-2206.79	40.206205	-80.597948	1.60	
12045.00	91.11	341.34	5891.00	6508.79	6114.31	-2234.64	40.206428	-80.598046	0.56	
12132.00	90.93	341.14	5889.45	6595.70	6196.67	-2262.62	40.206655	-80.598145	0.31	
12219.00	91.05	338.90	5887.95	6682.66	6278.42	-2292.34	40.206880	-80.598250	2.58	
12306.00	90.93	337.31	5886.44	6769.64	6359.13	-2324.77	40.207102	-80.598365	1.83	
12393.00	90.88	336.83	5885.07	6856.59	6439.24	-2358.67	40.207322	-80.598485	0.55	
12479.00	90.92	335.37	5883.72	6942.47	6517.86	-2393.50	40.207538	-80.598609	1.70	
12566.00	90.88	334.18	5882.35	7029.24	6596.55	-2430.57	40.207755	-80.598740	1.37	
12653.00	90.88	334.54	5881.02	7115.96	6674.97	-2468.22	40.207971	-80.598874	0.41	
12740.00	90.62	332.90	5879.88	7202.59	6752.97	-2506.73	40.208186	-80.599010	1.91	
12827.00	90.62	333.48	5878.93	7289.16	6830.62	-2545.97	40.208399	-80.599150	0.67	
12913.00	90.44	335.77	5878.14	7374.91	6908.31	-2582.82	40.208613	-80.599280	2.67	
13000.00	90.86	338.31	5877.15	7461.85	6988.41	-2616.75	40.208833	-80.599401	2.96	
13087.00	90.56	339.33	5876.07	7548.85	7069.52	-2648.18	40.209057	-80.599512	1.22	
13174.00	90.56	339.41	5875.22	7635.84	7150.94	-2678.83	40.209280	-80.599620	0.09	
13260.00	90.62	339.32	5874.34	7721.83	7231.42	-2709.14	40.209502	-80.599728	0.13	
13347.00	90.31	339.14	5873.63	7808.83	7312.76	-2739.99	40.209726	-80.599837	0.41	
13434.00	90.35	339.30	5873.13	7895.82	7394.10	-2770.86	40.209949	-80.599946	0.19	
13521.00	90.37	339.17	5872.58	7982.82	7475.45	-2801.70	40.210173	-80.600055	0.15	
13607.00	90.49	338.51	5871.94	8068.82	7555.65	-2832.74	40.210394	-80.600165	0.78	
13693.00	90.55	337.64	5871.16	8154.80	7635.42	-2864.85	40.210613	-80.600279	1.01	
13780.00	90.37	337.51	5870.46	8241.78	7715.84	-2898.04	40.210834	-80.600396	0.26	
13867.00	91.11	339.22	5869.34	8328.76	7796.70	-2930.11	40.211057	-80.600510	2.14	
13954.00	90.99	338.87	5867.74	8415.75	7877.93	-2961.22	40.211280	-80.600620	0.43	
14041.00	90.68	338.24	5866.47	8502.74	7958.90	-2993.02	40.211503	-80.600733	0.81	
14128.00	90.80	337.84	5865.35	8589.72	8039.58	-3025.56	40.211725	-80.600848	0.48	
14214.00	90.62	336.99	5864.28	8675.69	8118.98	-3058.58	40.211943	-80.600965	1.01	
14301.00	90.62	334.54	5863.34	8762.55	8198.30	-3094.29	40.212162	-80.601091	2.82	
14387.00	90.44	333.30	5862.55	8848.22	8275.54	-3132.09	40.212374	-80.601226	1.46	
14474.00	90.19	333.55	5862.07	8934.82	8353.35	-3171.01	40.212588	-80.601364	0.41	
14562.00	90.31	334.70	5861.69	9022.52	8432.52	-3209.42	40.212806	-80.601500	1.31	
14649.00	90.31	336.36	5861.21	9109.36	8511.70	-3245.45	40.213024	-80.601628	1.91	
14736.00	90.68	337.88	5860.46	9196.32	8591.85	-3279.28	40.213245	-80.601748	1.80	
14822.00	90.49	339.25	5859.58	9282.31	8671.90	-3310.70	40.213465	-80.601859	1.61	
14909.00	90.37	339.16	5858.93	9369.31	8753.23	-3341.59	40.213689	-80.601968	0.17	
14996.00	90.56	339.61	5858.23	9456.30	8834.66	-3372.22	40.213913	-80.602077	0.56	
15082.00	90.37	338.82	5857.53	9542.29	8915.06	-3402.74	40.214134	-80.602185	0.94	
15169.00	90.43	338.21	5856.92	9629.29	8996.01	-3434.60	40.214356	-80.602298	0.70	
15255.00	90.68	335.87	5856.09	9715.24	9075.19	-3468.14	40.214574	-80.602416	2.74	
15342.00	90.62	335.69	5855.10	9802.10	9154.52	-3503.83	40.214793	-80.602543	0.22	
15429.00	90.62	336.97	5854.16	9889.01	9234.20	-3538.76	40.215012	-80.602667	1.47	
15515.00	90.37	337.27	5853.42	9974.97	9313.43	-3572.19	40.215230	-80.602785	0.45	
15605.00	90.55	337.59	5852.69	10064.93	9396.53	-3606.73	40.215458	-80.602908	0.41	
15692.00	90.43	337.22	5851.95	10151.90	9476.85	-3640.16	40.215679	-80.603026	0.45	
15779.00	90.31	336.81	5851.39	10238.85	9556.94	-3674.13	40.215900	-80.603147	0.49	
15865.00	90.37	336.63	5850.88	10324.79	9635.94	-3708.12	40.216117	-80.603267	0.22	
15952.00	90.49	336.44	5850.22	10411.72	9715.74	-3742.76	40.216337	-80.603390	0.26	
16039.00	90.25	337.03	5849.66	10498.65	9795.67	-3777.12	40.216557	-80.603512	0.73	
16126.00	90.31	337.07	5849.24	10585.61	9875.78	-3811.05	40.216777	-80.603632	0.08	

RECEIVED
Office of Oil and Gas
MAY 23 2018
WV Department of
Environmental Protection

SD Survey Report

Survey Points: (Relative to Slot centre)(TVD relative to Drill Floor)										
MD (US ft)	Inc (°)	Az (°)	TVD (US ft)	VS (US ft)	N.Offset (US ft)	E.Offset (US ft)	Latitude (° ' ")	Longitude (° ' ")	DLS (°/100US ft)	Comment
16212.00	90.43	337.50	5848.68	10671.57	9955.11	-3844.26	40.216995	-80.603750	0.52	
16299.00	90.25	338.06	5848.17	10758.55	10035.64	-3877.16	40.217217	-80.603866	0.68	
16386.00	90.49	338.79	5847.60	10845.55	10116.55	-3909.15	40.217439	-80.603979	0.88	
16473.00	90.31	339.12	5847.00	10932.55	10197.74	-3940.39	40.217663	-80.604090	0.43	
16482.00	90.31	339.18	5846.95	10941.55	10206.15	-3943.59	40.217686	-80.604101	0.67	Last WFT SVY
16505.00	90.31	339.18	5846.82	10964.54	10227.65	-3951.76	40.217745	-80.604130	0.00	Proj. to TD

RECEIVED
Office of Oil and Gas
MAY 23 2018
WV Department of
Environmental Protection