

Latitude: 40°20'00"

SURFACE HOLE 10,520'

Latitude: 40°15'00"

BOTTOM HOLE

3,264'

JACKSON SURVEYING INC.

2413 EAST PIKE ST. # 112  
Clarksburg, WV 26302  
304-623-5851

Table with 2 columns: Location Type (SHL, LPL, BHL) and UTM Coordinates (NORTHING, EASTING).

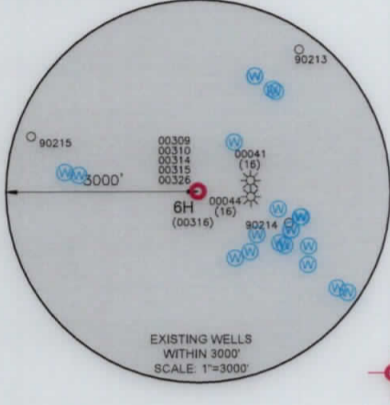
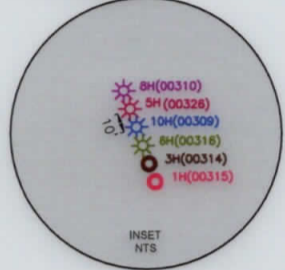
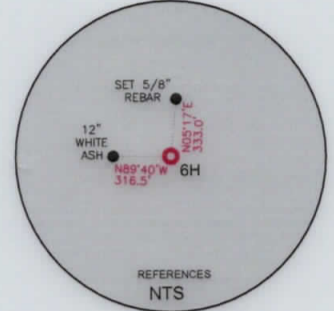
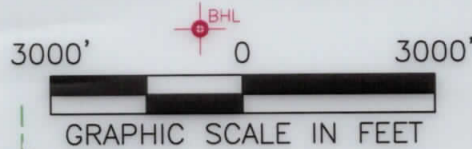


Table with 5 columns: LINE, BEARING, DISTANCE, DESCRIPTION, MONUMENT. Includes curve data for line L3.

WELL RESTRICTIONS


- List of 6 well restrictions including distance from buildings, streams, and public water supply.

NOTES ON SURVEY

- Notes regarding survey boundaries, tax parcel maps, and grid north.

I, THE UNDERSIGNED, HEREBY CERTIFY THAT THIS PLAT IS CORRECT TO THE BEST OF MY KNOWLEDGE AND BELIEF AND SHOWS ALL THE INFORMATION REQUIRED BY LAW AND REGULATIONS ISSUED AND PRESCRIBED BY THE DEPARTMENT OF ENVIRONMENTAL PROTECTION.

P.S. 708 David L Jackson

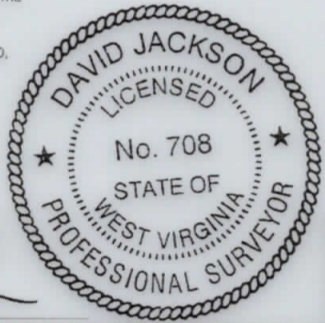

COMPANY: SWN Production Company, LLC



(+) DENOTES LOCATION OF WELL ON UNITED STATES TOPOGRAPHIC MAPS  
WVDEP  
OFFICE OF OIL & GAS  
601 57TH STREET  
CHARLESTON, WV 25034

MINIMUM DEGREE OF ACCURACY: 1/200  
PROVEN SURVEY GRADE GPS ELEVATION: (NAVD 88, US FT)

STATE OF WV DNR C BRK  
OPERATOR'S WELL #: 6H  
API WELL #: 47 009 00316  
STATE COUNTY PERMIT

Well type and completion details: Oil, Production, Deep, Gas, Liquid Injection, Storage, Shallow. Includes watershed, district, surface owner, and completion date (09/10/2021).

WELL OPERATOR: SWN PRODUCTION COMPANY, LLC  
ADDRESS: 1300 FORT PIERPONT ROAD, SUITE 200  
CITY: MORGANTOWN STATE: WV ZIP CODE: 26508


Legend and Revisions table. Legend includes symbols for proposed holes, existing wellheads, landing points, water wells, and springs. Revisions table includes date (07-09-2021) and drawing details.

JACKSON SURVEYING



INC.

2413 EAST PIKE ST. # 112  
 Clarksburg, WV 26302  
 304-623-5851

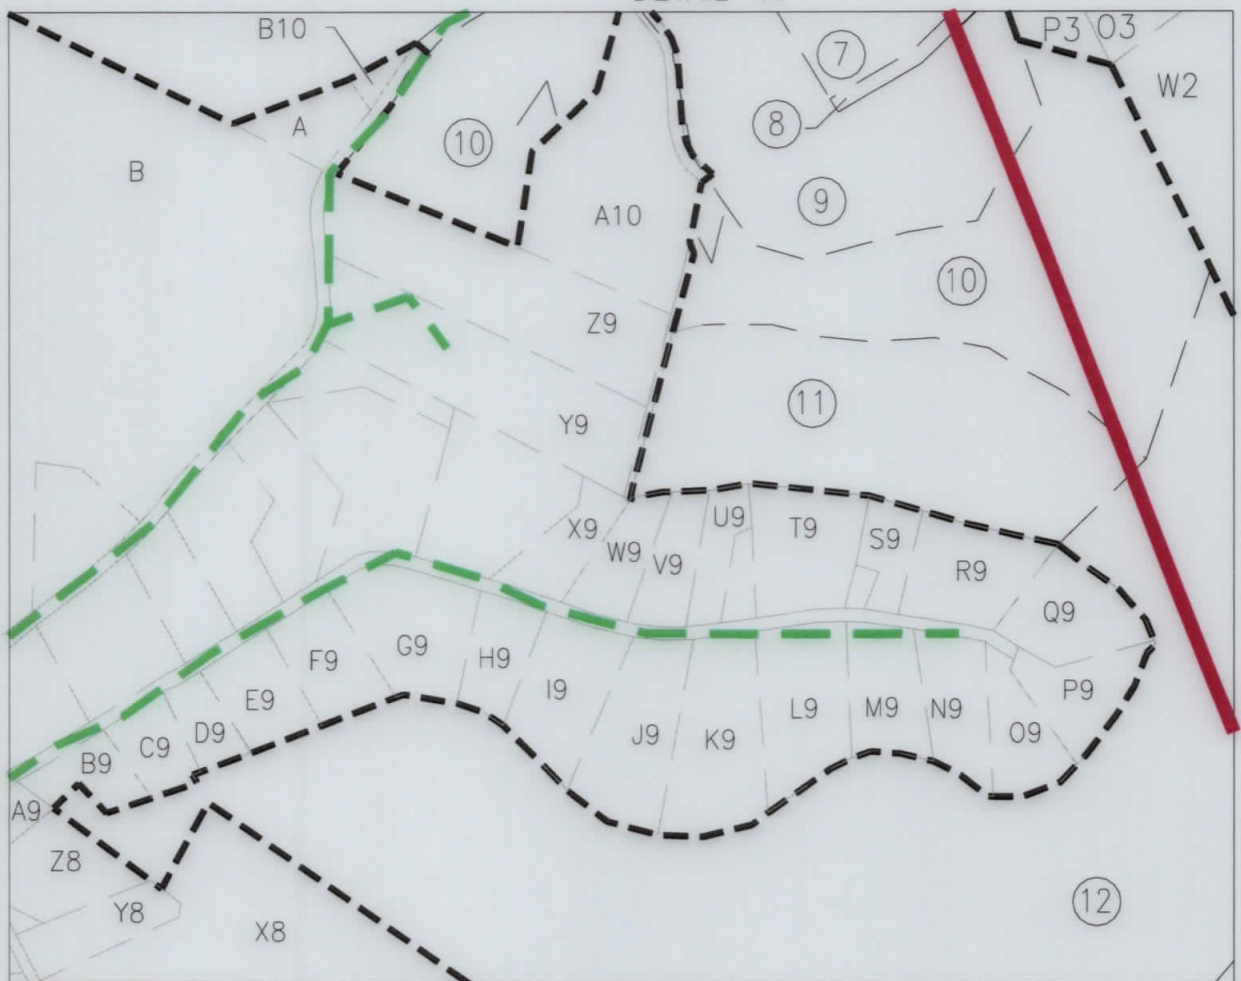DETAIL "A"



09/10/2021



REVISIONS:	COMPANY:			 	
	OPERATOR'S	STATE OF WV DNR C BRK	API:	DATE: 07-09-2021	
	WELL #:	6H	47-009-00316	DRAWN BY: N. MANO	
	DISTRICT:	CROSS CREEK	COUNTY:	STATE:	SCALE: N/A
			BROOKE	WV	DRAWING NO:
					WELL LOCATION PLAT 2

JACKSON SURVEYING  
 INC.  
 2413 EAST PIKE ST. # 112  
 Clarksburg, WV 26302  
 304-623-5851

DETAIL "B"



09/10/2021

REVISIONS:	COMPANY:		 	
	OPERATOR'S	STATE OF WV	DNR	C BRK
	WELL #:	6H		API: 47-009-00316
	DISTRICT:	CROSS CREEK	COUNTY:	BROOKE
		STATE:	WV	DATE: 07-09-2021
				DRAWN BY: N. MANO
				SCALE: N/A
				DRAWING NO:
				WELL LOCATION PLAT 3

**JACKSON SURVEYING  
INC.**



2413 EAST PIKE ST. # 112  
Clarksburg, WV 26302  
304-623-5851

WELL BORE TABLE FOR SURFACE / ROYALTY OWNERS		
TRACT	SURFACE OWNER (S) / ROYALTY OWNER (R)	TAX PARCEL
1	STATE OF WEST VIRGINIA, BUREAU OF COMMERCE, DIVISION OF NATURAL RESOURCES, PUBLIC LAND CORPORATION (S/R)	4-CC20-06
TRACT	SURFACE OWNER	TAX PARCEL
2	STATE OF WEST VIRGINIA, BUREAU OF COMMERCE, DIVISION OF NATURAL RESOURCES, PUBLIC LAND CORPORATION (S)	4-CC19-169
3	NICKOLES 3, LLC (S)	4-CC20-33
4	NORFOLK & WESTERN RAILWAY CO. (S)	4-C19K-18
5	STATE OF WEST VIRGINIA, BUREAU OF COMMERCE, DIVISION OF NATURAL RESOURCES, PUBLIC LAND CORPORATION (S)	4-CC23-325
6	MARK E. VAUGHN & LISA A. VAUGHN (S)	04-CC24-09
7	DAVID A. MIHLBAUER & TERI L. MIHLBAUER (S)	04-CC24-10
8	OTIS T. PETTRY (S)	04-CC24-11
9	OTIS T. PETTRY (S)	04-CC24-12
10	RAYMOND S. CROSS, DENNIS P. CROSS, & KATHRYN R. BUTLER (S)	04-CC24-13
11	JAMES MCCLOUD, ET AL (S)	04-CC24-15
12	GEORGE L. BRADLEY (S)	04-CC24-55
13	DEAN SMITH (S)	04-CC24-98
14	DEAN SMITH (S)	04-CC24-99
15	MICHAEL K. MCFADDEN & SHARON MCFADDEN (S)	04-CC24-93
16	MICHAEL J. CIPRIANI (S)	04-CC24-142
17	MICHAEL J. CIPRIANI (S)	04-CC24-141
18	RICHARD H. SCOTT & DENA M. SCOTT (S)	04-CC24-104
19	STEVEN BROWN (S)	04-CC24-99.2
20	EDWARD A. CALVERT & JULIA A. CALVERT (SURV)(S)	04-CC24-105
21	EDWARD A. CALVERT & JULIE A. CALVERT (S)	04-CC24-106
22	TRAVIS SMITH (S)	04-CC24-112
23	MICHAEL D. JONES & LOIS J. JONES (S)	4-CC24-128
24	EUGENE MITCHELL JR. & MARGARET MITCHELL - L/E, JESSE MITCHELL ET AL (S)	04-CC24-131
25	THOMAS COLE & VIRGINIA COLE (S)	04-CC24-127
26	ELLEN CATTARUZZA (S)	4-CC29-39
27	JONATHAN G. BEALL & DEANNA M. BEALL (S)	4-CC29-40
28	JEFFERY LUCK & JANE DAUGHERTY-LUCK (S)	04-CC29-39.1
29	JEFFERY LUCK & JANE DAUGHERTY-LUCK (S)	04-CC29-39.13
30	MARK A. HONE & LAUREN N. HONE (S)	04-CC29-39.2
31	DEBRA CYPHER, MATTHEW FAIR & SUSAN BRUFFY (S)	4-CC29-57
32	ROBERT LEE FRESHWATER (S)	4-CC29-134
33	RUTH ANN STEWART, MADELOD DAWN JACKSON (S)	4-CC29-194
34	NEAL E. SMITH & JOAN W. SMITH (S)	04-CC29-194.2
35	RYAN M. SMITH & BROOKE N. SMITH (S)	370-007-00-00-0001-01
36	NICOLE R. SMITH & NEAL E. SMITH (S)	370-007-00-00-0001-02
37	JOSEPH J. DEPETRO III (S)	370-007-00-00-0001-00
38	HIGHLAND SPRINGS GOLF COURSE (S)	370-007-00-00-0006-00
39	ROBERT G. BRIGGS & NANCY L. BRIGGS (S)	370-007-00-00-0002-00
40	BROWNLEE LAND VENT LP (S)	370-007-00-00-0005-00

ADJOINING OWNERS TABLE		
TRACT	SURFACE OWNER	TAX PARCEL
A	WILLIAM C. BAIRD & CYNTHIA L. BAIRD	04-CC24-05
B	ALBERT JOHNS, GARY JOHNS, GREGORY JOHNS & TAMMY MOORE	04-CC23-326
C	WILLIAM H. THOMPSON & DEBRA THOMPSON	04-CC23-320
D	SAMUEL HUBBARD	04-CC23-318
E	BRIAN CORWIN	04-CC23-78
F	COOK FAMILY REVOCABLE TRUST	04-CC23-322
G	BOBBIE JO MENEELY & RANDALL MINCH	04-CC23-324
H	MICHAEL W. MOORE	04-CC23-323
I	JUDITH ANN MOORE	04-CC23-185
J	CHARLES D. MOORE & CECILIA F. MOORE	04-CC23-180
K	ROSA MARIE EDGELL	04-CC23-176
L	CONSTANTINE EVANGELINOS & TOULA EVANGELINOS	04-CC23-171
M	LINDY L. GALIANO	04-CC23-170
N	PETER D'AGOSTINO	04-CC23-188
O	GREGORY DANIEL NICKOLES, RANDY LEE NICKOLES, JEFFREY OWN NICKOLES (DANNY NICKOLES & GRACE NICKOLES -LE)	04-CC23-160
P	DAVID BAKER	04-CC19-164
Q	DOUGLAS P. EMMERTH & PAMELA L. EMMERTH	04-CC19-165
R	JUDITH ANN BERNARDINI	04-CC20-09
S	MICHAEL LEE BERNARDINI & JULIE LYNN BERNARDINI	04-CC20-44
T	STATE OF WEST VIRGINIA, BUREAU OF COMMERCE, DIVISION OF NATURAL RESOURCES, PUBLIC LAND CORPORATION	04-CC19-168
U	GRETCHEN MOORE LANGEVIN, TRUSTEE & WESTBANCO BANK INC, TRUSTEE	04-CC20-05

ADJOINING OWNERS TABLE		
TRACT	SURFACE OWNER	TAX PARCEL
V	JOHN ERNEST MILLER & JESSE ANDREW MILLER	04-CC20-04
W	SUSAN D. BREEN & DENNIS M. BREEN	04-CC20-22
X	COLLIER'S SPORTSMAN CLUB	04-CC20-21
Y	WILLIAM MORGAN ROUSE & DORIS J. ROUSE	04-CC20-20
Z	LINDY L. BLACK	04-CC20-07
A2	LINDY L. GALIANO & SANTY GALIANO	04-CC20-19.1
B2	EDWARD L. CARTER & DEBORAH C. CARTER	04-CC20-18
C2	EDWARD L. CARTER & DEBORAH C. CARTER	04-CC20-17
D2	ERIC T. GALIANO	04-CC20-16
E2	ERIC T. GALIANO	04-CC20-14
F2	ERIC T. GALIANO	04-CC20-19
G2	KEVIN MCCONNELL	04-CC20-11
H2	SUSAN KAY PRONCHIK	4-CC20-08
I2	BARBARA J. MCCONNELL	4-CC20-10
J2	NORFOLK & WESTERN RAILWAY CO.	04-C24B-29
K2	ROBERT G. HIGGINBOTHAM JR.	04-CC20-41
L2	RON GASPARENE	04-CC20-40
M2	WILLIAM & MILDRED T. MARINO	04-CC20-35
N2	ROBERT & DELORIS CLINE	04-CC20-34
O2	DEBORAH K. SLIDAY	04-CC20-32
P2	STATE OF WV DNR	04-CC20-25
Q2	CALVIN H. MYERS JR.	380-014-00-00-0002-00
R2	JEFFERSON QTW EXEMPT PROPERTY	380-014-00-00-0001-00
S2	RANDY L. NICKOLES	380-015-00-00-0019-00

09/10/2021



REVISIONS:	COMPANY:	 	
	OPERATOR'S	STATE OF WV DNR C BRK	API:
	WELL #:	6H	47-009-00316
	DISTRICT:	CROSS CREEK	DATE:
	COUNTY:	BROOKE	07-09-2021
	STATE:	WV	DRAWN BY: N. MANO
			SCALE: N/A
			DRAWING NO:
			WELL LOCATION PLAT 4

**JACKSON SURVEYING  
INC.**

2413 EAST PIKE ST. # 112  
Clarksburg, WV 26302  
304-623-5851

ADJOINING OWNERS TABLE			ADJOINING OWNERS TABLE		
TRACT	SURFACE OWNER	TAX PARCEL	TRACT	SURFACE OWNER	TAX PARCEL
T2	JEFFERY O. NICKOLES	04-C24B-09	T4	BROWNLEE LAND VENTURES, L.P.	03-B34-66
U2	RANDY L. NICKOLES	04-C24B-08	U4	BROWNLEE LAND VENTURES, L.P.	03-B34-78
V2	RANDY L. NICKOLES	04-C24B-33	V4	HIGHLAND SPRINGS GOLF COURSE, LLC	03-B29-18
W2	MICHAEL OBER	4-CC24-07	W4	DARREN P. MILLS	04-CC29-235
X2	GREG NICKOLES & CAROL NICKOLES	04-C24B-12	X4	L & G REALTY LLC	04-CC29-234
Y2	GREG NICKOLES & CAROL NICKOLES	04-C24B-13	Y4	GARLAND E. MINOR	04-CC29-232
Z2	GREG NICKOLES & CAROL NICKOLES	04-C24B-14	Z4	KEVIN A. JEFFRIES & RACHAEL M. JEFFRIES	04-CC29-230
A3	H3, LLC.	04-C24B-15	A5	JEREMY J. KOLBA	04-CC29-229
B3	GREG NICKOLES & CAROL NICKOLES	04-C24B-16	B5	GERALD D. JACKSON	04-CC29-228
C3	CL45 MW REO I, LLC	04-C24B-20	C5	GERALD D. JACKSON & JUDITH K. JACKSON	04-CC29-227
D3	JOHN MATTHEW BUCY & TABITHA BUCY	04-C24B-07	D5	MARK W. MINOR, KEVIN L. MINOR & LISA M. MINOR	04-CC29-194.1
E3	GREGORY NICKOLES	04-C24B-06	E5	BRIAN CONNELLY & TAMMY CONNELLY	04-CC29-219
F3	DEBRA MCQUILLAN & ANNETTE MILLER	04-C24B-27	F5	HIGHLAND SPRINGS GOLF COURSE, LLC	03-B29-06
G3	DEBRA MCQUILLAN & ANNETTE MILLER	04-C24B-28	G5	CHARLES M. ROBERSON & DOROTHY ROBERSON	03-B29-05
H3	JANE KIERCE	04-C24B-04	H5	KEVIN C. KLAGES	04-CC29-217
I3	WVA DEPARTMENT OF HIGHWAYS	04-C24B-03	I5	RUTH ANN STEWART & MADELON DAWN JACKSON	04-CC29-213
J3	EDWARD L. THOMPSON & CAROL J. THOMPSON	04-C24B-02	J5	RUTH ANN STEWART & MADELON DAWN JACKSON	04-CC29-193
K3	JEFFERY NICKOLES, RANDY NICKOLES & GREGORY NICKOLES	04-C24B-01	K5	JAMI PACKER	04-CC29-192
L3	JEFFERY O. NICKOLES	04-CC20-33.1	L5	NORMAN C. CLAMPITT & JEANETTE K. CLAMPITT	04-CC29-190
M3	JAMES JOHNSON & CHARLENE JOHNSON	04-CC20-43	M5	ROBERT LEE FRESHWATER	04-CC29-168
N3	TIMOTHY J. DISERIO	04-CC20-42	N5	MAIN DRIVE CIVIC ASSOCIATION, INC.	04-CC29-167
O3	STATE OF WEST VIRGINIA, BUREAU OF COMMERCE, DIVISION OF NATURAL RESOURCES, PUBLIC LAND CORPORATION	4-CC24-03	O5	ROBERT LEE FRESHWATER	04-CC29-166
P3	WHEELING ENERGY WORKS, LTD.	04-CC24-08	P5	ROBERT LEE FRESHWATER	04-CC29-165
Q3	EUGENE CRUNY	04-CC24-130	Q5	ROBERT LEE FRESHWATER	04-CC29-164
R3	STARVAGGI INDUSTRIES	04-CC24-129	R5	CHARLES HAGLER	04-CC29-162
S3	BROWNLEE LAND VENTURES	370-001-00-00-0015-00	S5	PHILLIP E. BLANKENSHIP	04-CC29-153
T3	RYAN J. COOK & EMILY M. COOK	04-CC24-149	T5	MARY D. GOUGHNER	04-CC29-152.1
U3	KEITH J. FISCHER & DAWN MARIE FISCHER	04-CC24-152	U5	JANIS BARNA REID	04-CC29-149
V3	KEITH J. FISCHER & DAWN MARIE FISCHER	04-CC24-153	V5	PAUL S. BILLIARD & CAROL A. BILLIARD - L/E KIMBERLY A. WALES, PAUL BILLIARD & TIMOTHY BILLIARD	04-CC29-148
W3	JOSEPH M. WHITE & RACHEL E. WHITE	4-CC24-150	W5	RANDY FILKINS	04-CC29-147
X3	JOSEPH M. WHITE & RACHEL E. WHITE	04-CC24-151	X5	COREY L. MAYNARD	04-CC29-146
Y3	COREY L. PALMER & ALLYSON M. PALMER	04-CC24-143	Y5	GERALDINE A. AUBER	04-CC29-142
Z3	CHAD A. SOLE & MISTY D. SOLE	4-CC29-39.20	Z5	GERALDINE A. AUBER	04-CC29-138
A4	JOSEPH E. CROSS JR. & JENNIFER L. CROSS	4-CC29-39.21	A6	LORI ANN OHLER & RICK OHLER	04-CC29-137
B4	JOSPEH E. CROSS JR. & JENNIFER L. CROSS	04-CC29-39.17	B6	HOLLIS R. OSBORNE & DEBORAH M. OSBOURNE	04-CC29-136
C4	EMILY BEALL & STEPHANIE BEALL	04-CC29-39.15	C6	JAMES N. HARTZER & CAROLE G. HARTZER	04-CC29-135
D4	JOHN E. MITCHELL & JOAN R. MITCHELL	04-CC29-39.16	D6	JERRY FLUHARTY & MARY FLUHARTY	04-CC29-133
E4	ALFRED J. ROCCHIO JR. & SHERRY E. ROCCHIO	04-CC29-39.8	E6	ROBERT L. YOUNG	04-CC29-132
F4	ARLEY R. MITCHELL & NANCY E. MITCHELL	04-CC29-39.11	F6	ERIC W. CAMPBELL	04-CC29-117
G4	DAVID H. MCCLAIN & KAREN MCCLAIN	04-CC29-39.7	G6	CHARLES L. KRAFT	04-CC29-111
H4	STATE LINE REAL ESTATE LLC	370-004-00-00-0001-00	H6	EMILIO A. MUSCEDERE & JUDITH A. MUSCEDERE	04-CC29-53
I4	RONALD B. POWELL JR. & ROSEANNE POWELL	370-007-00-00-0002-02	I6	EMILIO A. MUSCEDERE & JUDITH A. MUSCEDERE	04-CC29-54
J4	CHERYL BULYA	370-007-00-00-0002-01	J6	JOHN H. LYLE JR. & MARY CATHERINE LYLE	04-CC29-55
K4	ROBERT T. MCALPINE & RHONDA M. MCALPINE	370-007-00-00-0002-04	K6	JOHN H. LYLE JR. & MARY CATHERINE LYLE	04-CC29-56
L4	DAVID J. DEMPSTER & JOANNE K. DEMPSTER	370-007-00-00-0002-03	L6	BRIAN T. FERDA & VI-EVA FERDA	04-CC29-58
M4	WILLIAM TACZAK & GEORGE TACZAK	370-008-01-01-0001-01	M6	BRIAN T. FERDA & VI-EVA FERDA	04-CC29-59
N4	ALBERT PETRUSH & JAMIE GMITER	370-007-00-00-0002-05	N6	BRIAN T. FERDA & VI-EVA FERDA	04-CC29-60
O4	JOSEPH J. DEPETRO III	370-011-00-00-0009-00	O6	GARY KUSICH & PATRICIA ELAINE KUSICH	04-CC29-61
P4	LISA L. JACOBS & TERRY G. JACOBS	370-011-00-00-0009-01	P6	GARY KUSICH & PATRICIA ELAINE KUSICH	04-CC29-62
Q4	BELLVIEW CAMP MEETING ASSOC, LINDA HEPBURN	370-007-00-00-0003-00	Q6	ROGER L. CLEM & MILDRED O. CLEM	04-CC29-63
R4	PAUL A. CUNNINGHAM	370-007-00-00-0004-00	R6	RONALD LEE HICKS & DEBRA V. HICKS	04-CC29-43
S4	BROWNLEE LAND VENT, L.P.	370-011-00-00-0004-00	S6	ROBERT R. NEWTON JR.	04-CC29-41.1
			T6	NATALIE J. PAPSON	04-CC29-41
			U6	KERRY W. WELSH & BARBARA A. WELSH	04-CC29-39.9
			V6	JOHN E. MITCHELL & JOAN R. MITCHELL	04-CC29-39.5
			W6	ELLEN CATTARUZZA	04-CC29-39
			X6	EUGENE MITCHELL JR. & MARGARET MITCHELL - L/E, JESSE MITCHELL ET AL	04-CC24-126
			Y6	GEORGE A. BARCHIESI & PAMELA J. BARCHIESI	04-CC24-125
			Z6	GEORGE A. BARCHIESI & PAMELA J. BARCHIESI	04-CC24-122
			A7	TODD P. FERGUSON & LISA FERGUSON	04-CC24-99.1
			B7	TODD P. FERGUSON & LISA FERGUSON	04-CC24-120
			C7	JERRY M. BOOTH & DEBRA D. BOOTH	04-CC24-119
			D7	PAUL J. SICURELLA & LEA M. SICURELLA	04-CC24-118

09/10/2021

REVISIONS:	COMPANY:	 	
	OPERATOR'S	STATE OF WV DNR C BRK	API:
	WELL #:	6H	47-009-00316
	DISTRICT:	CROSS CREEK	STATE:
			WV
			DATE: 07-09-2021
			DRAWN BY: N. MANO
			SCALE: N/A
			DRAWING NO:
			WELL LOCATION PLAT 5



**JACKSON SURVEYING  
INC.**

2413 EAST PIKE ST. # 112  
Clarksburg, WV 26302  
304-623-5851

ADJOINING OWNERS TABLE		
TRACT	SURFACE OWNER	TAX PARCEL
E7	DAVID HUNT KINS & PATRICIA ANN KINS	04-CC24-116
F7	JEFFERY R. ADAMS & SHEILA D. ADAMS	04-CC24-115
G7	JEFFERY R. ADAMS & SHEILA D. ADAMS	04-CC24-114
H7	ARTHUR SHERICH & LEIGH ANN SHERICH	04-CC24-113
I7	DEAN SMITH	04-CC24-111
J7	DEAN SMITH	04-CC24-110
K7	DEAN SMITH	04-CC24-109
L7	PATRICK D. AMKRUM & ERIC C. ANKRUM	04-CC24-107
M7	JACK B. EARNEST JR. & LESLIE M. EARNEST	04-CC24-108
N7	MICHAEL J. CIPRIANI	04-CC24-141
O7	KEVIN L. CRAFT & MARGARET K. CRAFT	04-CC24-103
P7	SHELLY D. GAUMER	04-CC24-102
Q7	JAY THOMAS GAUMER & SHELLY DAWN GAUMER	04-CC24-99.3
R7	BRIAN TAYLOR	04-CC24-99.5
S7	BRIAN TAYLOR	04-CC24-133
T7	COREY T. CARROLL & KATELYN N. SWAGER	04-CC24-134
U7	RYAN E. HALL & NICOLE M. STANLEY	04-CC24-137
V7	JASON MICHAEL KUSIC & ALICIA RENEE KUSIC	04-CC24-136
W7	JOHN L. DAVIS & F. LYNN DAVIS	04-CC24-145
X7	JOHN L. DAVIS & F. LYNN DAVIS	04-CC24-144
Y7	LESLIE J. JOHNS & MELISSA J. JOHNS	04-CC24-140
Z7	LESLIE J. JOHNS & MELISSA J. JOHNS	04-CC24-139
A8	JUSTIN A. GRIFFITH & KERI D. GRIFFITH	04-CC24-148
B8	GARRETT AUSTIN INGRAM	04-CC24-99.7
C8	LARRY T. MAIN	04-CC24-99.8
D8	JASON D. DRUM & AMANDA R. DRUM	04-CC24-146
E8	WILLIAM L. MONK & TINA M. MONK	04-CC24-99.4
F8	JOSH R. COOK & BEVERLY A. COOK	04-CC24-97
G8	JOSH R. COOK & BEVERLY A. COOK	04-CC24-147
H8	JOSEPH M. MULLENBACH & SUSAN B. MULLENBACH	04-CC24-95
I8	JOSEPH M. MULLENBACH & SUSAN B. MULLENBACH	04-CC24-135
J8	EDWARD ROBERT MARKS III & TONI JO MARKS	04-CC24-117
K8	KEVIN M. FARRELL & HEIDI J. FARRELL	04-CC24-92
L8	KEVIN M. FARRELL & HEIDI J. FARRELL	04-CC24-91
M8	RALPH A. BRADY & KIM BRADY	04-CC24-90
N8	BRIAN L. FERGUSON & NANCY J. FERGUSON	04-CC24-89
O8	JAMES E. HUFFNER & PATRICIA HUFFNER	04-CC24-88
P8	JAMES E. HUFFNER & PATRICIA HUFFNER	04-CC24-99.6
Q8	CHRISTOPHER L. CECCHINI	04-CC24-87
R8	CHRISTOPHER L. CECCHINI & AMY CECCHINI	04-CC24-86
S8	MICHAEL SCOTT BOLEN	04-CC24-85
T8	DREW FERGUSON	04-CC24-84.1
U8	TERRI HEFFNER	04-CC24-84
V8	CHARLES WAYNE MALONEY & NANCY L. MALONEY	04-CC29-17
W8	JOHN STEVENS & LINDA STEVENS	04-CC24-56
X8	KEVIN W. KLAGES & LINDA K. KLAGES	04-CC24-52
Y8	KEVIN W. KLAGES & LINDA K. KLAGES	04-CC24-51
Z8	TERRI HEFFNER	04-CC24-49
A9	GEORGE BRADLEY	04-CC24-132
B9	DONALD LEMASTERS & JOYCE LEMASTERS	04-CC24-23

ADJOINING OWNERS TABLE		
TRACT	SURFACE OWNER	TAX PARCEL
C9	WARREN H. MOZINGO & LINDA D. MOZINGO	04-CC24-24
D9	CALVIN G. BURDINE & HANNA M. BURDINE	04-CC24-25
E9	MARIE LAUCK	04-CC24-26
F9	WARREN H. MOZINGO & LINDA D. MOZINGO	04-CC24-27
F9	WARREN H. MOZINGO & LINDA D. MOZINGO	04-CC24-27
G9	ROBERT B. COLEMAN & SHERRY E. COLEMAN	04-CC24-28
H9	BUDDY L. TAYLOR, JR. & PATRICIA L. TAYLOR	04-CC24-29
I9	JASON R. ADAMS	04-CC24-30
J9	ROGER DALE WHITE	04-CC24-31
K9	ROGER DALE WHITE	04-CC24-32
L9	PAULETTE MC CLOUD	04-CC24-33
M9	EVA SHINGLE & RAYMOND SHINGLE	04-CC24-34
N9	EVA SHINGLE & RAYMOND SHINGLE	04-CC24-35
O9	BERNARD E. CRAWFORD & WILMA L. CRAWFORD	04-CC24-36
P9	BERNARD E. CRAWFORD & WILMA L. CRAWFORD	04-CC24-37
Q9	WILLIAM R. HUNTER & GLORIA J. HUNTER	04-CC24-38
R9	VICKIE L. SMITH	04-CC24-39
S9	JIM R MC CLOUD & MARTHA MC CLOUD	04-CC24-40
T9	JIM R MC CLOUD & MARTHA MC CLOUD	04-CC24-42
U9	JOHN O. FILLINGER	04-CC24-44
V9	RANDALL L. THOMPSON	04-CC24-45
W9	DAVID GRANT MC CLOUD & THERESA A. MC CLOUD	04-CC24-46
X9	JENNIFER TAYLOR	04-CC24-47
Y9	RANDY L. COLLINS & AMY R. COLLINS	04-CC24-17
Z9	THERESA ANN LYNCH (LE - CHARLES THORNE & ELLEN THORNE)	04-CC24-16
A10	RICHARD L. WALLACE & TRACEY WALLACE	04-CC24-14
B10	DON TAYLOR	04-CC24-06

09/10/2021

REVISIONS:	COMPANY:	 	
	OPERATOR'S	STATE OF WV DNR C BRK	API:
	WELL #:	6H	47-009-00316
	DISTRICT:	CROSS CREEK	DATE:
	COUNTY:	BROOKE	07-09-2021
	STATE:	WV	DRAWN BY: N. MANO
			SCALE: N/A
			DRAWING NO:
			WELL LOCATION PLAT 6