


| WELL NAME | LATITUDE (NAD 83) | LONGITUDE (NAD 83) |
|------------------------|-------------------|--------------------|
| STATE OF WV DNR B 406H | 40.340954 | -80.527747 |
| STATE OF WV DNR B 3H | 40.340839 | -80.527761 |
| STATE OF WV DNR B 5H | 40.340883 | -80.527842 |
| STATE OF WV DNR B 6H | 40.340801 | -80.527764 |
| STATE OF WV DNR B 8H | 40.340877 | -80.527756 |
| STATE OF WV DNR B 206H | 40.340916 | -80.527752 |
| STATE OF WV DNR B 401H | 40.340992 | -80.527743 |

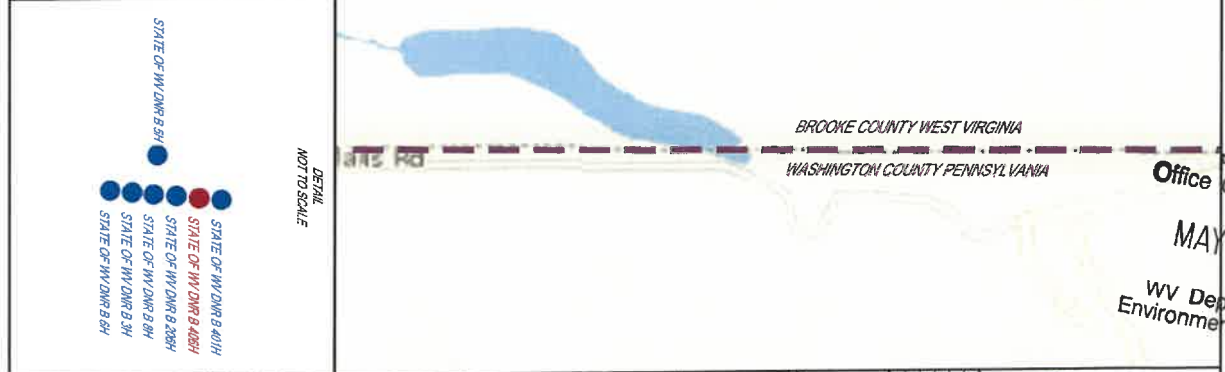

PREPARED FOR:
Southwestern Energy®

LEGEND
● = EXISTING WELL TO REMAIN
● = CONDUCTOR TO BE PLUGGED

LOCATION MAP
PROJECT LOCATION

LOCATION MAP
NOT TO SCALE

THE STATE OF WEST VIRGINIA
WV DNR B BRK 406H
CROSS CREEK DISTRICT
BROOKE COUNTY,
WEST VIRGINIA

PLUGGING MAP

JHA
SURVEYORS
ENGINEERS
ENVIRONMENTAL
COMPUTER
GIS MAPPING

68011 VINEYARD RD
ST. CLAIRSVILLE, OH 43950

PA. • OH. • NY. • WV. • VA. • MD.

2017-541
04-27-2023
1" = 500'

DATE: 04-27-2023
SCALE: 1" = 500'

PROJECT: WV DNR B BRK 406H
SHEET NO. 1

RECEIVED
Office of Oil and Gas
MAY 9 2023
WV Department of
Environmental Protection

06/30/2023

THESE DRAWINGS SHALL NOT BE UTILIZED BY ANY PERSON, FIRM OR CORPORATION WITHOUT THE SPECIFIC WRITTEN PERMISSION OF JHA COMPANIES

WW-7
8-30-06



West Virginia Department of Environmental Protection
Office of Oil and Gas

WELL LOCATION FORM: GPS

API: 47-009-00332 WELL NO.: 406H

FARM NAME: State of WV DNR B BRK

RESPONSIBLE PARTY NAME: SWN Production Co., LLC

COUNTY: Brooke DISTRICT: Cross Creek

QUADRANGLE: Steubenville East

SURFACE OWNER: State of WV, Bureau of Commerce, DNR

ROYALTY OWNER: State of WV, Bureau of Commerce, DNR

UTM GPS NORTHING: 4,465,707.90

UTM GPS EASTING: 540,110.21 GPS ELEVATION: 1201'

The Responsible Party named above has chosen to submit GPS coordinates in lieu of preparing a new well location plat for a plugging permit or assigned API number on the above well. The Office of Oil and Gas will not accept GPS coordinates that do not meet the following requirements:

1. Datum: NAD 1983, Zone: 17 North, Coordinate Units: meters, Altitude: height above mean sea level (MSL) – meters.
2. Accuracy to Datum – 3.05 meters
3. Data Collection Method:

Survey grade GPS : Post Processed Differential _____

Real-Time Differential

Mapping Grade GPS _____ : Post Processed Differential _____

Real-Time Differential _____

4. **Letter size copy of the topography map showing the well location.**

I the undersigned, hereby certify this data is correct to the best of my knowledge and belief and shows all the information required by law and the regulations issued and prescribed by the Office of Oil and Gas.

Brittany Woody

Staff Regulatory Specialist

5/30/23 06/30/2023