




68011 Vineyard Road
St. Clairsville, Ohio 43085
740-495-4100

NOTES ON SURVEY

1. SURFACE AND ROYALTY OWNER INFORMATION AND THEIR BOUNDARIES SHOWN HEREON WERE PLOTTED FROM DEEDS AND/OR TAX PARCEL MAPS PROVIDED BY CLIENT AND/OR FIELD LOCATIONS.
2. THIS PLAT DOES NOT REPRESENT A BOUNDARY SURVEY OF THE PARCELS SHOWN HEREON.
3. ALL INSETS ARE GRID NORTH UNLESS OTHERWISE DEPICTED.


SURFACE HOLE LOCATION (SHL):	SURFACE HOLE LOCATION (SHL):
GEOGRAPHIC (NAD83): LATITUDE: 40.318403° LONGITUDE: -80.559819°	GEOGRAPHIC (NAD27): LATITUDE: 40.318334° LONGITUDE: -80.560025°
UTM (NAD83, ZONE 17, FEET): NORTHING: 14642985.08 EASTING: 1763115.62	STATE PLANE (NAD27, FEET): NORTHING: 664050.73 EASTING: 1704398.86
UTM (NAD83, ZONE 17, METERS): NORTHING: 4463190.79 EASTING: 537398.72	
LANDING POINT LOCATION (LPL):	LANDING POINT LOCATION (LPL):
GEOGRAPHIC (NAD83): LATITUDE: 40.321010° LONGITUDE: -80.564180°	GEOGRAPHIC (NAD27): LATITUDE: 40.320941° LONGITUDE: -80.564386°
UTM (NAD83, ZONE 17, FEET): NORTHING: 14643928.50 EASTING: 1761895.22	STATE PLANE (NAD27, FEET): NORTHING: 665014.87 EASTING: 1703194.00
UTM (NAD83, ZONE 17, METERS): NORTHING: 4463478.33 EASTING: 537026.74	
BOTTOM HOLE LOCATION (BHL):	BOTTOM HOLE LOCATION (BHL):
GEOGRAPHIC (NAD83): LATITUDE: 40.386775° LONGITUDE: -80.592616°	GEOGRAPHIC (NAD27): LATITUDE: 40.386707° LONGITUDE: -80.592822°
UTM (NAD83, ZONE 17, FEET): NORTHING: 14667839.89 EASTING: 1753858.67	STATE PLANE (NAD27, FEET): NORTHING: 689067.49 EASTING: 1695556.55
UTM (NAD83, ZONE 17, METERS): NORTHING: 4470766.54 EASTING: 534577.19	
SURFACE HOLE LOCATION (SHL):	SURFACE HOLE LOCATION (SHL):
GEOGRAPHIC (NAD83): LATITUDE: 40.318402° LONGITUDE: -80.559817°	GEOGRAPHIC (NAD27): LATITUDE: 40.318332° LONGITUDE: -80.560024°
UTM (NAD83, ZONE 17, FEET): NORTHING: 14642984.68 EASTING: 1763115.99	STATE PLANE (NAD27, FEET): NORTHING: 664050.33 EASTING: 1704399.22
UTM (NAD83, ZONE 17, METERS): NORTHING: 4463190.66 EASTING: 537398.83	
LANDING POINT LOCATION (LPL):	LANDING POINT LOCATION (LPL):
GEOGRAPHIC (NAD83): LATITUDE: 40.320847° LONGITUDE: -80.564274°	GEOGRAPHIC (NAD27): LATITUDE: 40.320775° LONGITUDE: -80.564481°
UTM (NAD83, ZONE 17, FEET): NORTHING: 14643869.01 EASTING: 1761869.20	STATE PLANE (NAD27, FEET): NORTHING: 664955.80 EASTING: 1703199.97
UTM (NAD83, ZONE 17, METERS): NORTHING: 4463460.20 EASTING: 537018.81	
BOTTOM HOLE LOCATION (BHL):	BOTTOM HOLE LOCATION (BHL):
GEOGRAPHIC (NAD83): LATITUDE: 40.386748° LONGITUDE: -80.592729°	GEOGRAPHIC (NAD27): LATITUDE: 40.386680° LONGITUDE: -80.592934°
UTM (NAD83, ZONE 17, FEET): NORTHING: 14667830.11 EASTING: 1753827.38	STATE PLANE (NAD27, FEET): NORTHING: 689058.23 EASTING: 1695525.09
UTM (NAD83, ZONE 17, METERS): NORTHING: 4470763.56 EASTING: 534567.66	

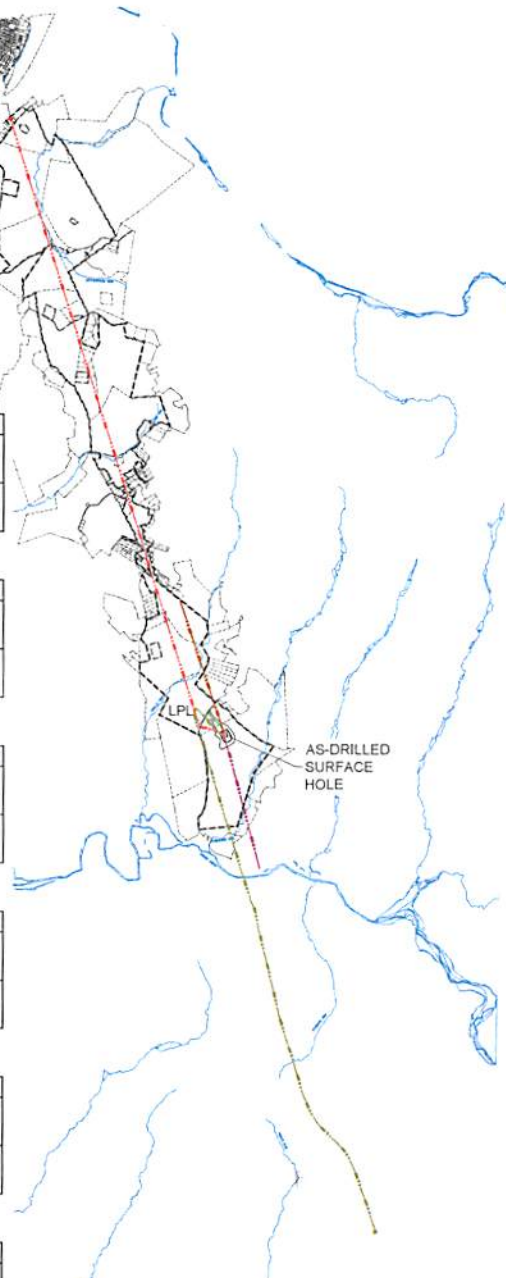

GRID NORTH
UTM ZONE 17, U.S. FT

RECEIVED
Office of Oil and Gas
OCT 15 2025
WV Department of
Environmental Protection

6000 0 6000
GRAPHIC SCALE IN FEET

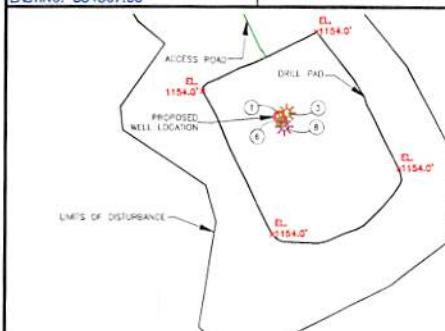

NOTE: ANY UTILITIES OR IMPROVEMENTS SHOWN ON THIS PLAT ARE FROM REASONABLE VISUAL OBSERVATIONS. NO UTILITY COMPANIES WERE CONTACTED FOR UTILITY LINE LOCATIONS.

LEGEND:	
AS-DRILLED SURFACE HOLE / BOTTOM HOLE	PRELIMINARY DRILLING UNIT
EXISTING / PRODUCING WELLHEAD	LEASE BOUNDARY
ABANDONED WELL	HARDLINE BOUNDARY
PLUGGED & ABANDONED WELL	NATURAL WATERWAY
LANDING POINT LOCATION	WELL 2 > MARCELLUS PATH

COMPANY:

expand

OPERATOR'S

GERALD GOURLEY BRK

WELL #:

1H

DISTRICT:

CROSS CREEK

COUNTY:

BROOKE

STATE:

WV

SWN PRODUCTION COMPANY, LLC
SURFACE HOLES

1. "GERALD GOURLEY BRK 1H"
3. "GERALD GOURLEY BRK 3H"
6. "GERALD GOURLEY BRK 6H"
8. "GERALD GOURLEY BRK 8H"

REVISIONS:

DATE: 05-08-2025

API NO: 47-009-00345


DRAWN BY: Z. WOOD

SCALE: 1" = 6000'

DRAWING NO: 2024-1300

INTERNAL WELL PLAT

01/23/2026

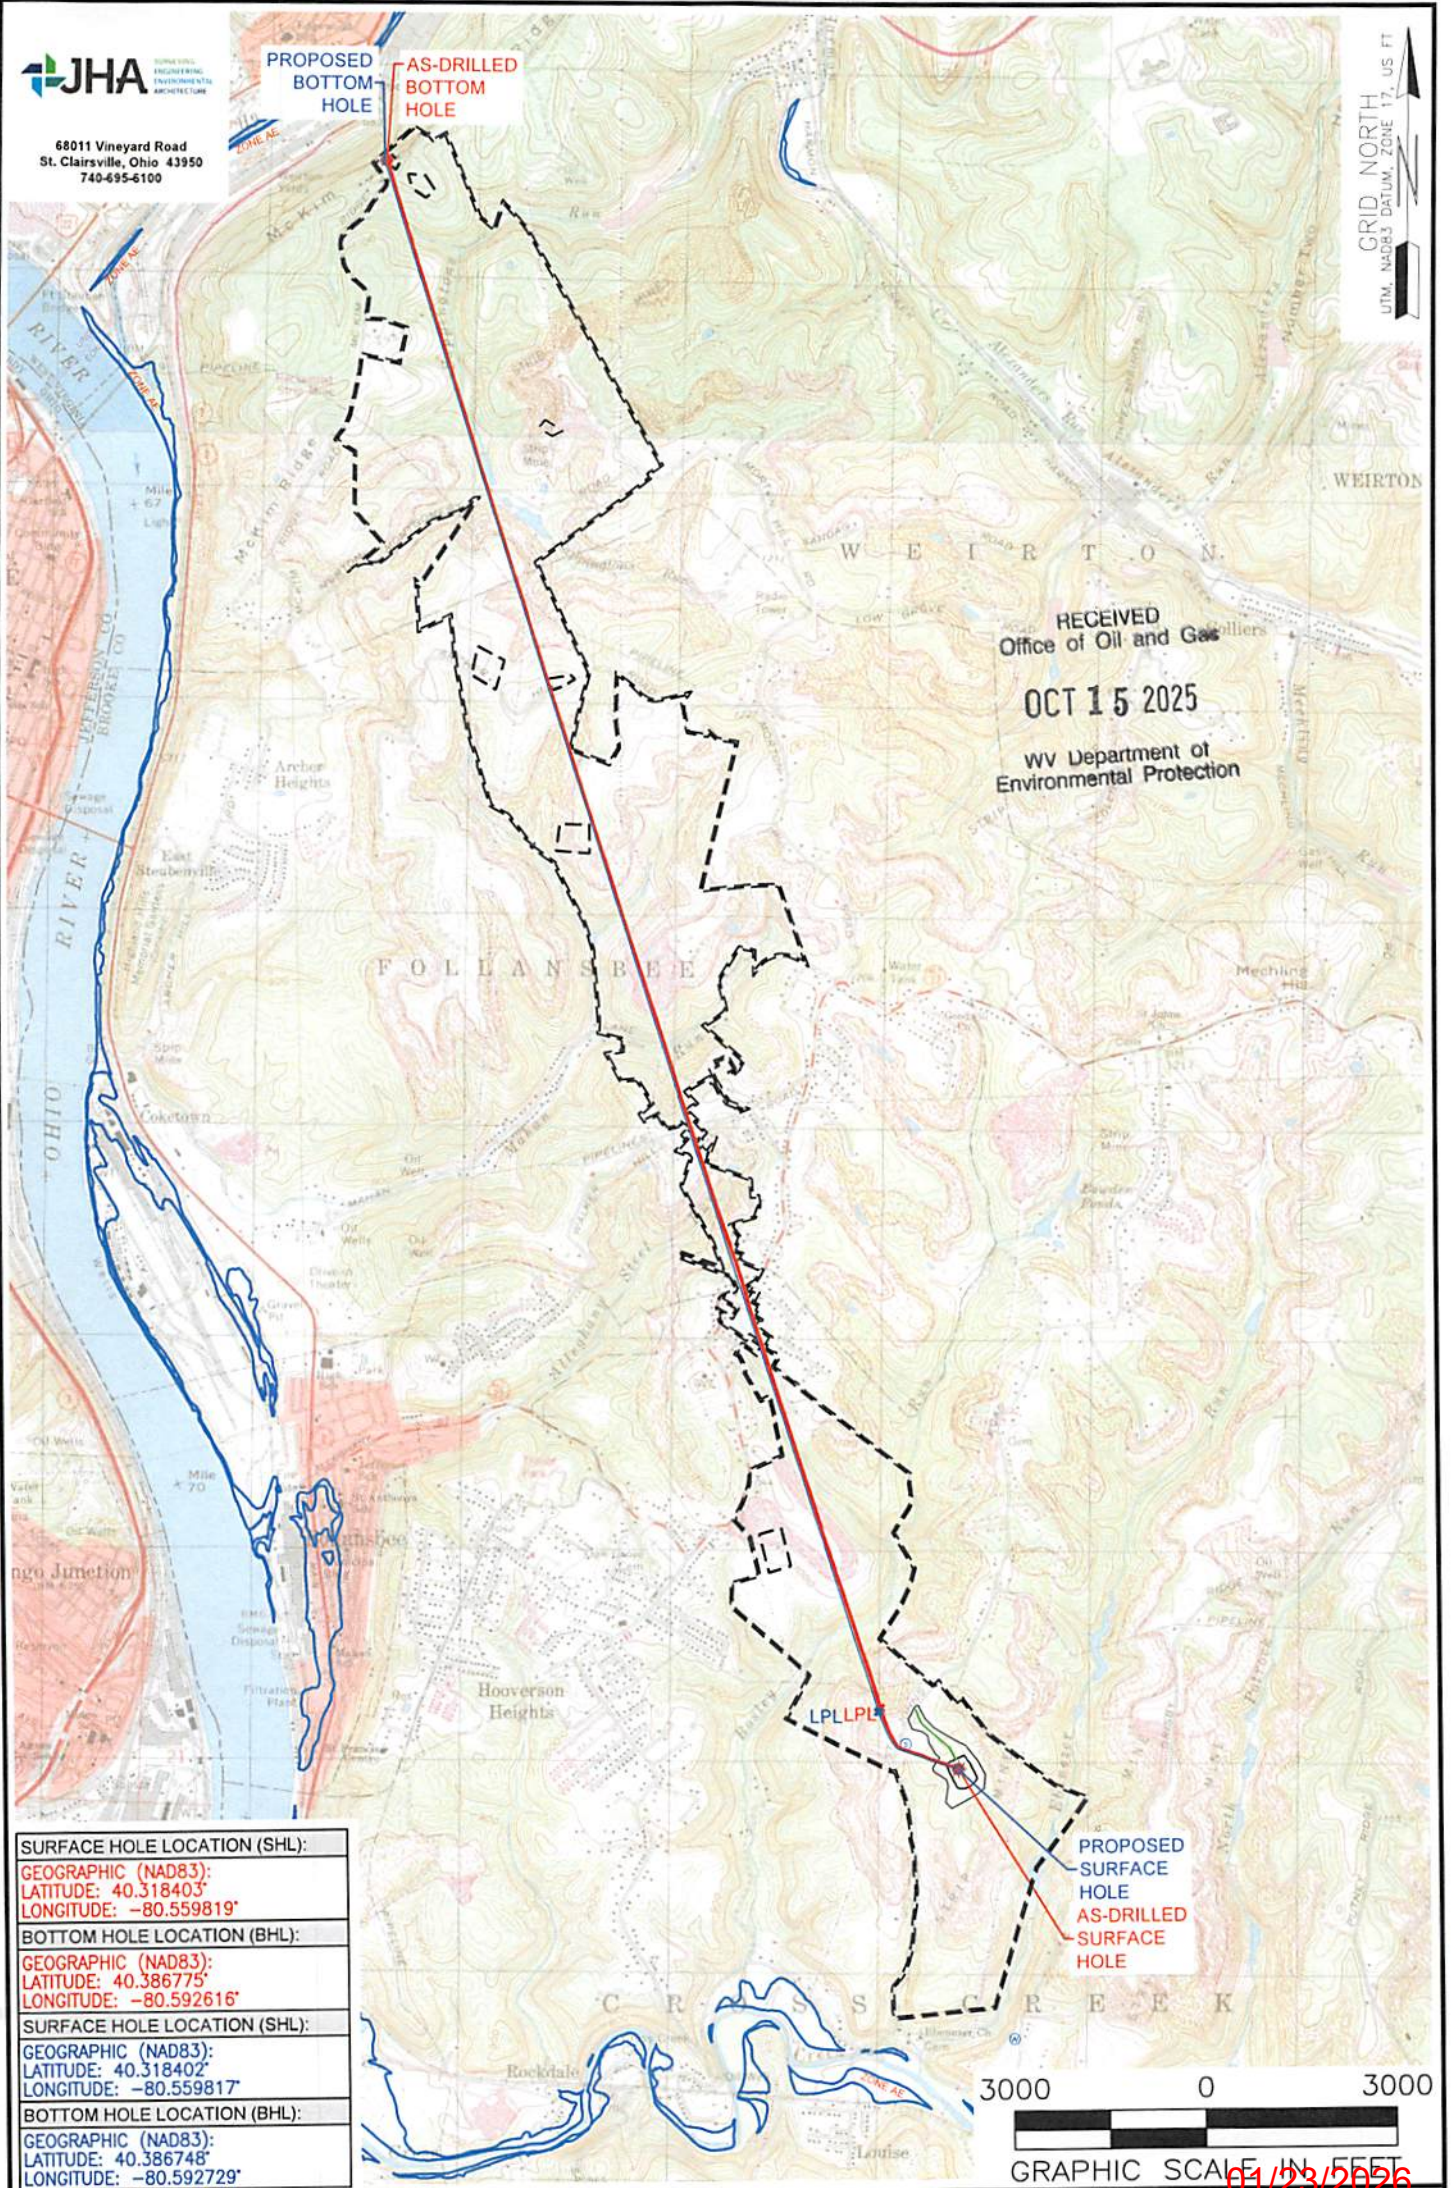

SURFACE HOLE LOCATION (SHL):
GEOGRAPHIC (NAD83):
LATITUDE: 40.318403°
LONGITUDE: -80.559819°
BOTTOM HOLE LOCATION (BHL):
GEOGRAPHIC (NAD83):
LATITUDE: 40.386775°
LONGITUDE: -80.592616°
SURFACE HOLE LOCATION (SHL):
GEOGRAPHIC (NAD83):
LATITUDE: 40.318402°
LONGITUDE: -80.559817°
BOTTOM HOLE LOCATION (BHL):
GEOGRAPHIC (NAD83):
LATITUDE: 40.386748°
LONGITUDE: -80.592729°

NOTES ON SURVEY

1. SURFACE AND ROYALTY OWNER INFORMATION AND THEIR BOUNDARIES SHOWN HEREON WERE PLOTTED FROM DEEDS AND/OR TAX PARCEL MAPS PROVIDED BY CLIENT AND/OR FIELD LOCATIONS.
2. THIS PLAT DOES NOT REPRESENT A BOUNDARY SURVEY OF THE PARCELS SHOWN HEREON.
3. ALL INSETS ARE GRID NORTH UNLESS OTHERWISE DEPICTED.

LEGEND:

- | | | | |
|--|-------------------------------------|--|-----------------|
| | EXISTING BOTTOM HOLE | | ACCESS ROAD |
| | EXISTING / PRODUCING WELLHEAD | | PUBLIC ROAD |
| | EXISTING LANDING POINT LOCATION | | FLOOD PLAIN |
| | PROPOSED SURFACE HOLE / BOTTOM HOLE | | LEASE BOUNDARY |
| | PROPOSED LANDING POINT LOCATION | | AS-DRILLED PATH |
| | | | PROPOSED PATH |


WELL OPERATOR:
SWN PRODUCTION COMPANY, LLC
ADDRESS:
1300 FORT PIERPONT DRIVE, SUITE 201, MORGANTOWN, WV 26508
SURFACE OWNER:
GERALD GOURLEY

WELL (FARM) NAME: GERALD GOURLEY BRK	WELL # 1H	SERIAL # XXXX
COUNTY: BROOKE	CODE: 009	DISTRICT: CROSS CREEK
API # 47-009-00345		
USGS 7 1/2 QUADRANGLE MAP NAME: STUBENVILLE EAST/WEIRTON, WV		

LATITUDE: 40°20'00" SURFACE HOLE (2000' SCALE) 5247' 2640' 5608' 10846' LONGITUDE: 80°32'30" SURFACE HOLE (2000' SCALE)

JHA
68011 Vineyard Road
St. Clairsville, Ohio 43950
740-695-6100

LINE	BEARING	DISTANCE
L1	N78°39'57"E	2874.51'
L2	S39°20'47"E	3312.46'

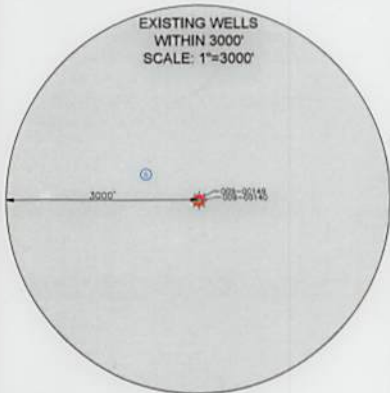

NOTES ON SURVEY

1. COORDINATE SYSTEM IS UTM NAD 83 DATUM, ZONE 17, U.S. FOOT AND WELL COORDINATES ESTABLISHED USING SURVEY GRADE GPS.
2. SURFACE AND ROYALTY OWNER INFORMATION AND THEIR BOUNDARIES SHOWN HEREON WERE PLOTTED FROM DEEDS AND/OR TAX PARCEL MAPS PROVIDED BY CLIENT AND/OR FIELD LOCATIONS.
3. THIS PLAT DOES NOT REPRESENT A BOUNDARY SURVEY OF THE PARCELS SHOWN HEREON.
4. NO DWELLINGS OR BUILDINGS WITHIN 625 FEET OF PROPOSED CENTER OF PAD.
5. NO PERENNIAL STREAMS, LAKES, PONDS, RESERVOIRS OR WETLANDS WITHIN 100 FEET OF THE LIMITS OF DISTURBANCE.
6. NO NATURALLY PRODUCING TROUT STREAM WITHIN 300 FEET OF THE LIMITS OF DISTURBANCE.
7. NO WATER WELLS OR DEVELOPED SPRINGS WITHIN 250 FEET OF PROPOSED WELL.

SURFACE HOLE LOCATION (SHL): UTM (NAD83, ZONE 17, METERS): NORTHING: 4463190.79 EASTING: 537398.72
LANDING POINT LOCATION (LPL): UTM (NAD83, ZONE 17, METERS): NORTHING: 4463478.33 EASTING: 537026.74
BOTTOM HOLE LOCATION (BHL): UTM (NAD83, ZONE 17, METERS): NORTHING: 4470766.54 EASTING: 534577.19
SURFACE HOLE LOCATION (SHL): UTM (NAD83, ZONE 17, METERS): NORTHING: 4463190.66 EASTING: 537398.83
LANDING POINT LOCATION (LPL): UTM (NAD83, ZONE 17, METERS): NORTHING: 4463460.20 EASTING: 537018.81
BOTTOM HOLE LOCATION (BHL): UTM (NAD83, ZONE 17, METERS): NORTHING: 4470763.56 EASTING: 534567.66

I, THE UNDERSIGNED, HEREBY CERTIFY THAT THIS PLAT IS CORRECT TO THE BEST OF MY KNOWLEDGE AND BELIEF AND SHOWS ALL THE INFORMATION REQUIRED BY LAW AND REGULATIONS ISSUED AND PRESCRIBED BY THE DEPARTMENT OF ENVIRONMENTAL PROTECTION.

P.E. 19809



COMPANY:

expand

	(*) DENOTES LOCATION OF WELL ON UNITED STATES TOPOGRAPHIC MAPS	MINIMUM DEGREE OF ACCURACY: 1/200	GERALD GOURLEY BRK		
	WVDEP OFFICE OF OIL & GAS 601 57TH STREET CHARLESTON, WV 25034	PROVEN SOURCE OF ELEVATION: SURVEY GRADE GPS (NAVD 88, US FT)	OPERATOR'S WELL #:	1H	
			API WELL #:	47	009 00345
			STATE	COUNTY	PERMIT
WELL TYPE: OIL ☐ WASTE DISPOSAL ☐ PRODUCTION ☒ DEEP ☐ GAS ☒ LIQUID INJECTION ☐ STORAGE ☐ SHALLOW ☒		ELEVATION: 1154.8'			
WATERSHED: UPPER OHIO SOUTH		QUADRANGLE: STEUBENVILLE EAST, WV			
DISTRICT: CROSS CREEK		ACREAGE: ±173.00			
COUNTY: BROOKE		ACREAGE: ±173.00			
SURFACE OWNER: GERALD GOURLEY					
OIL & GAS ROYALTY OWNER: GERALD GOURLEY					
DRILL ☐ DRILL DEEPER ☐ REDRILL ☐ FRACTURE OR STIMULATE ☐ PLUG OFF OLD FORMATION ☐ PERFORATE NEW FORMATION ☐					
CONVERT ☐ PLUG & ABANDON ☐ CLEAN OUT & REPLUG ☐ OTHER CHANGE ☒ (SPECIFY) AS-DRILLED					
TARGET FORMATION: MARCELLUS		ESTIMATED DEPTH: 5,683' TVD 31,466' TMD			

WELL OPERATOR: SWN PRODUCTION COMPANY, LLC		DESIGNATED AGENT: BRITTANY WOODY	
ADDRESS: 1300 FORT PIERPONT DRIVE, SUITE 201		ADDRESS: 1300 FORT PIERPONT DRIVE, SUITE 201	
CITY: MORGANTOWN		CITY: MORGANTOWN	
STATE: WV		STATE: WV	
ZIP CODE: 26508		ZIP CODE: 26508	
LEGEND:		REVISIONS:	
- EXISTING BOTTOM HOLE - EXISTING / PRODUCING WELLHEAD - EXISTING LANDING POINT LOCATION - PROPOSED SURFACE HOLE / BOTTOM HOLE - PROPOSED LANDING POINT LOCATION		- ACCESS ROAD - PUBLIC ROAD - FLOOD PLAIN - LEASE BOUNDARY - ASDRILLED PATH - PROPOSED PATH	
		DATE: 05-08-2025	
		API NO: 47-009-00345	
		DRAWN BY: Z. WOOD	
		SCALE: 1" = 2000'	
		DRAWING NO: 2024-1300	
		WELL LOCATION PLAT	

LATITUDE: 40°20'00" SURFACE HOLE (2000' SCALE)

5247'


LATITUDE: 40°25'00" BOTTOM HOLE (2000' SCALE)

2640'



68011 Vineyard Road
St. Clairsville, Ohio 43950
740-695-6100

LINE	BEARING	DISTANCE
L1	N78°39'57"E	2874.51'
L2	S39°20'47"E	3312.46'

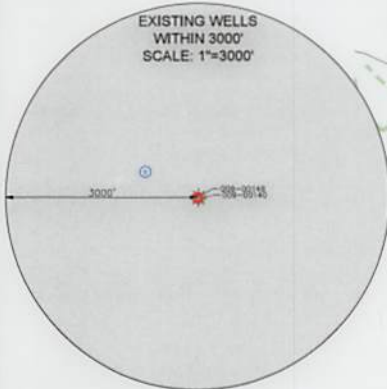

NOTES ON SURVEY

1. COORDINATE SYSTEM IS UTM NAD 83 DATUM, ZONE 17, U.S. FOOT AND WELL COORDINATES ESTABLISHED USING SURVEY GRADE GPS.
2. SURFACE AND ROYALTY OWNER INFORMATION AND THEIR BOUNDARIES SHOWN HEREON WERE PLOTTED FROM DEEDS AND/OR TAX PARCEL MAPS PROVIDED BY CLIENT AND/OR FIELD LOCATIONS.
3. THIS PLAT DOES NOT REPRESENT A BOUNDARY SURVEY OF THE PARCELS SHOWN HEREON.
4. NO DWELLINGS OR BUILDINGS WITHIN 625 FEET OF PROPOSED CENTER OF PAD.
5. NO PERENNIAL STREAMS, LAKES, PONDS, RESERVOIRS OR WETLANDS WITHIN 100 FEET OF THE LIMITS OF DISTURBANCE.
6. NO NATURALLY PRODUCING TROUT STREAM WITHIN 300 FEET OF THE LIMITS OF DISTURBANCE.
7. NO WATER WELLS OR DEVELOPED SPRINGS WITHIN 250 FEET OF PROPOSED WELL.

SURFACE HOLE LOCATION (SHL):
UTM (NAD83, ZONE 17, METERS):
NORTHING: 4463190.79
EASTING: 537398.72
LANDING POINT LOCATION (LPL):
UTM (NAD83, ZONE 17, METERS):
NORTHING: 4463478.33
EASTING: 537026.74
BOTTOM HOLE LOCATION (BHL):
UTM (NAD83, ZONE 17, METERS):
NORTHING: 4470766.54
EASTING: 534577.19
SURFACE HOLE LOCATION (SHL):
UTM (NAD83, ZONE 17, METERS):
NORTHING: 4463190.66
EASTING: 537398.83
LANDING POINT LOCATION (LPL):
UTM (NAD83, ZONE 17, METERS):
NORTHING: 4463460.20
EASTING: 537018.81
BOTTOM HOLE LOCATION (BHL):
UTM (NAD83, ZONE 17, METERS):
NORTHING: 4470763.56
EASTING: 534567.66

I, THE UNDERSIGNED, HEREBY CERTIFY THAT THIS PLAT IS CORRECT TO THE BEST OF MY KNOWLEDGE AND BELIEF AND SHOWS ALL THE INFORMATION REQUIRED BY LAW AND REGULATIONS ISSUED AND PRESCRIBED BY THE DEPARTMENT OF ENVIRONMENTAL PROTECTION.

P.E. 19809



(X) DENOTES LOCATION OF WELL ON UNITED STATES TOPOGRAPHIC MAPS

WVDEP
OFFICE OF OIL & GAS
601 57TH STREET
CHARLESTON, WV 25034

MINIMUM DEGREE OF ACCURACY: 1/200
PROVEN SURVEY GRADE GPS SOURCE OF ELEVATION: (NAVD 88, US FT)

COMPANY:

expand

GERALD GOURLEY BRK

OPERATOR'S WELL #: 1H

API WELL #: 47 009 00345
STATE COUNTY PERMIT

WELL TYPE: OIL ☐ WASTE DISPOSAL ☐ PRODUCTION ☒ DEEP ☐ GAS ☒ LIQUID INJECTION ☐ STORAGE ☐ SHALLOW ☒
WATERSHED: UPPER OHIO SOUTH
DISTRICT: CROSS CREEK COUNTY: BROOKE
SURFACE OWNER: GERALD GOURLEY
OIL & GAS ROYALTY OWNER: GERALD GOURLEY
DRILL ☐ DRILL DEEPER ☐ REDRILL ☐ FRACTURE OR STIMULATE ☐ PLUG OFF OLD FORMATION ☐ PERFORATE NEW FORMATION ☐
CONVERT ☐ PLUG & ABANDON ☐ CLEAN OUT & REPLUG ☐ OTHER CHANGE ☒ (SPECIFY) AS-DRILLED
TARGET FORMATION: MARCELLUS
ELEVATION: 1154.8'
QUADRANGLE: STEUBENVILLE EAST, WV
ACREAGE: ±173.00
ACREAGE: ±173.00
ESTIMATED DEPTH: 5,683' TVD 31,466' TMD


WELL OPERATOR: SWN PRODUCTION COMPANY, LLC
ADDRESS: 1300 FORT PIERPONT DRIVE, SUITE 201
CITY: MORGANTOWN STATE: WV ZIP CODE: 26508

DESIGNATED AGENT: BRITTANY WOODY
ADDRESS: 1300 FORT PIERPONT DRIVE, SUITE 201
CITY: MORGANTOWN STATE: WV ZIP CODE: 26508


LEGEND:
EXISTING BOTTOM HOLE
EXISTING / PRODUCING WELLHEAD
EXISTING LANDING POINT LOCATION
PROPOSED SURFACE HOLE / BOTTOM HOLE
PROPOSED LANDING POINT LOCATION
ACCESS ROAD
PUBLIC ROAD
FLOOD PLAIN
LEASE BOUNDARY
AS-DRILLED PATH
PROPOSED PATH

REVISIONS:
DATE: 05-08-2025
API NO: 47-009-00345
DRAWN BY: Z. WOOD
SCALE: 1" = 2000'
DRAWING NO: 2024-1300
WELL LOCATION PLAT

INSET I
N.T.S.

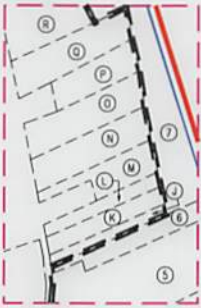

INSET II
N.T.S.

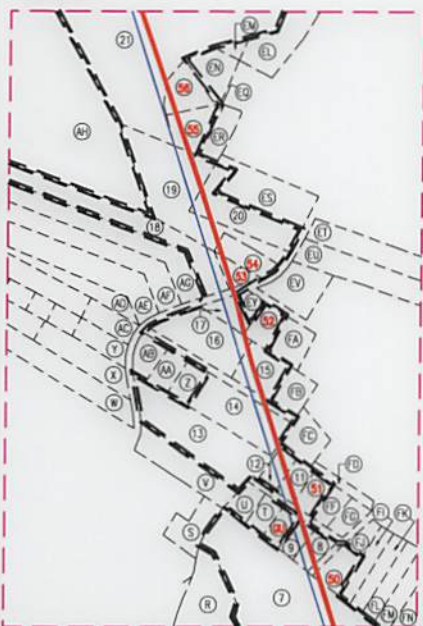

INSET III
N.T.S.



WELL BORE TABLE FOR SURFACE/ROYALTY OWNERS		
TRACT	SURFACE OWNER (S) / ROYALTY OWNER (R)	TAX PARCEL
1	GOURLEY GERALD E	4-CC19-103
TRACT	SURFACE OWNER	TAX PARCEL
2	GOURLEY GERALD E	4-CC15-42
3	YODER MELVIN A	4-CC15-42.1
4	RIHEL MARK ANTHONY; DAVID RICHARD; WILLIAM MARTIN JR	4-CC15-27
5	RIHEL MARK ANTHONY	4-C15F-22
6	NASH RAY W & VICKI M	4-C15F-21
7	MORRIS TIMOTHY GENE	4-C15F-40
8	PEARSON THEODORE T & MARY E	4-C15B-69
9	PEARSON THEODORE T & MARY E	4-C15B-70
10	REMOVED	REMOVED
11	DURBIN PENNY L	4-C15B-75
12	DURBIN PENNY L	4-C15B-74
13	PEARSON DAVID G	4-C15B-95
14	DURBIN PENNY L & STEVEN J (JTWS)	4-C15B-91
15	WELSH IRREVOCABLE TRUST & DANIEL C & PAMELA L (TRUSTEES)	4-C15B-89.1
16	STAFFORD PERRY L & PATTI L (SURV)	4-C15B-88
17	ADAMS HATTIE B	4-C15B-87
18	BROOKS MARGARET A	4-C15B-6
19	BARTRAM JARED JERIMIAH & CAROLINE ANNETTE (JTWS)	4-C15B-9
20	BARTRAM JARED JERIMIAH & CAROLINE ANNETTE (JTWS)	4-C15B-10
21	PARRISH DEBRA J	4-C11P-42
22	FODOR CAROLYN J	4-C11N-34
23	FODOR MATTHEW & PAULA	4-C11N-35
24	RYAN JACOB	4-C11N-36
25	REMOVED	REMOVED
26	BURCH MARK L & LINDA J (SURV)	4-C11N-21
27	PERMAR ROBERT A & PERMA ASHLEY M (JTWS)	4-C11N-20
28	GEARY DOUGLAS	4-C11N-16
29	LATIMER JOHN L; STARR DEBORAH S	4-C11J-12
30	LATIMER JOHN L & ANGELA JTWS	4-C11J-12.1
31	WV DEPARTMENT OF TRANSPORTATION, DIVISION OF HIGHWAYS	MAHAN LANE
32	WILLIAMS WANDA R	4-CC11-32
33	AMAIISMEIER MATTHEW J	4-CC11-3
34	CASINELLI PHILLIP P; BILLIE R JOHNSON (SURV)	4-CC11-1.7
35	HARMS ANDREW L & JENNA N (SURV)	4-CC11-1.3
36	HARMS ANDREW L & JENNA N (SURV)	4-CC11-1.8
37	HARMS ANDREW L & JENNA N (SURV)	4-CC11-1.9
38	REITTER EDWARD W JR.	4-CC11-1
39	ALLISON WILLIAM G & CHERYL A (SURVIVORSHIP)	4-CC11-1.1
40	AMAIISMEIER MATTHEW J & JILL MARIE (SURV)	4-CC6-23
41	DILLON EDWARD W TOD	4-CC7-116
42	LAUTTAMUS HOLDING INC	4-CC6-21
43	WESLEY LLC	4-CC6-15
44	WESLEY LLC	4-CC6-14

WELL BORE TABLE FOR SURFACE/ROYALTY OWNERS		
TRACT	SURFACE OWNER	TAX PARCEL
45	VALERO TERRESTRIAL CORPORATION	4-CC7-65
46	M B INVESTMENTS	4-CC6-9
47	ELY EDWARD H & BARBARA J	4-CC25-15
48	RICE TOMMY J & BARBARA J SURV & LE-CLIFFORD F & LINDA R MINGER	4-CC25-4
49	SAUNDERS HAROLD & FRANCES	4-CC25-2
50	TENNANT LOGAN	4-C15B-67
51	DURBIN PENNY L	4-C15B-76
52	JAMES LEE R & DAWN R (SURV)	4-C15B-85
53	ANDERSON BARBARA A	4-C15B-7
54	ANDERSON BARBARA ALLEN	4-C15B-8
55	MADERIA RONALD A III & DANNIELLE (JTWS)	4-C15B-17
56	O DONNELL KEVIN	4-C15B-18
57	HARMS ANDREW L & JENNA N (SURV)	4-CC11-1.12
58	WESLEY LLC	4-CC7-66
ADJOINING OWNERS TABLE		
TRACT	SURFACE OWNER	TAX PARCEL
A	GOURLEY GERALD E	4-C19K-57
B	BALLATO NICK & CHRISTOPHER	4-CC19-102
C	BALLATO NICHOLAS & CHRISTOPHER	4-CC19-192
D	GALIANO WILLIAM D & SHERRY L	4-CC19-95
E	AYERS KATHY J & JEFFREY A (JTWS)	4-C15J-221
F	GADD WILLIAM L	4-CC15-31
G	MONONGAHELA POWER CO	4-CC15-29
H	POOLE KEITH ALLEN (LE) FERRIS A JR & JANE M	4-CC15-25
I	RIGBY DON; RODNEY T	4-CC15-26
J	NASH RAY W JR & VICKI M	4-C15F-20
K	NASH RAY W JR & VICKI M SURV	4-C15F-19
L	NASH RAY W JR & VICKI M SURV	4-C15F-18
M	NASH RAY W JR & VICKI M SURV	4-C15F-16
N	BUFFINGTON SHERIDAN H	4-C15F-15
O	BUFFINGTON SHERIDAN	4-C15F-14
P	REITTER RICHARD A	4-C15F-13
Q	DUPLINSKY DAVID J & LUANN A (SURV)	4-C15F-11
R	DUPLINSKY DAVID J & LUANN A (SURV)	4-C15F-10
S	MORRIS TIMOTHY I	4-C15B-101.1
T	MORRIS TIMOTHY G & CARLA ANN	4-C15B-72
U	MORRIS TIMOTHY G & CARLA ANN	4-C15B-73
V	LILLY JAMES G & CHRISTINE Y (SURV)	4-C15B-96
W	ELIAS KEITH A AND GLENNETTE M	4-C15B-2
X	STARR GREGORY A & KATHLEEN (SURV)	4-C15B-103
Y	CUNNINGHAM CHARLES R & LINDA S (SURV)	4-C15A-4
Z	MOFFIT LAURIE	4-C15B-92
AA	ANDERSON LEWIS R & TRACEY LYNN	4-C15B-93
AB	ANDERSON LEWIS R & TRACEY LYNN	4-C15B-94
AC	KULIN JOSEPH E	4-C15A-2

REVISIONS:

COMPANY:

OPERATOR'S

WELL #:

DISTRICT:

CROSS CREEK

expand

GERALD GOURLEY BRK

1H

COUNTY:

BROOKE

STATE:

WV

DATE: 05-08-2025

API NO: 47-009-00345

DRAWN BY: Z. WOOD

SCALE: N/A

DRAWING NO: 2024-1300

WELL LOCATION PLAT

ADJOINING OWNERS TABLE		
TRACT	SURFACE OWNER	TAX PARCEL
AD	KULIN JOSEPH E	4-C15A-17
AE	LOYD DUSTIN D & KATHRYNE E (JTWS)	4-C15B-3
AF	BALDAUF DANIEL D	4-C15B-4
AG	TALLMAN RONALD L & STACEY L (SURV)	4-C15B-5
AH	BUTTENSCHON COREY W	4-C11N-28
AI	STIMPAK JOHN R & PATRICIA ANN BENZO	4-C11N-33
AJ	REMOVED	REMOVED
AK	REMOVED	REMOVED
AL	FALCON JOHN T & VICTORIA L	4-C11N-23
AM	BYERS SONYA L & WORRELL JAMES R JR (SURV)	4-C11N-15
AN	BYERS SONYA L & WORRELL JAMES R JR (SURV)	4-C11N-25
AO	VIDERMAN LINDA J R	4-C11N-26
AP	VIDERMAN LINDA J R	4-C11N-27
AQ	BUTTENSCHON COREY W	4-C11N-28
AR	WALLACE MONTY J & DORA; KUBOVICZ ROBERT A (SURV)	4-C11J-32
AS	WALLACE MONTY & DORA (SURV)	4-C11J-31
AT	WALLACE MONTY & DORA (SURV)	4-C11J-30
AU	BOYD DOROTHY L	4-C11J-29
AV	BOYD DOROTHY L	4-C11J-28
AW	SHAFFER SAMUEL P & LINDA F	4-C11J-13
AX	RICE SKYLER NATHANIEL JTWS & RICE SKYLER NATHANIEL JTWS	4-C11J-10
AY	AMAISMEIER MATTHEW J & JILL MARIE (SURV)	4-CC11-100
AZ	AMAISMEIER MATTHEW J & JILL MARIE (SURV)	4-CC10-22
BA	AMAISMEIER MATTHEW J & JILL MARIE (SURV)	4-CC10-23
BB	AMAISMEIER MATTHEW J & JILL MARIE (SURV)	4-CC10-21
BC	EMPIRE GO GREEN RECYCLING LLC	4-CC10-12
BD	DZIATKOWICZ CELESTE MARIE	4-CC6-24
BE	LAUTTAMUS HOLDINGS INC	4-CC6-20
BF	LAUTTAMUS HOLDING INC	4-CC6-19
BG	WESLEY LLC	4-CC6-14
BH	VELEGOL JOHN L JR & DAVID	4-CC6-13
BI	BEAZER EAST INC PROPERTY TAX	4-CC6-13.1
BJ	PARR DALE H & BETTY JEAN (SURV)	4-CC6-12
BK	PARR DALE H & BETTY JEAN (SURV)	4-CC6-11
BL	MCCARTHY PATRICIA A	4-CC6-5.3
BM	PARR DALE H	4-CC6-6
BN	M B INVESTMENTS	4-CC6-10
BO	PARR DALE H & BETTY	4-CC6-7
BP	PARR DALE & BETTY	4-CC6-8
BQ	MCCANN MICHAEL & APRIL (SURVIVORSHIP)	4-CC25-19
BR	ELY EDWARD SCOTT	4-CC25-14
BS	ELY EDWARD SCOTT	4-CC25-13
BT	BERRYMAN JOSEPH E	4-CC25-8
BU	BERRYMAN JOSEPH & FRANCES	4-CC25-7
BV	BERRYMAN JOSEPH	4-CC25-6
BW	BERRYMAN JOSEPH	4-CC25-5
BX	STATE OF WEST VIRGINIA DIVISION OF HIGHWAYS	ST. RT. 7
BY	MORRISSETT THOMAS J & MISTY D (SURV)	4-CC25-1.2
BZ	WELLS JAMES DALE	4-CC25-16
CA	WELLS CHARLES R & ROBINSON LISA & ROBERT (JTWS)	4-CC25-17
CB	JENKINS FOREST LEASON & ROSEMARY	4-CC25-15.1
CC	BUNKLEY GILBERT S JR	4-CC3-35
CD	VALERO TERRESTRIAL CORPORATION	4-CC7-1
CE	M B INVESTMENTS	4-CC7-63
CF	REMOVED	REMOVED
CG	MAZESKA JOHN L & AGNES	4-CC7-96
CH	REITTER EDWARD W JR	4-CC7-98.1
CI	RAINERI RICHARD K & REBECCA A (SURV)	4-CC7-115
CJ	RAINERI RICHARD K & REBECCA A (SURV)	4-CC11-1.11
CK	ALLISON WILLIAM G & CHERYL A	4-CC11-1.10
CL	KEARNS CHARLES & CINDY	4-CC11-2
CM	HENRY ASHLEY A	4-CC11-1.4
CN	KEARNS CHARLES L & CYNTHIA M (SURV)	4-CC7-98
CO	WAGNER COLE & HARRIS MARLEE (JTWS)	4-CC7-93
CP	MASON CAROLYN	4-CC7-117
CQ	MILLER JESSE ANDREW	4-CC11-4
CR	BRIGHT STEVEN R & DENEEN A (SURV)	4-CC11-5

ADJOINING OWNERS TABLE		
TRACT	SURFACE OWNER	TAX PARCEL
CS	BARKER MARK ANTHONY & CRALLE AMANDA MARIE	4-CC11-7
CT	LATIMER WILLIAM	4-CC11-16
CU	GUILER WILLIAM G II	4-CC11-24
CV	MARTIN MARY A & SWARTZ WILMA	4-CC11-36
CW	FITZPATRICK MARK A	4-CC11-28
CX	HENLINE LEONARD F	4-CC11-29
CY	FEDERAL NATIONAL MORTGAGE ASSOCIATION	4-CC11-30
CZ	WALDECK FAMILY IRR TRUST (ETAL)	4-C11K-6
DA	REED HAZEL V	4-CC11-31
DB	ZIRKLE AMANDA L	4-C11K-4
DC	OTT TIMOTHY JON & PAMELA S (SURV)	4-C11K-3
DD	OTT TIMOTHY JON & PAMELA S (SURV)	4-C11K-2
DE	TREHERNE THERESA CHERYL	4-C11K-1
DF	TENNANT DANNY G & GAIL L (L.C.)	4-C11K-27
DG	TAYLOR RAYMOND P & ROBIN E	4-C11K-28
DH	COOPER CHARLES & BARBARA A JTWS	4-C11K-29
DI	DETWILER CLIFFORD L	4-C11K-30
DJ	MAZZELLA DONNA A	4-C11K-34
DK	SIX JOHN R & DARLENE	4-C11K-138
DL	SIX JOHNNY R & DARLENE E	4-C11K-134
DM	SIX JOHN R & DARLENE	4-C11K-137
DN	STULL LISA	4-C11K-35
DO	SAMPSON IRREVOCABLE TRUST 1/22/19	4-C11K-32
DP	BYERS MARY L	4-C11K-31
DQ	BYERS MARY L	4-C11K-135
DR	THOMPSON SHAWN P & MIRANDA J (SURV)	4-C11P-21
DS	FOLDEN JUANITA JO	4-C11P-20
DT	JEFFRIES MICHAEL K & BELINDA B	4-C11P-2
DU	FROHNAPFEL TIMOTHY E & PENNY JO (SURV)	4-C11K-136
DV	ARANGO RICKY E & CANDIS (SURV)	4-C11J-35
DW	OMERY MILTON JR & AMY (SURV)	4-C11J-34
DX	OMERY MILTON C JR	4-C11J-33
DY	SPENCE STEPHEN F STARR RENEE D (JTWS)	4-C11J-37
DZ	GEARY DOUGLAS E	4-C11N-17
EA	PERMAR ROBERT & ASHLEY (SURV)	4-C11N-19
EB	AUGUSTINE ROGER & MELODIE	4-C11N-39
EC	BAILEY EARL S ET AL	4-C11N-38
ED	LATIMER JOHN	4-C11N-37
EE	STEWART GERALD L & SHARON A	4-C11P-27
EF	MOZINGO GEORGE K & MOZINGO GEORGE K &	4-C11P-35
EG	MOZINGO GEORGE K & TRACY L (SURV)	4-C11P-35.1
EH	PANNETT JAMES E JR & MARCY J	4-C11P-37
EI	GOODE STEVEN G	4-C11P-38
EJ	PARRISH DEBRA J	4-C11P-40
EK	PARRISH DEBRA J	4-C11P-43
EL	PARRISH DEBRA J	4-C11P-46
EM	GILES TIMOTHY B & ROBIN M	4-C11P-50
EN	GILES TIMOTHY B & ROBIN M (SURV)	4-C15B-19
EO	REMOVED	REMOVED
EP	REMOVED	REMOVED
EQ	MADERIA RONALD A III & DANNIELLE (JTWS)	4-C15B-16
ER	MADERIA RONALD A III & DANNIELLE (JTWS)	4-C15B-15
ES	BERESAZI EUGENIA	4-C15B-11
ET	EDWARDS TRAVIS JOHN	4-C15B-36
EU	GARNER CHARLES C & GARNER CHARLES C &	4-C15B-37
EV	SMITHBAUER STEVEN P & TEENA M (SURV)	4-C15B-38
EW	REMOVED	REMOVED
EX	REMOVED	REMOVED
EY	ADAMS HATTIE B	4-C15B-86
EZ	REMOVED	REMOVED
FA	JAMES LEE R & DAWN R (SURV)	4-C15B-84
FB	WELSH IRREVOCABLE TRUST & DANIEL C & PAMELA L (TRUSTEES)	4-C15B-89
FC	DURBIN PENNY L & STEVEN J	4-C15B-90
FD	LEMASTERS NORMAN L & ESTHER M (TOD) BAZAL JEANNETTE ROSE	4-C15B-79
FE	REMOVED	REMOVED
FF	SIMMONS DONALD WM & WILMA JO	4-C15B-77.1

REVISIONS:

COMPANY:

OPERATOR'S

WELL #:

DISTRICT:

GERALD GOURLEY BRK

1H

CROSS CREEK

COUNTY:

STATE:

BROOKE

WV

DATE: 05-08-2025

API NO: 47-009-00345

DRAWN BY: Z. WOOD

SCALE: N/A

DRAWING NO: 2024-1300

WELL LOCATION PLAT

ADJOINING OWNERS TABLE		
TRACT	SURFACE OWNER	TAX PARCEL
FG	SIMMONS DONALD WM & WILMA JO	4-C15B-77
FH	REMOVED	REMOVED
FI	PEARSON THEODORE THOMAS & MARY ELLEN (SURV)	4-C15B-68
FJ	TOMSHACK CONNIE J	4-C15B-66
FK	HORVATH JOHN A & HORVATH JOHN A &	4-C15B-65
FL	HORVATH JOHN A & HORVATH JOHN A &	4-C15B-64
FM	HIPPENSTEEL CURTIS D II	4-C15B-63
FN	GERRARD DUANE EDMOND & AMY LEE	4-C15B-62
FO	STEWART TYLER SCOTT	4-C15F-33
FP	HIPPENSTEEL CURTIS D	4-C15F-34
FQ	OHLER DENNIS J & KIMBERLY (JTWS)	4-C15F-35
FR	MORRIS TIMOTHY G & CARLA A (SURV)	4-C15F-36
FS	MORRIS TIMOTHY IAN	4-C15F-37
FT	COSTELLO GERALD L & JILL (SURV)	4-C15F-38
FU	MORRIS TIMOTHY G	4-C15F-39
FV	WALLACE DAVID & MARY BETH	4-C15G-28
FW	DAVIS JEFFREY E & SHYEN LYNN JTWS	4-C15L-68
FX	MINGER JACK R	4-C15L-69
FY	DAWSON TAYLOR B	4-C15L-27
FZ	DEAN JOHN L	4-C15L-28
GA	GOURLEY GERALD E	4-C15L-29
GB	TRAHERN FORREST D	4-CC15-47
GC	BARNHART DANIEL (LC-WILLIAM & VICKY L HERCULES)	4-CC15-45
GD	YODER MELVIN A	4-CC15-43
GE	DREXLER RENEE;MCDONALD HEATHER (LE-SAL & MARY M DREXLER)	4-CC15-42.2
GF	DREXLER RENEE;MCDONALD HEATHER (LE-SAL & MARY M DREXLER)	4-CC15-42.3
GG	DREXLER SALVATORE R & MARY M	4-CC15-64
GH	LOAR GARY LEE & SANDRA L	4-CC15-52
GI	HOBBS JOYCE ET AL	4-CC19-111
GJ	BUCY GERALD L SR & CONSTANCE F	4-CC19-117.1
GK	PARR SARAH ELIZABETH	4-CC19-119
GL	RICE TOMMY J&BARBARA J SURV & RICE TOMMY J&BARBARA J SURV	4-CC25-3
GM	ELY EDWARD H & BARBARA J	4-CC25-15.2
GN	WESLEY LLC	4-CC7-64
GO	PAULES WILLIAM J JR	4-CC6-22
GP	DILLON EDWARD WAYNE JR	4-CC7-116.1
GQ	REMOVED	REMOVED
GR	DULANEY BRADY & SHELLEY A JTWS	4-CC11-1.6
GS	DULANEY BRADY	4-CC11-1.5
GT	RIHEL DAVID RICHARD	4-CC15-27.1
GU	HAVELKA JOSEPH A	4-C15B-71
GV	BURCH MARK L & LINDA J (JTWS)	4-C11N-22
GW	MAZESKA JOHN L	4-CC7-70
GX	MAZESKA JOHN L	4-CC7-69
GY	MAZESKA JOHN L & AGNES M	4-CC7-68
GZ	MAZESKA JOHN L & AGNES	4-CC7-67

01/23/2026

REVISIONS:	COMPANY: expand			DATE: 05-08-2025	
	OPERATOR'S GERALD GOURLEY BRK			API NO: 47-009-00345	
				WELL #: 1H	
	DISTRICT: CROSS CREEK	COUNTY: BROOKE	STATE: WV	SCALE: N/A	
				DRAWING NO: 2024-1300	
				WELL LOCATION PLAT	