

58011 Vineyard Road
St. Clairsville, Ohio 43950
740-895-6166

NOTES ON SURVEY

1. SURFACE AND SUBSURFACE OWNERSHIP AND THEIR BOUNDARIES SHOWN. LINES WITH POINTS SHOW DEEDS AND/OR TAX PARCEL MAPS PROVIDED BY CLIENT AND/OR FIELD LOCATIONS.
2. THIS PLAT DOES NOT REPRESENT A BOUNDARY SURVEY OF THE PARCELS SHOWN HEREON.
3. ALL RIGHTS ARE CONSIDERED RESERVED UNLESS OTHERWISE SPECIFIED.

SURFACE HOLE LOCATION (SHL): GEOGRAPHIC (NAD83): LATITUDE: 40.318367 LONGITUDE: -80.559797 UTM (NAD83, ZONE 17, FEET): NORTHING: 14842572.13 EASTING: 1763121.63 UTM (NAD83, ZONE 17, METERS): NORTHING: 4463186.83 EASTING: 537400.55	SURFACE HOLE LOCATION (SHL): GEOGRAPHIC (NAD27): LATITUDE: 40.318239 LONGITUDE: -80.560034 UTM (NAD27, ZONE 17, FEET): NORTHING: 14842235.40 EASTING: 1763067.47
LANDING POINT LOCATION (LPL): GEOGRAPHIC (NAD83): LATITUDE: 40.318850 LONGITUDE: -80.563575 UTM (NAD83, ZONE 17, FEET): NORTHING: 14643142.49 EASTING: 1782067.82 UTM (NAD83, ZONE 17, METERS): NORTHING: 4463338.70 EASTING: 537078.30	LANDING POINT LOCATION (LPL): GEOGRAPHIC (NAD27): LATITUDE: 40.318780 LONGITUDE: -80.563781 UTM (NAD27, ZONE 17, FEET): NORTHING: 14642325.78 EASTING: 1782013.89
BOTTOM HOLE LOCATION (BHL): GEOGRAPHIC (NAD83): LATITUDE: 40.283109 LONGITUDE: -80.616476 UTM (NAD83, ZONE 17, FEET): NORTHING: 14622980.74 EASTING: 1769727.58 UTM (NAD83, ZONE 17, METERS): NORTHING: 4457062.90 EASTING: 539414.05	BOTTOM HOLE LOCATION (BHL): GEOGRAPHIC (NAD27): LATITUDE: 40.283034 LONGITUDE: -80.560684 UTM (NAD27, ZONE 17, FEET): NORTHING: 14622163.96 EASTING: 1769673.29
SURFACE HOLE LOCATION (SHL): GEOGRAPHIC (NAD83): LATITUDE: 40.318367 LONGITUDE: -80.559796 UTM (NAD83, ZONE 17, FEET): NORTHING: 14642972.06 EASTING: 1763122.04 UTM (NAD83, ZONE 17, METERS): NORTHING: 4463186.81 EASTING: 537400.67	SURFACE HOLE LOCATION (SHL): GEOGRAPHIC (NAD27): LATITUDE: 40.318298 LONGITUDE: -80.560002 UTM (NAD27, ZONE 17, FEET): NORTHING: 664037.60 EASTING: 1704405.06
LANDING POINT LOCATION (LPL): GEOGRAPHIC (NAD83): LATITUDE: 40.319539 LONGITUDE: -80.563887 UTM (NAD83, ZONE 17, FEET): NORTHING: 14643393.20 EASTING: 1761979.40 UTM (NAD83, ZONE 17, METERS): NORTHING: 4463315.17 EASTING: 537052.40	LANDING POINT LOCATION (LPL): GEOGRAPHIC (NAD27): LATITUDE: 40.319470 LONGITUDE: -80.564094 UTM (NAD27, ZONE 17, FEET): NORTHING: 664478.02 EASTING: 1703269.22
BOTTOM HOLE LOCATION (BHL): GEOGRAPHIC (NAD83): LATITUDE: 40.263089 LONGITUDE: -80.536523 UTM (NAD83, ZONE 17, FEET): NORTHING: 14622875.00 EASTING: 1769714.50 UTM (NAD83, ZONE 17, METERS): NORTHING: 4457061.21 EASTING: 539410.08	BOTTOM HOLE LOCATION (BHL): GEOGRAPHIC (NAD27): LATITUDE: 40.263018 LONGITUDE: -80.536731 UTM (NAD27, ZONE 17, FEET): NORTHING: 643924.93 EASTING: 1710661.95



RECEIVED
Office of Oil and Gas
OCT 15 2025
WV Department of
Environmental Protection

6000 0 6000

GRAPHIC SCALE IN FEET



NOTE: ANY UTILITIES OR IMPROVEMENTS SHOWN ON THIS PLAN ARE EITHER REASONABLE VISUAL OBSERVATIONS. NO UTILITY COMPANIES WERE CONTACTED FOR UTILITY LINE LOCATIONS.

LEGEND:

- AS-DRILLED SURFACE HOLE / BASTION HOLE
- EXISTING / PROPOSED ADJACENT
- ABANDONED WELL
- FILL/GET & ABANDONED WELL
- LPL* LANDING POINT LOCATION
- PRELIMINARY EXPLORING UNIT
- LEAD BOUNDARY
- CARBONATE BOUNDARY
- NATURAL WATERWAY
- MAR 2 > MARCELLUS PATH

COMPANY:



OPERATOR'S

GERALD GOURLEY BRK

WELL #:

6H

DISTRICT:

COUNTY:

STATE:

CROSS CREEK

BROOKE

WV

SWN PRODUCTION COMPANY, LLC
SURFACE HOLES

1. "GERALD GOURLEY 1946 111"
3. "GERALD GOURLEY BRK 31"
6. "GERALD GOURLEY 1946 124"
8. "GERALD GOURLEY BRK 64"

REVISIONS:

DATE: 05-08-2025

API NO: 47-009-00346

DRAWN BY:Z. WOOD

SCALE: 1" = 6000'


DRAWING NO:2024-1306

INTERNAL WELL PLAT



68011 Vineyard Road
St. Clairsville, Ohio 43950
740-695-6100

GRID NORTH
UTM, NAD83 DATUM, ZONE 17, US FT

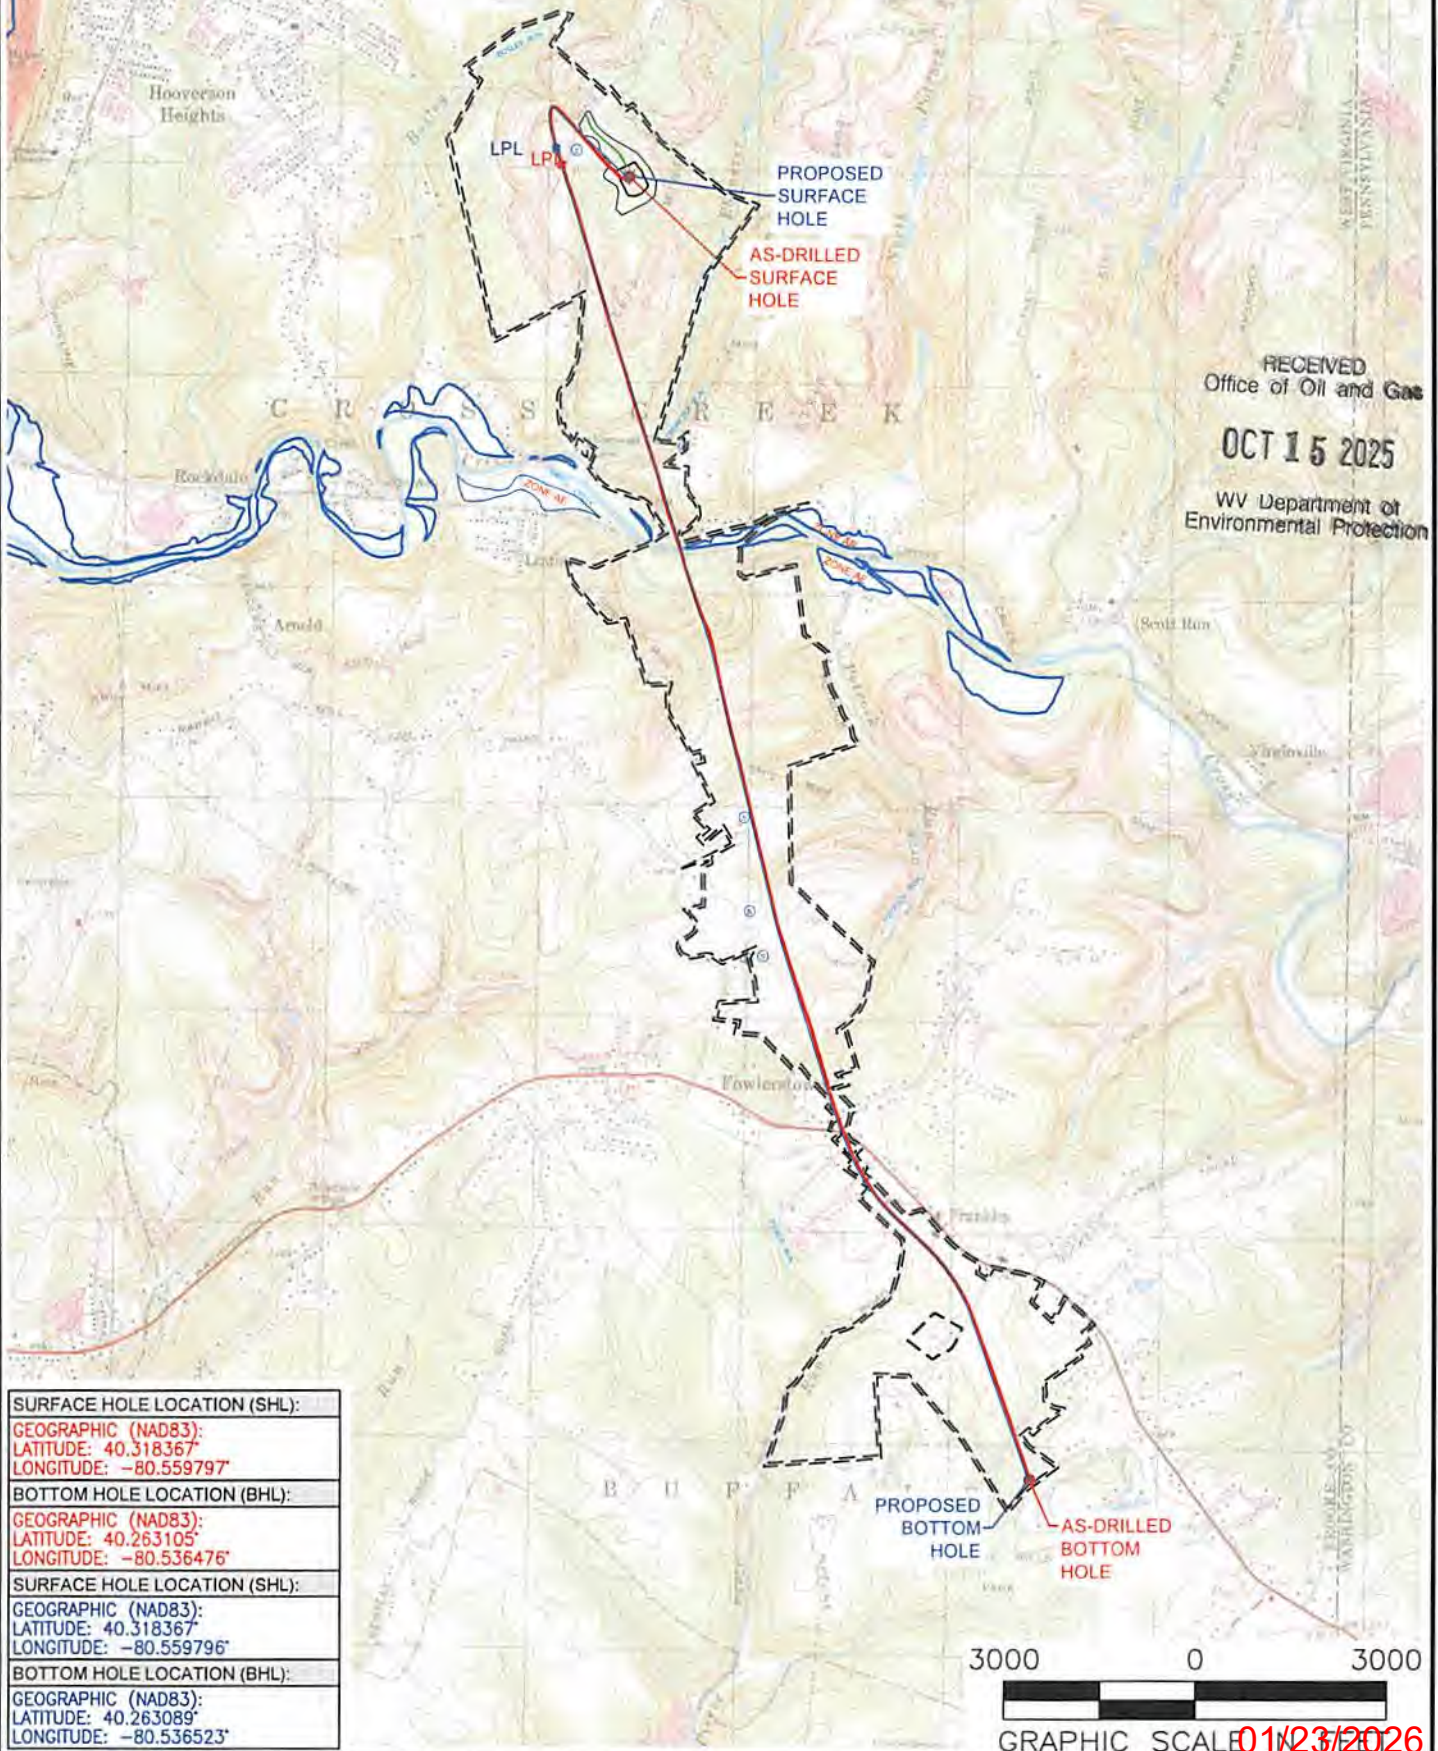

RECEIVED
Office of Oil and Gas
OCT 15 2025
WV Department of
Environmental Protection

SURFACE HOLE LOCATION (SHL):
GEOGRAPHIC (NAD83):
LATITUDE: 40.318367°
LONGITUDE: -80.559797°
BOTTOM HOLE LOCATION (BHL):
GEOGRAPHIC (NAD83):
LATITUDE: 40.263105°
LONGITUDE: -80.536476°
SURFACE HOLE LOCATION (SHL):
GEOGRAPHIC (NAD83):
LATITUDE: 40.318367°
LONGITUDE: -80.559796°
BOTTOM HOLE LOCATION (BHL):
GEOGRAPHIC (NAD83):
LATITUDE: 40.263089°
LONGITUDE: -80.536523°

NOTES ON SURVEY

1. SURFACE AND ROYALTY OWNER INFORMATION AND THEIR BOUNDARIES SHOWN HEREON WERE PLOTTED FROM DEEDS AND/OR TAX PARCEL MAPS PROVIDED BY CLIENT AND/OR FIELD LOCATIONS
2. THIS PLAT DOES NOT REPRESENT A BOUNDARY SURVEY OF THE PARCELS SHOWN HEREON.
3. ALL INSETS ARE GRID NORTH UNLESS OTHERWISE DEPICTED.

LEGEND:

- PROPOSED SURFACE HOLE / BOTTOM HOLE
- EXISTING / PRODUCING WELLHEAD
- LPL LANDING POINT LOCATION
- FLOOD PLAIN
- NATURAL WATERWAY
- ACCESS ROAD
- PUBLIC ROAD
- ACCESS ROAD TO PREV. SITE
- LEASE BOUNDARY
- PROPOSED PATH

WELL OPERATOR: SWN PRODUCTION COMPANY, LLC	WELL (FARM) NAME: GERALD GOURLEY BRK	WELL # 6H	SERIAL # XXXX
ADDRESS: 1300 FORT PIERPONT DRIVE, SUITE 201, MORGANTOWN, WV 26508	COUNTY: BROOKE	CODE: 009	DISTRICT: CROSS CREEK
SURFACE OWNER: GERALD GOURLEY	USGS 7 1/2 QUADRANGLE MAP NAME: STUEBENVILLE EAST, WV	API # 47-009-00346	

As-Drilled

LATITUDE: 40°20'00" SURFACE HOLE (2000' SCALE)


5241'

10233'
LATITUDE: 40°17'30" BOTTOM HOLE (2000' SCALE)



68011 Vineyard Road
St. Clairsville, Ohio 43950
740-695-6100

LINE	BEARING	DISTANCE
L1	N78°26'03"W	2882.77'
L2	S39°34'03"E	3306.07'

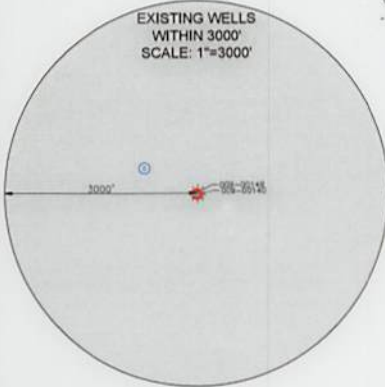

NOTES ON SURVEY

- COORDINATE SYSTEM IS UTM NAD 83 DATUM, ZONE 17, U.S. FOOT AND WELL COORDINATES ESTABLISHED USING SURVEY GRADE GPS.
- SURFACE AND ROYALTY OWNER INFORMATION AND THEIR BOUNDARIES SHOWN HEREON WERE PLOTTED FROM DEEDS AND/OR TAX PARCEL MAPS PROVIDED BY CLIENT AND/OR FIELD LOCATIONS.
- THIS PLAT DOES NOT REPRESENT A BOUNDARY SURVEY OF THE PARCELS SHOWN HEREON.
- NO DWELLINGS OR BUILDINGS WITHIN 625 FEET OF PROPOSED CENTER OF PAD.
- NO PERENNIAL STREAMS, LAKES, PONDS, RESERVOIRS OR WETLANDS WITHIN 100 FEET OF THE LIMITS OF DISTURBANCE.
- NO NATURALLY PRODUCING TROUT STREAM WITHIN 300 FEET OF THE LIMITS OF DISTURBANCE.
- NO WATER WELLS OR DEVELOPED SPRINGS WITHIN 250 FEET OF PROPOSED WELL.

SURFACE HOLE LOCATION (SHL):
UTM (NAD83, ZONE 17, METERS):
NORTHING: 4463186.83
EASTING: 537400.55
LANDING POINT LOCATION (LPL):
UTM (NAD83, ZONE 17, METERS):
NORTHING: 4463238.76
EASTING: 537079.35
BOTTOM HOLE LOCATION (BHL):
UTM (NAD83, ZONE 17, METERS):
NORTHING: 4457062.96
EASTING: 539414.05
SURFACE HOLE LOCATION (SHL):
UTM (NAD83, ZONE 17, METERS):
NORTHING: 4463186.81
EASTING: 537400.67
LANDING POINT LOCATION (LPL):
UTM (NAD83, ZONE 17, METERS):
NORTHING: 4463315.17
EASTING: 537052.40
BOTTOM HOLE LOCATION (BHL):
UTM (NAD83, ZONE 17, METERS):
NORTHING: 4457061.21
EASTING: 539410.06

I, THE UNDERSIGNED, HEREBY CERTIFY THAT THIS PLAT IS CORRECT TO THE BEST OF MY KNOWLEDGE AND BELIEF AND SHOWS ALL THE INFORMATION REQUIRED BY LAW AND REGULATIONS ISSUED AND PRESCRIBED BY THE DEPARTMENT OF ENVIRONMENTAL PROTECTION.

P.E. 19809



COMPANY:

expand



(H) DENOTES LOCATION OF WELL ON UNITED STATES TOPOGRAPHIC MAPS

WVDEP
OFFICE OF OIL & GAS
601 57TH STREET
CHARLESTON, WV 25034

MINIMUM DEGREE OF ACCURACY: 1/200
PROVEN SURVEY GRADE GPS
SOURCE OF ELEVATION: (NAVD 88, US FT)

GERALD GOURLEY BRK
OPERATOR'S WELL #: 6H
API WELL #: 47 009 00346
STATE COUNTY PERMIT

WELL TYPE: OIL ☐ WASTE DISPOSAL ☐ PRODUCTION ☒ DEEP ☐ GAS ☒ LIQUID INJECTION ☐ STORAGE ☐ SHALLOW ☒
WATERSHED: UPPER OHIO SOUTH
DISTRICT: CROSS CREEK COUNTY: BROOKE
SURFACE OWNER: GERALD GOURLEY
OIL & GAS ROYALTY OWNER: GERALD GOURLEY
DRILL ☐ DRILL DEEPER ☐ REDRILL ☐ FRACTURE OR STIMULATE ☐ PLUG OFF OLD FORMATION ☐ PERFORATE NEW FORMATION ☐
CONVERT ☐ PLUG & ABANDON ☐ CLEAN OUT & REPLUG ☐ OTHER CHANGE ☒ (SPECIFY) AS-DRILLED
TARGET FORMATION: MARCELLUS
ELEVATION: 1154.9'
QUADRANGLE: STEUBENVILLE EAST, WV
ACREAGE: ±173.00
ACREAGE: ±173.00
ESTIMATED DEPTH: 5,906' TVD 28,602' TMD

WELL OPERATOR: SWN PRODUCTION COMPANY, LLC
ADDRESS: 1300 FORT PIERPONT DRIVE, SUITE 201
CITY: MORGANTOWN STATE: WV ZIP CODE: 26508
DESIGNATED AGENT: BRITTANY WOODY
ADDRESS: 1300 FORT PIERPONT DRIVE, SUITE 201
CITY: MORGANTOWN STATE: WV ZIP CODE: 26508

LEGEND:	REVISIONS:	DATE: 05-08-2025
● EXISTING BOTTOM HOLE	ACCESS ROAD	API NO: 47-009-00346
★ EXISTING / PRODUCING WELLHEAD	PUBLIC ROAD	DRAWN BY: Z. WOOD
LPL★ EXISTING LANDING POINT LOCATION	FLOOD PLAIN	SCALE: 1" = 2000'
● PROPOSED SURFACE HOLE / BOTTOM HOLE	LEASE BOUNDARY	DRAWING NO: 2024-1300
LPL★ PROPOSED LANDING POINT LOCATION	ASDRILLED PATH	WELL LOCATION PLAT
	PROPOSED PATH	

As-Drilled

LATITUDE: 40°20'00" SURFACE HOLE (2000' SCALE)

5241'


10233'

LATITUDE: 40°17'30" BOTTOM HOLE (2000' SCALE)



68011 Vineyard Road
St. Clairsville, Ohio 43950
740-695-6100

LINE	BEARING	DISTANCE
L1	N78°26'03"W	2882.77'
L2	S39°34'03"E	3306.07'

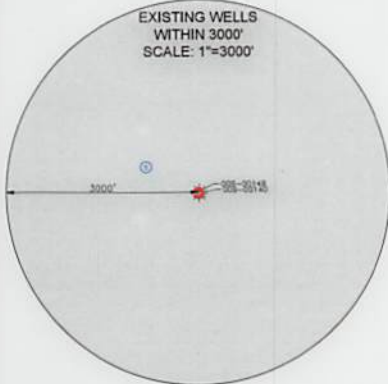

NOTES ON SURVEY

- COORDINATE SYSTEM IS UTM NAD 83 DATUM, ZONE 17, U.S. FOOT AND WELL COORDINATES ESTABLISHED USING SURVEY GRADE GPS.
- SURFACE AND ROYALTY OWNER INFORMATION AND THEIR BOUNDARIES SHOWN HEREON WERE PLOTTED FROM DEEDS AND/OR TAX PARCEL MAPS PROVIDED BY CLIENT AND/OR FIELD LOCATIONS.
- THIS PLAT DOES NOT REPRESENT A BOUNDARY SURVEY OF THE PARCELS SHOWN HEREON.
- NO DWELLINGS OR BUILDINGS WITHIN 625 FEET OF PROPOSED CENTER OF PAD.
- NO PERENNIAL STREAMS, LAKES, PONDS, RESERVOIRS OR WETLANDS WITHIN 100 FEET OF THE LIMITS OF DISTURBANCE.
- NO NATURALLY PRODUCING TROUT STREAM WITHIN 300 FEET OF THE LIMITS OF DISTURBANCE.
- NO WATER WELLS OR DEVELOPED SPRINGS WITHIN 250 FEET OF PROPOSED WELL.

SURFACE HOLE LOCATION (SHL):

UTM (NAD83, ZONE 17, METERS):
NORTHING: 4463186.83
EASTING: 537400.55

LANDING POINT LOCATION (LPL):

UTM (NAD83, ZONE 17, METERS):
NORTHING: 4463238.76
EASTING: 537079.35

BOTTOM HOLE LOCATION (BHL):

UTM (NAD83, ZONE 17, METERS):
NORTHING: 4457062.96
EASTING: 539414.05

SURFACE HOLE LOCATION (SHL):

UTM (NAD83, ZONE 17, METERS):
NORTHING: 4463186.81
EASTING: 537400.67

LANDING POINT LOCATION (LPL):


UTM (NAD83, ZONE 17, METERS):
NORTHING: 4463315.17
EASTING: 537052.40

BOTTOM HOLE LOCATION (BHL):

UTM (NAD83, ZONE 17, METERS):
NORTHING: 4457061.21
EASTING: 539410.06

I, THE UNDERSIGNED, HEREBY CERTIFY THAT THIS PLAT IS CORRECT TO THE BEST OF MY KNOWLEDGE AND BELIEF AND SHOWS ALL THE INFORMATION REQUIRED BY LAW AND REGULATIONS ISSUED AND PRESCRIBED BY THE DEPARTMENT OF ENVIRONMENTAL PROTECTION.

P.E. 19809

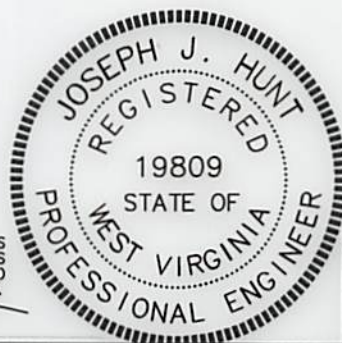

2000 0 2000

GRAPHIC SCALE IN FEET

COMPANY:

expand



(*) DENOTES LOCATION OF WELL ON UNITED STATES TOPOGRAPHIC MAPS

WVDEP
OFFICE OF OIL & GAS
601 57TH STREET
CHARLESTON, WV 25034

MINIMUM
DEGREE OF
ACCURACY: 1/200

PROVEN
SOURCE OF
ELEVATION: SURVEY
GRADE GPS
(NAVD 88, US FT)

GERALD GOURLEY BRK

OPERATOR'S WELL #: 6H

API WELL #: 47 009 00346
STATE COUNTY PERMIT

WELL TYPE: OIL ☐ WASTE DISPOSAL ☐ PRODUCTION ☒ DEEP ☐ GAS ☒ LIQUID INJECTION ☐ STORAGE ☐ SHALLOW ☒
WATERSHED: UPPER OHIO SOUTH
DISTRICT: CROSS CREEK COUNTY: BROOKE
SURFACE OWNER: GERALD GOURLEY
OIL & GAS ROYALTY OWNER: GERALD GOURLEY
DRILL ☐ DRILL DEEPER ☐ REDRILL ☐ FRACTURE OR STIMULATE ☐ PLUG OFF OLD FORMATION ☐ PERFORATE NEW FORMATION ☐
CONVERT ☐ PLUG & ABANDON ☐ CLEAN OUT & REPLUG ☐ OTHER CHANGE ☒ (SPECIFY) AS-DRILLED
TARGET FORMATION: MARCELLUS
ELEVATION: 1154.9'
QUADRANGLE: STEUBENVILLE EAST, WV
ACREAGE: ±173.00
ACREAGE: ±173.00
ESTIMATED DEPTH: 5,906' TVD 28,602' TMD


WELL OPERATOR: SWN PRODUCTION COMPANY, LLC
ADDRESS: 1300 FORT PIERPONT DRIVE, SUITE 201
CITY: MORGANTOWN STATE: WV ZIP CODE: 26508

DESIGNATED AGENT: BRITTANY WOODY
ADDRESS: 1300 FORT PIERPONT DRIVE, SUITE 201
CITY: MORGANTOWN STATE: WV ZIP CODE: 26508

LEGEND:
● EXISTING BOTTOM HOLE
* EXISTING / PRODUCING WELLHEAD
LPL* EXISTING LANDING POINT LOCATION
● PROPOSED SURFACE HOLE / BOTTOM HOLE
LPL* PROPOSED LANDING POINT LOCATION
— ACCESS ROAD
— PUBLIC ROAD
— FLOOD PLAIN
— LEASE BOUNDARY
— AS-DRILLED PATH
— PROPOSED PATH

REVISIONS:
DATE: 05-08-2025
API NO: 47-009-00346
DRAWN BY: Z. WOOD
SCALE: 1" = 2000'
DRAWING NO: 2024-1300
WELL LOCATION PLAT

INSET I
N.T.S.

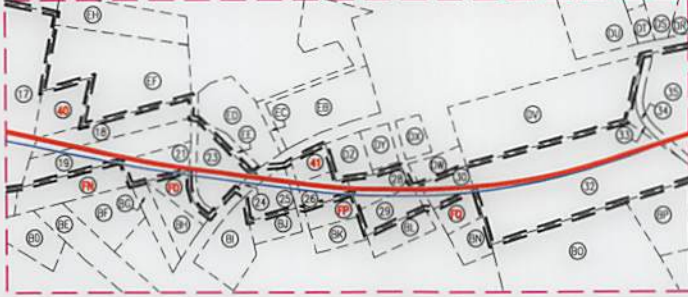

WELL BORE TABLE FOR SURFACE/ROYALTY OWNERS		
TRACT	SURFACE OWNER (S) / ROYALTY OWNER (R)	TAX PARCEL
1	GOURLEY GERALD E	4-CC19-103
TRACT	SURFACE OWNER	TAX PARCEL
2	GOURLEY GERALD E	4-CC15-42
3	YODER MELVIN A	4-CC15-42.1
4	BALLATO NICHOLAS & CHRISTOPHER	4-CC19-192
5	GOURLEY GERALD E	4-C19K-57
6	TEMPLE LLOYD (SURV)	4-CC19-108
7	LONGWELL MARTY R II & ALYSSA A (JTWS)	4-CC19-128
8	FORESHA THOMAS E & BLASKOVICH VIRGINIA M (SURV)	4-CC19-106
9	VEMURI HOME & GARDEN LLC	4-CC19-130
10	PITTSBURGH & WV RAILROAD	4-CC19-134
11	NORFOLK & WESTERN RAILWAY CO	4-C19K-18
12	PITTSBURGH & W VA RAILWAY CO	4-CC19-191
13	COOK FAMILY REVOCABLE TRUST 4/20/17, MALSON SUSAN A	4-CC23-322
14	CORWIN BRIAN	4-CC23-78
15	HUBBARD SAMUEL	4-CC23-86
16	FERGUSON JENNIFER & JESSICA	4-CC23-100
17	LYKE EUGENE F II	4-CC23-329.1
18	RYAN REBECCA	4-CC23-345
19	ROBINSON JACK	4-CC23-344
20	REMOVED	REMOVED
21	SINGH DILRAJ	4-CC23-342
22	REMOVED	REMOVED
23	PRO MOTIVE INC.	4-CC23-410
24	WV DEPARTMENT OF TRANSPORTATION, DIVISION OF HIGHWAYS	STATE ROUTE 27
25	FRESHWATER ROBERT LEE	3-B23S-5
26	WALKER GREGORY W & NANCY	3-B23S-21
27	REMOVED	REMOVED
28	WILSON EDWARD J & CINDY J SURV	3-B23S-25
29	RODEN JOEL & JULIE (SURV)	3-B23S-26
30	PEARSON GREGORY ALLEN	3-B23S-30
31	REMOVED	REMOVED
32	FRANKLIN CEMETERY ASSOC	3-B28D-60
33	FRANKLIN CEMETERY	3-B28D-61
34	WV DEPARTMENT OF TRANSPORTATION, DIVISION OF HIGHWAYS	PIERCE RUN ROAD
35	FRANKLIN CEMETERY ASSOCIATION TRUSTEES	3-B28D-66
36	PARK & RECREATION COMMISION	3-B28-66
37	POTTER FAMILY REVOCABLE TRUST	3-B29E-1
38	CARUSO ELIZABETH A	3-B29E-19
39	RADVANSKY JOHN GABRIEL	3-B29J-7
40	CHARLESWORTH DAVID	4-CC23-348
41	MAYO LOUIS P	3-B23S-22
ADJOINING OWNERS TABLE		
TRACT	SURFACE OWNER	TAX PARCEL
A	LOAR GARY LEE & SANDRA L	4-CC15-52
B	DREXLER SALVATORE R & MARY M	4-CC15-64
C	DREXLER RENEE;MCDONAL HEATHER (LE-SAL& MARY M. DREXLER)	4-CC15-42.3
D	DREXLER RENEE;MCDONAL HEATHER (LE-SAL& MARY M. DREXLER)	4-CC15-42.2
E	YODER MELVIN A	4-CC15-43
F	BARNHART DANIEL (LC-WILLIAM & VICKY L HERCULES)	4-CC15-45
G	RIHEL MARK ANTHONY; DAVID RICHARD;WILLIAM MARTIN JR	4-CC15-27
H	GALIANO WILLIAM D & SHERRY L	4-CC19-95
I	MCQUILLIAN PAUL MATTHEW L C	4-CC19-93
J	GALIANO WILLIAM D & SHERRY L	4-CC19-92
K	FURDA MARLENE & BULLOCK JAMES & MARK	4-CC19-97
L	BALLATO NICK & CHRISTOPHER	4-CC19-102
M	MARCUM HATTIE	4-C19K-54

ADJOINING OWNERS TABLE		
TRACT	SURFACE OWNER	TAX PARCEL
N	KIMBALL LAWRENCE	4-C19K-55
O	KIMBALL LAWRENCE	4-C19K-56
P	KIMBALL LAWRENCE	4-CC19-104
Q	OSETEK JOSEPH	4-C19K-53
R	NORFOLK & WESTERN RR	4-CC19-105
S	NICKOLES CAROL L	4-CC19-129
T	NORFOLK & WESTERN RR	4-CC19-105
U	SHIMKO LORI A & JOHN (JTWS) (L EST EST)MCLAIN PATRICIA A	4-C19P-45
V	PEPE TODD A;MITCHELL MICHELE R (LE-FRANCES D PEPE)	4-C19P-46
W	NELSON MARILYN L	4-C19P-47
X	CHERIPKO HELEN & ELAINE MARCUM JTWS	4-C19P-48
Y	CLARK TODD	4-CC23-51.23
Z	WILLEY MELINDA	4-CC23-51.24
AA	HART TED JR & RUTH B	4-CC23-51.4
AB	BRAHO JOSEPH M & MCGOWAN KATELYN N (JTWS)	4-CC23-66
AC	BURCH AMY J	4-CC23-67
AD	HENTHORN WILLIAM E	4-CC23-71.1
AE	WILLEY FAMILY IRREVOC TRUST 2/24/2022	4-CC23-73
AF	WILLEY FAMILY IRREVOC TRUST 2/24/2022	4-CC23-74
AG	PHILLIPS KEVIN CHARLES & HEATHER LEE (SURV)	4-CC23-74.1
AH	SPERLAZZA MARVIN P & LYNN A (SURV)	4-CC23-76
AI	ROGERSON CRYSTAL M & THOMAS E JR	4-CC23-77
AJ	NORTHVIEW PROPERTIES LLC	4-CC23-78.1
AK	HAUGHT JOSEPH B & LISA ANN (SURVIVORSHIP)	4-CC23-79
AL	SCHWERTFEGER NORMAN	4-CC23-80
AM	SCHWERTFEGER NORMAN ALAN & JEANNIE KAYE (JTWS)	4-CC23-82
AN	MEADE STEPHEN M & JACKIE D	4-CC23-83
AO	PATTERSON JAMES R	4-CC23-84
AP	PATTERSON JAMES R	4-CC23-85
AQ	GRIFFITH ROBERT ALLEN	4-CC23-101
AR	FERGUSON JENNIFER & JESSICA	4-CC23-100
AS	ROBINSON ROBERT A & JACLYN JO (SURV)	4-CC23-99
AT	HUBBARD SAMUEL H & SHELBA J (JTWS)	4-CC23-86.2
AU	ROBINSON ROBERT A & JACLYN JO (SURV)	4-CC23-86.1
AV	FELL HOWARD F	4-CC23-87
AW	HUBBARD SAMUEL H & SHELBA J (SURV)	4-CC23-88
AX	BEIHL ELWOOD F JR & PATRICIA J (SURV)	4-CC23-97
AY	MCDONOUGH JEFFREY R & ROTHWELL CHARLOTTE D (SURV)	4-CC23-89
AZ	MCDONOUGH JEFFREY R & ROTHWELL CHARLOTTE D (SURV)	4-CC23-90
BA	COOPER MARK H	4-CC23-92
BB	LYKE ANNABELLE	4-CC23-330
BC	LYKE ANNA BELLE	4-CC23-329
BD	WILSON MARK & BONNIE (JTWS)	4-CC23-332
BE	MCGOWAN CLARENCE L & KATHERINE A (SURV)	4-CC23-336
BF	SADLER JEROMY R & ASHLEY N (JTWS)	4-CC23-338
BG	MORGAN RALPH E & BERT M	4-CC23-339
BH	MORGAN RALPH M & BERT M	4-CC23-340
BI	EDWARDS MATTHEW H	3-B23S-4.1
BJ	FRESHWATER ROBERT LEE	3-B23S-6
BK	HANLON MARLA J	3-B23S-19
BL	WOODS RYAN J & KYLE B (SURV) (LE-MARK WOODS)	3-B23S-27
BM	REMOVED	REMOVED
BN	ELSON WILLIAM KEITH, ET AL.	3-B28D-59
BO	FRANKLIN CEMETERY ASSN	3-B28D-62

01/23/2026

REVISIONS:

COMPANY:

expand

OPERATOR'S GERALD GOURLEY BRK
WELL #: 47-009-00346 6H

DISTRICT:
CROSS CREEK

COUNTY:
BROOKE

STATE:
WV

DATE: 05-08-2025
API NO: 47-009-00346
DRAWN BY: Z. WOOD
SCALE: N/A
DRAWING NO: 2024-1300
WELL LOCATION PLAT

As-Drilled

ADJOINING OWNERS TABLE		
TRACT	SURFACE OWNER	TAX PARCEL
BP	MILLER JENNY L & JAMES T MCCARTY (LE)	3-B28D-63
BQ	POTTER ELIZABETH A	3-B28D-64
BR	POTTER ELIZABETH ANN	3-B28D-65
BS	BENSON ANTHONY	3-B28-51
BT	JUSTICE GREGORY MICHAEL & MARY ALICE MALONEY (LE)	3-B28-52
BU	COEN CORINNA A	3-B28-53
BV	SCHUPBACH CHARLES EDWARD	3-B28-55
BW	HANCHER ERIC; GLASURE CHARLOTTE (SURV)	3-B28-54
BX	EATON JANICE	3-B28-56
BY	HANCHER ERIC DAVID	3-B28-57
BZ	KNORR BERNARD JOHN III (L EST) KNORR BERNARD J JR % RUBY F	3-B28-57.1
CA	BROOKE COUNTY PARK COMMISSION	3-B28-64
CB	PARK & RECREATION COMMISSION	3-B28-65
CC	COPERICH RICHARD M & BELINDA A (JTWS)	3-B29J-24
CD	COPERICH RICHARD M & BELINDA A (JTWS)	3-B29J-23
CE	NIEMAN GREGORY DEAN & LAUREL ANN (SURV)	3-B29J-22
CF	NIEMAN GREG & LAUREL	3-B29J-21
CG	NIEMAN GREG & LAUREL	3-B29J-20
CH	RADVANSKY JOHN	3-B29J-19
CI	RADVANSKY JOHN G	3-B29J-18
CJ	RADVANSKY JOHN G	3-B29J-17
CK	LILLY WILLIAM J & KRISTA A (SURV)	3-B29J-16
CL	LEES MARK D & MERLINDA L (SURV)	3-B29J-6
CM	SEBECK RONALD J (TOD) MARLENE E 50 %	3-B29E-20
CN	SEBECK MARLENE E (TOD) SEBECK RONALD J 50%	3-B29E-21
CO	CARUSO ELIZABETH A	3-B29E-22
CP	CARUSO ELIZABETH A	3-B29E-23
CQ	CARUSO ELIZABETH A	3-B29E-18
CR	GIBSON EDWARD R & JOYCE C SURV	3-B29E-17
CS	TAYLOR RICHARD W & TERESA R (SURV)	3-B29E-16
CT	3-B29E-15	3-B29E-15
CU	DEMARK GREG C	3-B29E-14
CV	RIGGS DAVID & PATTI J (SURV)	3-B29E-13
CW	SALVINI MATTHEW J & TONYA D	3-B29E-12
CX	COPPA SILVERIO G & DORIS E (SURV)	3-B29E-4
CY	RADICK RONALD R & CHRISTINE (SURV)	3-B29E-3
CZ	DAYTON-WHITLATCH AMITY LAEL	3-B29E-2
DA	BALLATO CHRISTOPHER A & RUTH V (SURV)	4-CC29-98
DB	BALLATO CHRISTOPHER & RUTH (SURV)	4-CC29-95
DC	BALLATO CHRISTOPHER & RUTH (SURV)	4-CC29-94
DD	BALLATO CHRISTOPHER & RUTH (SURV)	4-CC29-93
DE	WARCHOLAK MEGHAN E	4-CC29-81
DF	JEFFRIES DIANA	4-CC29-80
DG	JEFFRIES DIANA	4-CC29-79
DH	FERGUSON WALTER & EDITH	4-CC29-78
DI	FREE METHODIST CHURCH	3-B29-4
DJ	FERGUSON JASON G	4-CC29-76
DK	RALSTON CHARLES L & SANDRA	4-CC29-5
DL	RALSTON CHARLES L & SANDRA	4-CC29-4
DM	BOARD OF EDUCATION - BROOKE COUNTY	4-CC29-3
DN	THE BROOKE COUNTY PARK & RECREATION	3-B29-2
DO	DEGARMO MARY K HERVEY	3-B29-1
DP	BERDINE KATHY L	4-CC29-1
DQ	MOORE MICHAEL A II & MOORE KIMBERLYL (JTWS)	4-CC28-11
DR	FRANKLIN METHODIST CHURCH	4-CC28-10
DS	LANCASTER DAVID	4-CC28-9
DT	LANCASTER DAVID	4-CC28-8
DU	ARBOGAST WILLIAM & GRACIE E	4-CC28-7
DV	FRANKLIN CEMETERY ASSOCIATION	3-B28D-67
DW	MCDANIEL RODNEY R & ROSEMARY	3-B235-31
DX	SMITH CAROLYN J TOD	3-B235-32
DY	BROWN IRREVOCABLE TRUST 11/18/17 ALAN & SUSAN	3-B235-24
DZ	BROWN IRREVOCABLE TRUST 11/18/17 ALAN & SUSAN	3-B235-23
EA	REMOVED	REMOVED
EB	LARTER DAVID H	4-CC23-415
EC	VISYAK PATRICIA M	4-CC24-83

ADJOINING OWNERS TABLE		
TRACT	SURFACE OWNER	TAX PARCEL
ED	HUBBARD SAMUEL H & SHELBA	4-CC23-411
EE	HUBBARD SAMUEL H & SHELBA J (JTWS)	4-CC23-410.1
EF	KEMP BRENDA J	4-CC23-347
EG	REMOVED	REMOVED
EH	MERCER RICHARD LEE & MARGARET ANN	4-CC23-349
EI	YOST CLARA E	4-CC23-328
EJ	SILVER CHARLES; HALSTEAD DONNA LIVINGOOD SHERRY (1/3)	4-CC23-327
EK	THOMPSON DEBRA J	4-CC23-319
EL	BANNEN JOHN J	4-CC23-317
EM	HUBBARD SAMUEL	4-CC23-318
EN	BARONIO CURTIS R & DONNA J	4-CC23-321
EO	WEST VIRGINIA ST OF BUREAU OF COMM DIV OF NAT RES PB LC CORP	4-CC23-325
EP	MENEELY BOBBIE JO; MINICH RANDALL	4-CC23-324
EQ	CARBASHO THOMAS & CALDWELL TINA	4-CC23-323
ER	BLACK CLARENCE T JR & TAMMY L	4-CC19-186
ES	SAYTOR CHARLES J JR	4-CC19-187
ET	MARINO WILLIAM & MILDRED T	4-CC19-190
EU	MARINO WILLIAM & MILDRED T	4-CC19-190
EV	ZINK SANDRA DEMARK	4-CC19-145
EW	STATE OF WEST VIRGINIA BUREAU OF COMMERCE DIV OF NAT RESOURC	4-CC19-168
EX	BLAKE LONNIE F	4-CC19-139
EY	CLARK RUSSELL A JR	4-CC19-138
EZ	MACHEN KAREN L	4-CC19-137
FA	DOBBS CYNTHIA & STEVEN	4-CC19-136
FB	DOBBS CYNTHIA & STEVEN	4-CC19-135
FC	VEMURI HOME & GARDEN LLC	4-CC19-133
FD	MACHEN JODIE	4-CC19-132
FE	COEN DARRELL J JR	4-CC19-131
FF	TEMPLE LLOYD	4-CC19-107
FG	RYAN JOSEPH M & BOBBI J (JTWS)	4-CC19-125.1
FH	RYAN JOSEPH M & BOBBI J (JTWS)	4-CC19-124.1
FI	RYAN JOSEPH M & BOBBI J	4-CC19-123
FJ	PARR SARAH ELIZABETH	4-CC19-119
FK	BUCY GERALD L SR & CONSTANCE F	4-CC19-117.1
FL	HOBBS JOYCE ET AL	4-CC19-111
FM	BROOKE COUNTY PARK ASSOCIATION	3-B28-67
FN	BONGIORNI TIMOTHY & PENNY M (SURV)	4-CC23-343
FO	MORGAN RALPH E & BERT M	4-CC23-341
FP	HARTLINE JAMES DAVID & MARIETTA	3-B235-20
FQ	WALDEN WM K & FLORENCE A (TOD) & BURNS LESLIE & WALDEN KENNETH	3-B235-29

01/23/2026

REVISIONS:	COMPANY: 		
	OPERATOR'S GERALD GOURLEY BRK		DATE: 05-08-2025
	WELL #: 9-60346 6H		API NO: 47-009-00346
	DISTRICT: CROSS CREEK	COUNTY: BROOKE	DRAWN BY: Z. WOOD
		STATE: WV	SCALE: N/A
			DRAWING NO: 2024-1300
			WELL LOCATION PLAT