

WW-7
8-30-06



West Virginia Department of Environmental Protection
Office of Oil and Gas

WELL LOCATION FORM: GPS

API: 47-015-02124 WELL NO.: 20951

FARM NAME: James Phillips

RESPONSIBLE PARTY NAME: Triad Hunter, LLC

COUNTY: Clay DISTRICT: Henry

QUADRANGLE: Newton

SURFACE OWNER: Larry Rodgers

ROYALTY OWNER: Blackstone Minerals LLP

UTM GPS NORTHING: ~~4264314~~ 426 4296.1 (corrected)

UTM GPS EASTING: ~~485655~~ 485617.7 GPS ELEVATION: 1025

The Responsible Party named above has chosen to submit GPS coordinates in lieu of preparing a new well location plat for a plugging permit or assigned API number on the above well. The Office of Oil and Gas will not accept GPS coordinates that do not meet the following requirements:

1. Datum: NAD 1983, Zone: 17 North, Coordinate Units: meters, Altitude: height above mean sea level (MSL) – meters.
2. Accuracy to Datum – 3.05 meters
3. Data Collection Method:

Survey grade GPS : Post Processed Differential

Real-Time Differential

Mapping Grade GPS : Post Processed Differential

Real-Time Differential

4. Letter size copy of the topography map showing the well location.


I the undersigned, hereby certify this data is correct to the best of my knowledge and belief and shows all the information required by law and the regulations issued and prescribed by the Office of Oil and Gas.

Bon Smith
Signature

Geologist
Title

RECEIVED
Office of Oil and Gas
3/17/15
MAR 26 2015
Date

WV Department of
Environmental Protection

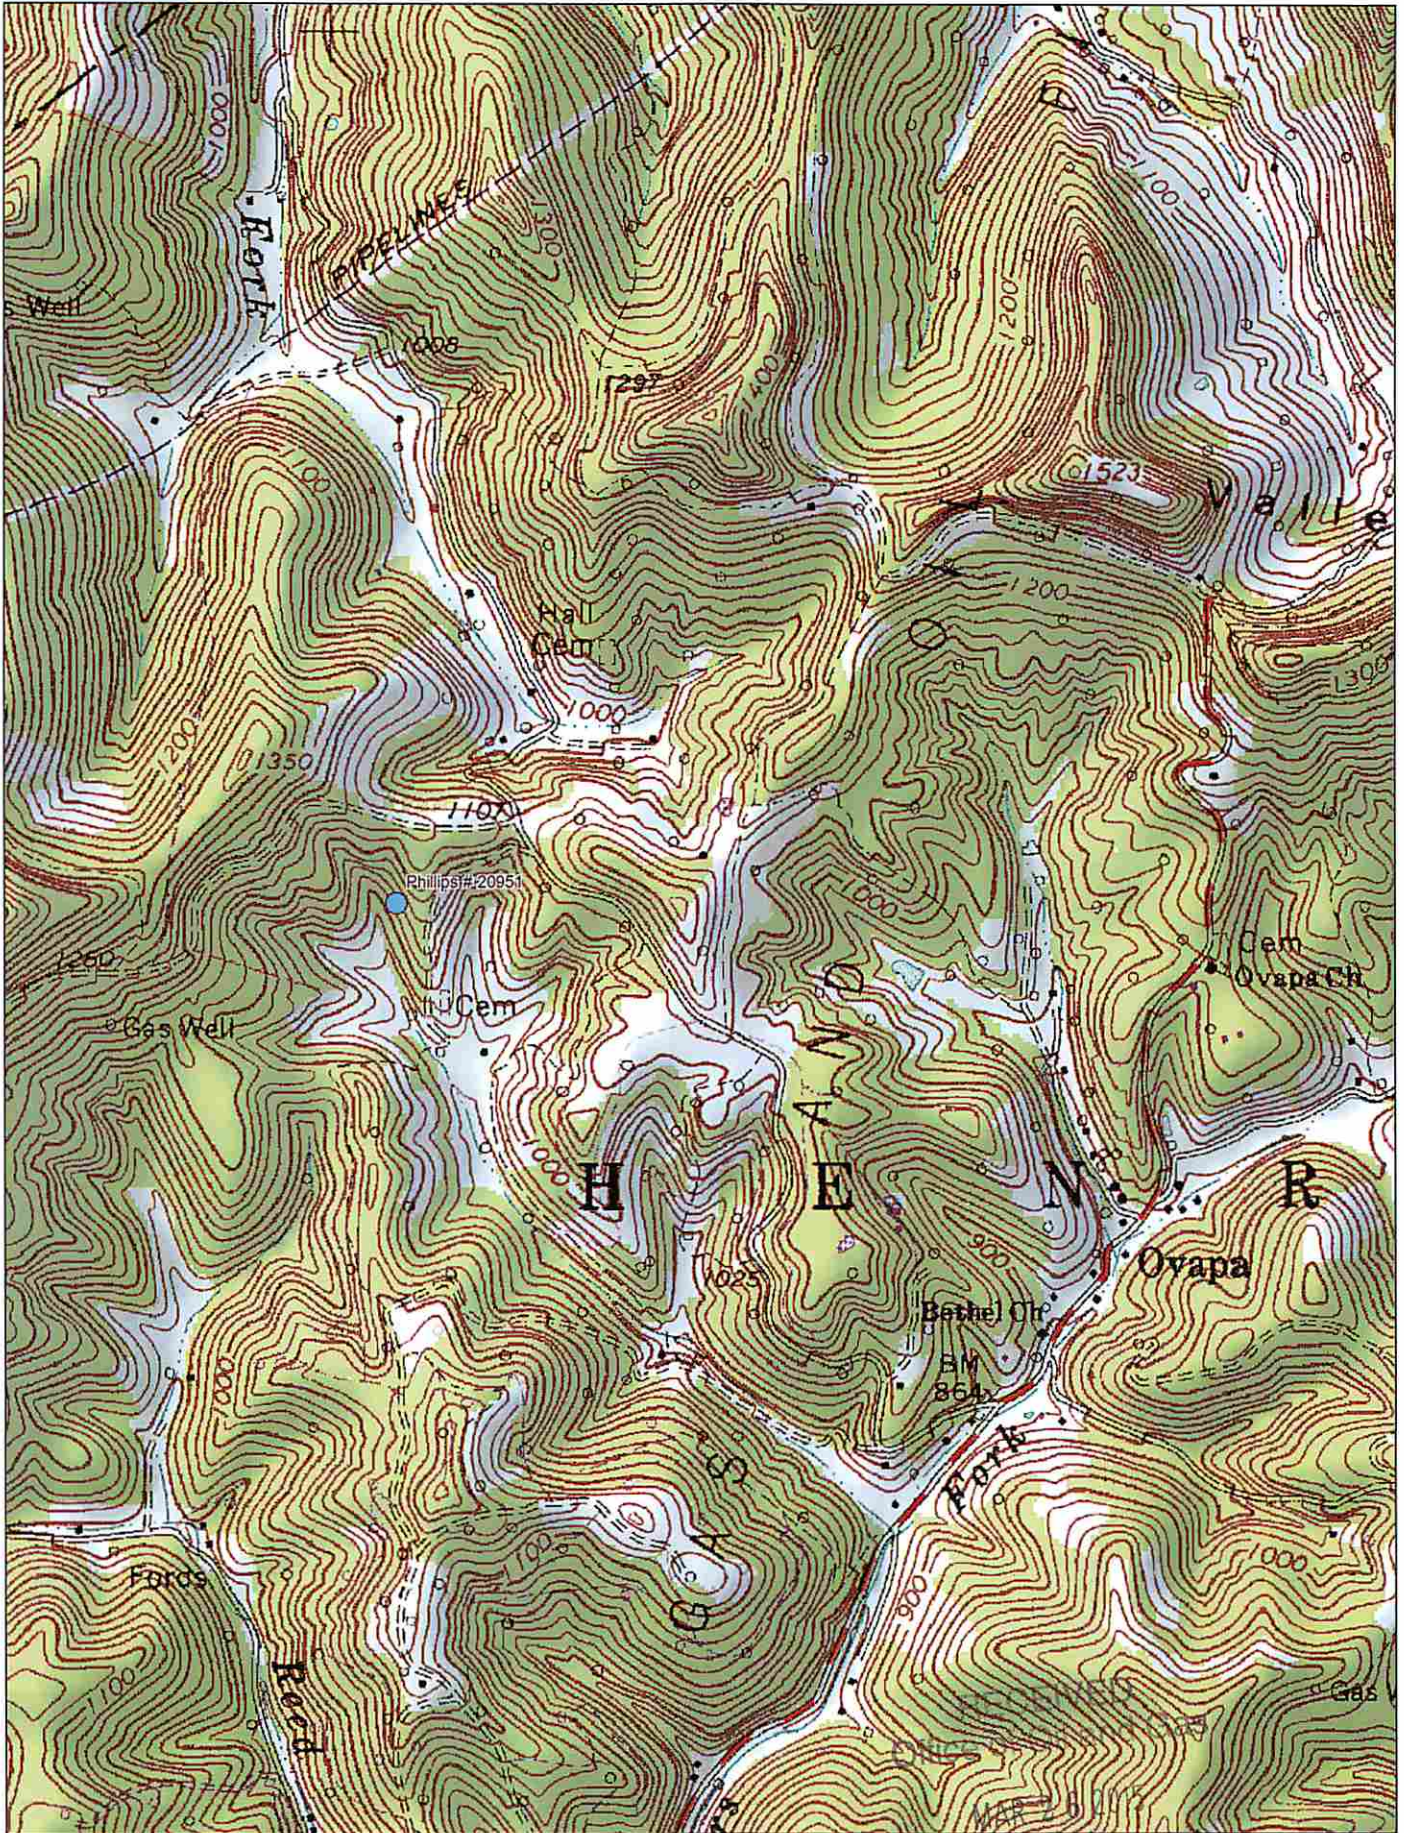

Data use subject to license.

© DeLorme. XMap® 7.

www.delorme.com



Scale 1 : 14,400

WV Department of Environmental Protection

0 200 400 600 800 1000 1200 1400 1600 1800 2000 m

Data Zoom 13-7