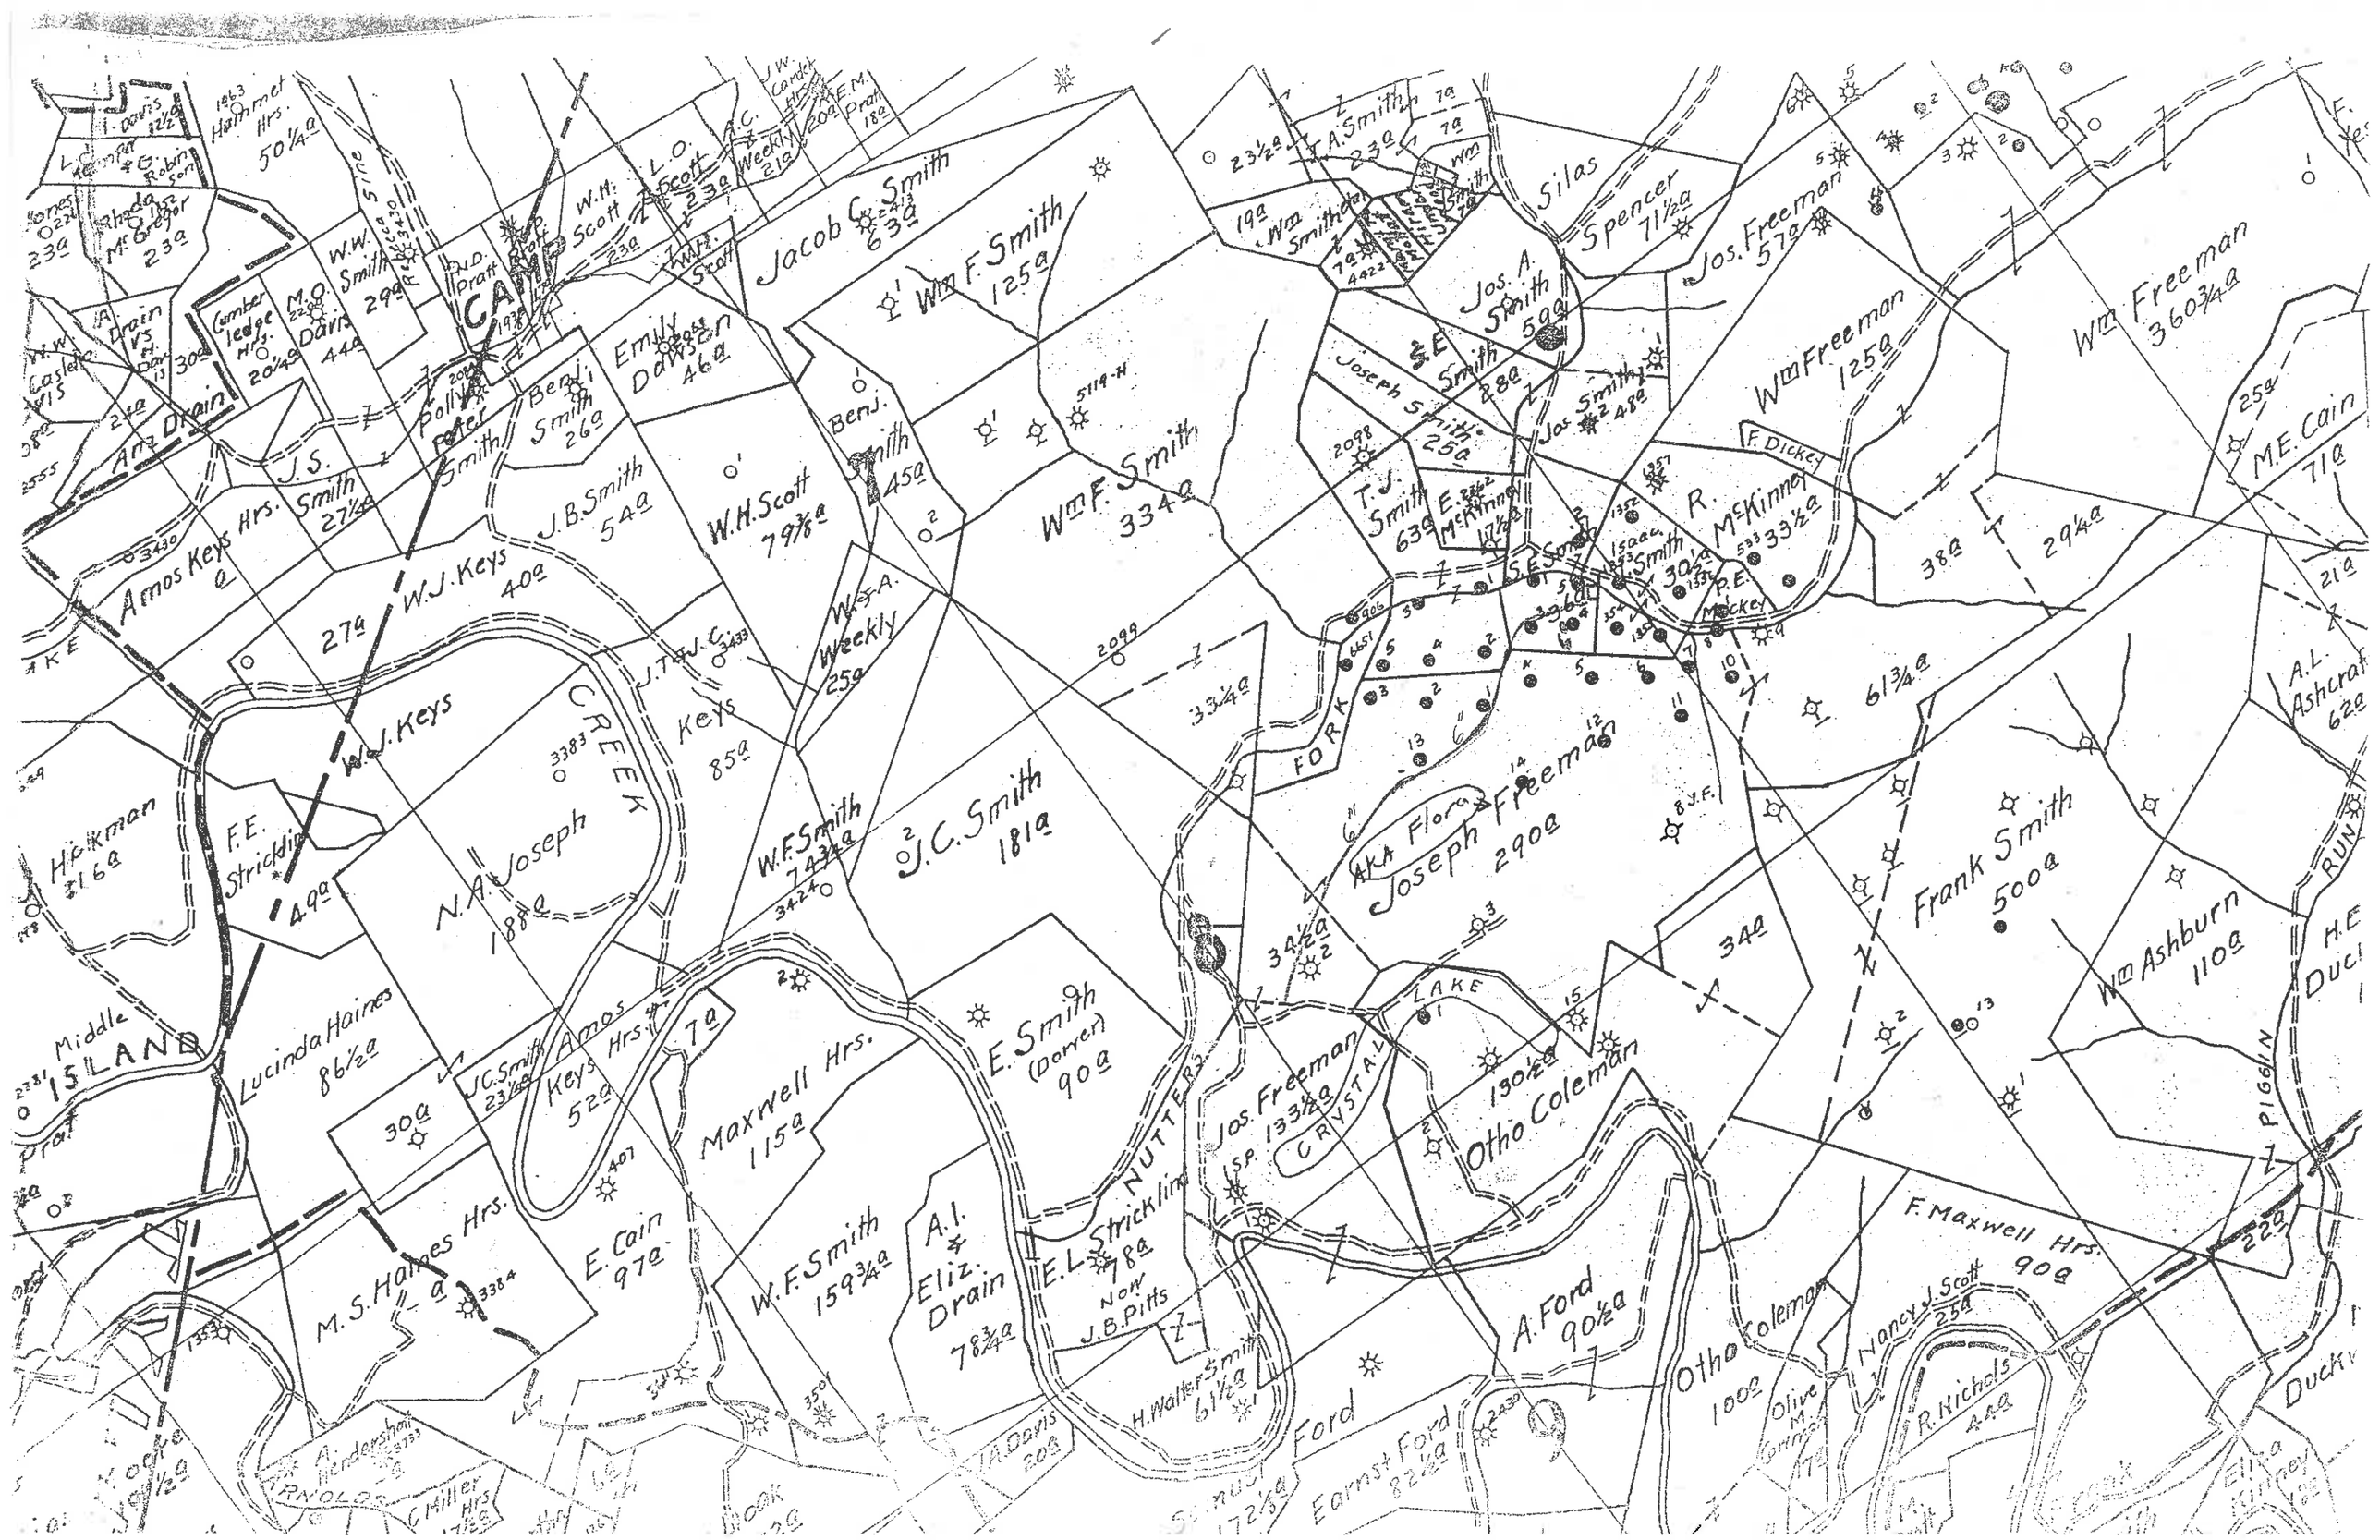
CAMP
CREEK
FORK
LAKE
CRYSTAL
NUTTER
RUN
PIGEON
Middle ISLAND
Jacob C. Smith 63a
Wm F. Smith 125a
Wm F. Smith 334a
W.H. Scott 79⅞a
Benj. Smith 45a
Benj. Smith 26a
Emily Dawson 46a
J.B. Smith 54a
Amos Keys Hrs. 27a
W.J. Keys 40a
W.W. Keys
J.S. Smith 27¼a
Art Drain
Peter Smith
Polly Smith
Wm. A. Weekly 25a
J.C. Smith 181a
W.F. Smith 74¾a
Keys 85a
N.A. Joseph 188a
F.E. Strickling 49a
Hickman 21.6a
Lucinda Haines 86½a
M.S. Haines Hrs. 30a
E. Cain 97a
Amos Keys Hrs. 52a
Maxwell Hrs. 115a
W.F. Smith 159¾a
A.I. Eliz. Drain 78¾a
E. Smith (Dorcas) 90a
E.L. Strickling 78a Now J.B. Pitts
H. Walker Smith 61½a
Jos. Freeman 133½a
Otho Coleman 130½a
A. Ford 90½a
Earnest Ford 82½a
Otho Coleman 100a
Olive M. Jones 77a
Nancy J. Scott 25a
R. Nichols 44a
F. Maxwell Hrs. 90a
Frank Smith 500a
Wm Ashburn 110a
Wm Freeman 360¾a
Wm Freeman 125a
Jos. Freeman 57a
Silas Spencer 71½a
Jos. A. Smith 59a
Joseph Smith 25a
Jos. Smith 48a
T.J. Smith 63a
R. McKinney 33½a
M.E. Cain 71a
A.L. Ashcraft 62a
Flora Joseph Freeman 290a
61¾a
38a
29¼a
34a
34½a
33¼a
L.O. Scott 23a
W.W. Smith 29a
W.H. Scott 23a
A.C. Weekly 21a
E.M. Pratt 18a
J.W. Smith 20a
A. Smith 23a
Wm Smith 19a
Rhoda McGregor 23a
Robinson 50¼a
Cumberland Ledge
Drain
Davis 44a
M.O. Davis 22a
Pollard 20a
Pratt 15a
Wm Smith 5a
Wm Smith 7a
Wm Smith 7a
