

Latitude

39° 25' 00"



80° 42' 30"

Longitude

°

29, 174

Topo Location

7.5' Loc. 2.385 15' Loc. 2.385  
1.05W (calc.) 2.28W

Farm Freeman Underwood #1  
15' Quad Center Point (wc)  
(sec.) Center Point  
7.5' Quad Center Point  
District Mc Collan

WELL LOCATION PLAT


County 017 Permit 4115N

12,000

39° 25' 00"

12,700 80° 40' 00"

18564

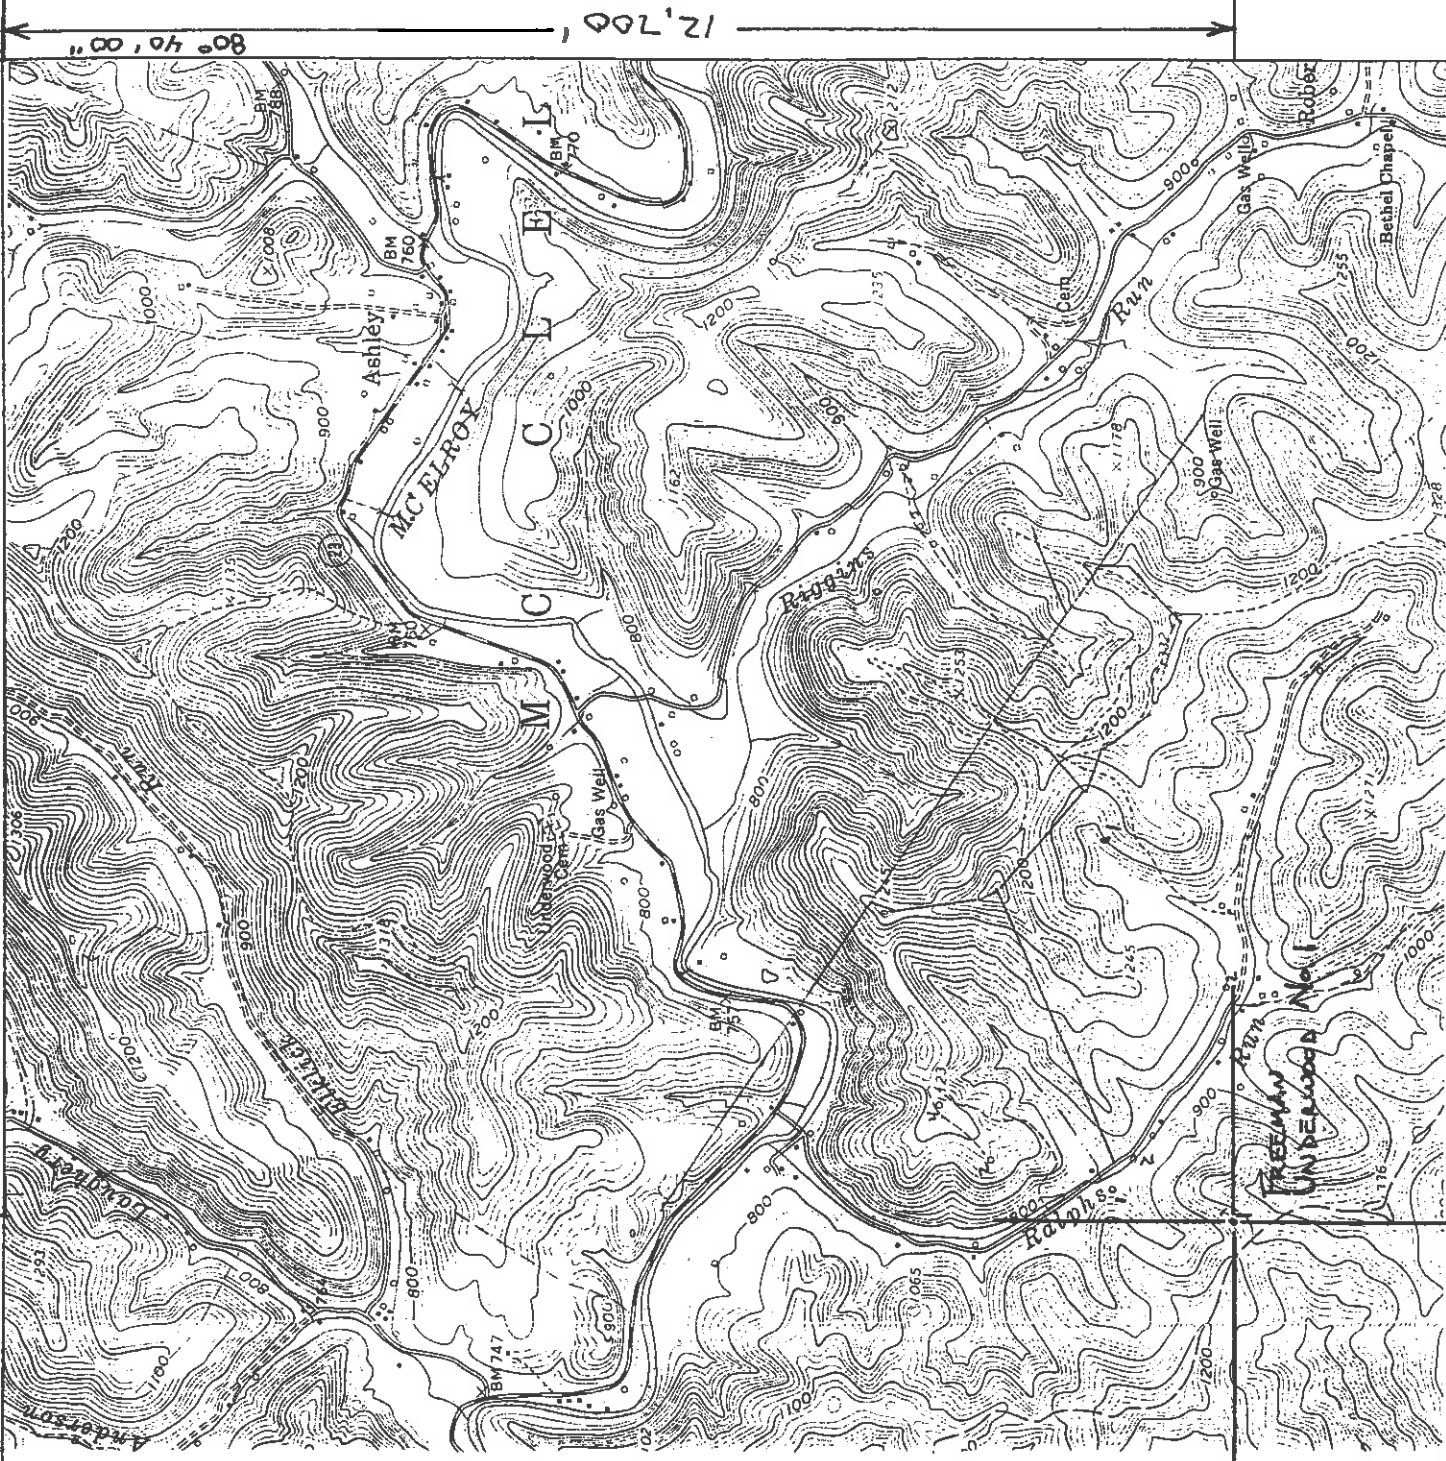

I, the undersigned, hereby certify that this plat is correct to the best of my knowledge and belief.

SIGNED Freeman Underwood

DATE DECEMBER 14, 19 93  
 OPERATORS WELL NO. F. UNDERWOOD #1  
 API WELL NO. 47-017-415-N

TITLE Supervisor, Surveying/Mapping

STATE OF WEST VIRGINIA  
 DEPARTMENT OF ENERGY  
 OIL AND GAS DIVISION

WELL TYPE: OIL  GAS  LIQUID INJECTION  WASTE DISPOSAL   
 (If "GAS" PRODUCTION  STORAGE  DEEP  SHALLOW

LOCATION: ELEVATION \_\_\_\_\_ WATER SHED RALPHS RUN  
 DISTRICT MCCLELLAN COUNTY DODD  
 QUADRANGLE CENTERPOINT

SURFACE OWNER \_\_\_\_\_ ACREAGE \_\_\_\_\_

OIL & GAS ROYALTY OWNER \_\_\_\_\_ LEASE ACRES \_\_\_\_\_  
 LEASE NO. \_\_\_\_\_

PRODUCING FORMATION \_\_\_\_\_ TOTAL DEPTH \_\_\_\_\_

WELL OPERATOR Pennzoil Products Company DESIGNATED AGENT James A. Crews

ADDRESS P.O. Box 5519 ADDRESS P.O. Box 5519  
Vienna, WV 26105 Vienna, WV 26105

Form 6 - 1991



STATE OF WEST VIRGINIA  
DIVISION OF ENVIRONMENTAL PROTECTION  
SECTION OF OIL AND GAS

WELL REGISTER ASSIGNMENT

This API Number 47- 17-04115, issued to PENNZOIL PRODUCTS COMPANY is evidence of permission to operate the well that is referenced at the location described on the attached plat, subject to the provisions of Chapters 22 and 22B of the West Virginia Code of 1931, as amended, and all rules and regulations promulgated thereunder. The name and telephone number of the Oil and Gas Inspector for this well is MIKE UNDERWOOD -  
304-782-1043.

Spills or emergency discharges must be reported to 1-800-654-3312.

Failure to abide by all statutory and regulatory provisions governing all duties and operations hereunder may result in suspension or revocation of your permits and in addition may result in civil and/or criminal penalties.

The enclosed WR-35 must be completed by you and returned to this office. In addition annual production reports must be submitted on this well and failure to do so may require you to plug the well.

Theodore M. Streit  
Chief



By: \_\_\_\_\_

Title: \_\_\_\_\_

Operator's Well No: F. UNDERWOOD #1

Farm Name: UNDERWOOD, FREEMAN

API Well Number : 47- 17-04115 N

Date Issued : 03/17/94

