



west virginia department of environmental protection

Office of Oil and Gas
601 57th Street SE
Charleston, WV 25304
(304) 926-0450
(304) 926-0452 fax

Earl Ray Tomblin, Governor
Randy C. Huffman, Cabinet Secretary
www.dep.wv.gov

PERMIT MODIFICATION APPROVAL

August 06, 2013

EQT PRODUCTION COMPANY
POST OFFICE BOX 280
BRIDGEPORT, WV 26330


Re: Permit Modification Approval for API Number 1706186 , Well #: 514654
changed target formation

Oil and Gas Operator:

The Office of Oil and Gas has reviewed the attached permit modification for the above referenced permit. The attached modification has been approved and well work may begin. Please be reminded that the oil and gas inspector is to be notified twenty-four (24) hours before permitted well work is commenced.

Please call James Martin at 304-926-0499, extension 1654 if you have any questions.

Sincerely,

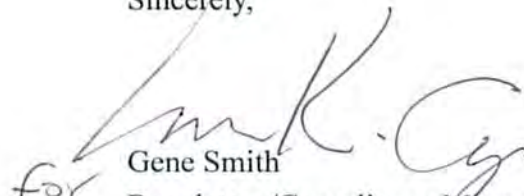for 
Gene Smith
Regulatory/Compliance Manager
Office of Oil and Gas

4701706186

CASING AND TUBING PROGRAM

20)

<u>TYPE</u>	<u>Size</u>	<u>New or Used</u>	<u>Grade</u>	<u>Weight per ft.</u>	<u>FOOTAGE: for Drilling</u>	<u>INTERVALS: Left in Well</u>	<u>CEMENT: Fill- up (Cu.Ft.)</u>
Conductor	20	New	MC-50	81#	72	72	69
Fresh Water	13 3/8	New	MC-50	54#	670'	670'	593
Coal	—	New	—	—	—	—	—
Intermediate	9 5/8	New	MC-50	40#	5327'	5327'	2,104
Production	5 1/2	New	P-110	20#	12,682	12,682	See Note 1
Tubing	2 3/8	—	J-55	4.6	—	—	May not be run, if run will be set 100' less than TD
Liners							

<u>TYPE</u>	<u>Size</u>	<u>Wellbore Diameter</u>	<u>Wall Thickness</u>	<u>Burst Pressure</u>	<u>Cement Type</u>	<u>Cement Yield</u>
Conductor	20	24	0.635	—	Class A	1.18
Fresh Water	13 3/8	17 1/2	0.38	2,480	1	1.21
Coal	—	—	—	—	—	—
Intermediate	9 5/8	12 3/8	0.395	3,590	1	1.21
Production	5 1/2	8 1/2	0.361	12,640	—	1.27/1.86
Tubing						
Liners						

Packers

*DCW
5-31-2013*

Kind:	N/A		
Sizes:	N/A		
Depths Set:	N/A		

Note 1: EQT plans to bring the TOC on the production casing cement job 1,000' above kick off point so that the intermediate casing shoe can be monitored during stimulation and the well can be safely plugged and abandoned in the future.

Received 08/09/2013

JUN 5 2013

21) Describe centralizer placement for each casing string.

• Surface: Bow spring centralizers – One at the shoe and one spaced every 500'.

• Intermediate: Bow spring centralizers– One cent at the shoe and one spaced every 500'.

• Production: One spaced every 1000' from KOP to Int csg shoe

22) Describe all cement additives associated with each cement type.

Surface (Type 1 Cement): 0-3% Calcium Chloride

Used to speed the setting of cement slurries.

0.4% flake. Loss Circulation Material (LCM) is used to combat the loss of the cement slurry to a thief zone.

Intermediate (Type 1 Cement): 0-3% Calcium Chloride. Salt is used in shallow, low temperature formations to speed the setting of cement

slurries. 0.4% flake. Loss Circulation Material (LCM) is used to combat the loss of whole drilling fluid or cement slurry (not filtrate)

to a thief zone.

Production:

Lead (Type 1 Cement): 0.2-0.7% Lignosulfonate (Retarder). Lengthens thickening time.

0.3% CFR (dispersant). Makes cement easier to mix.

Tail (Type H Cement): 0.25-0.40% Lignosulfonate (Retarder). Lengthens thickening time.

0.2-0.3% CFR (dispersant). This is to make the cement easier to mix.

60 % Calcium Carbonate. Acid solubility.

0.4-0.6% Halad (fluid loss). Reduces amount of water lost to formation.

23) Proposed borehole conditioning procedures. Surface: Circulate hole clean (Approximately 30-45 minutes) rotating & reciprocating

one full joint until cuttings diminish at surface. When cuttings returning to surface diminish, continue to circulate an additional 5

minutes. To ensure that there is no fill, short trip two stands with no circulation. If there is fill, bring compressors back on

and circulate hole clean. A constant rate of higher than expected cuttings volume likely indicates washouts that will not clean up.

Intermediate: Circulate hole clean (Approximately 30-45 minutes) rotating & reciprocating one full joint until cuttings diminish at

surface. When cuttings returning to surface diminish, continue to circulate an additional 5 minutes. If foam drilling, to enhance

hole cleaning use a soap sweep or increase injection rate & foam concentration.

Production: Pump marker sweep with nut plug to determine actual hole washout. Calculate a gauge holes bottoms up volume.

Perform a cleanup cycle by pumping 3-5 bottoms up or until the shakers are clean. Check volume of cuttings coming across

the shakers every 15 minutes.

*Note: Attach additional sheets as needed.

Received


08/09/2013

MAY 13 2013

4701706186 Mod

Well 514654 (SMI28H14)
 EQT Production
 Smithburg
 Doddridge West Virginia

Azimuth 195
 Vertical Section 8278

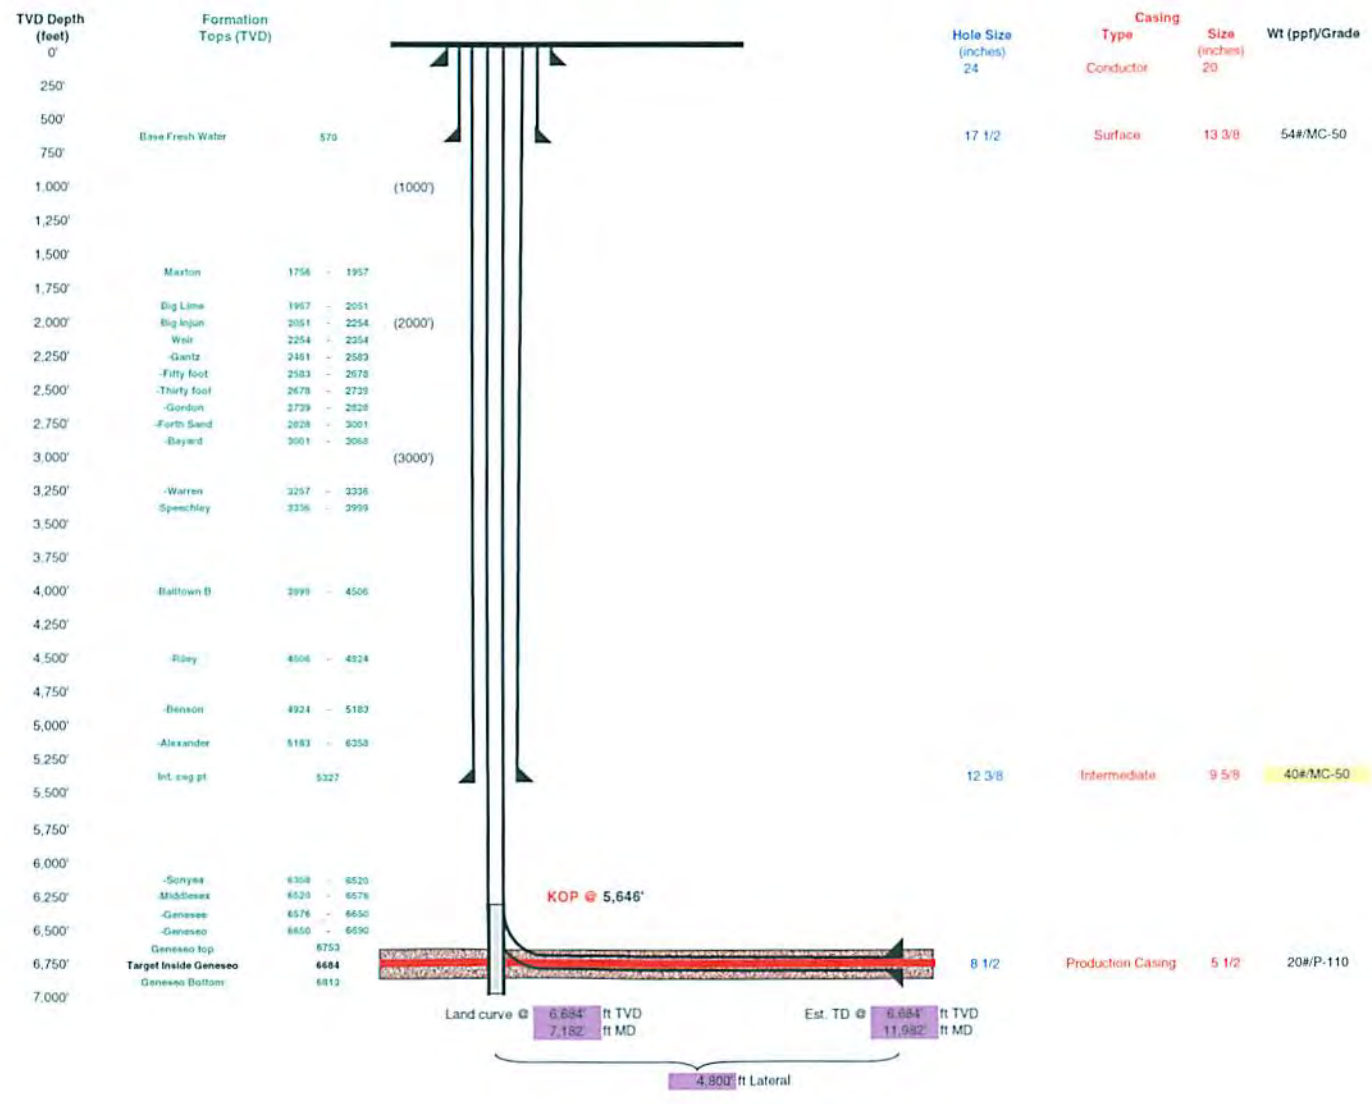

Received


MAY 13 2013

Office of Oil and Gas
 WV Dept. of Environmental Protection

Well Schematic
EQT Production

Well Name: 514654 (SMI26H14)
County: Doddridge
State: West Virginia

Elevation KB: 1264
Target: Genesee
Prospect: 155
Azimuth: 5270
Vertical Section

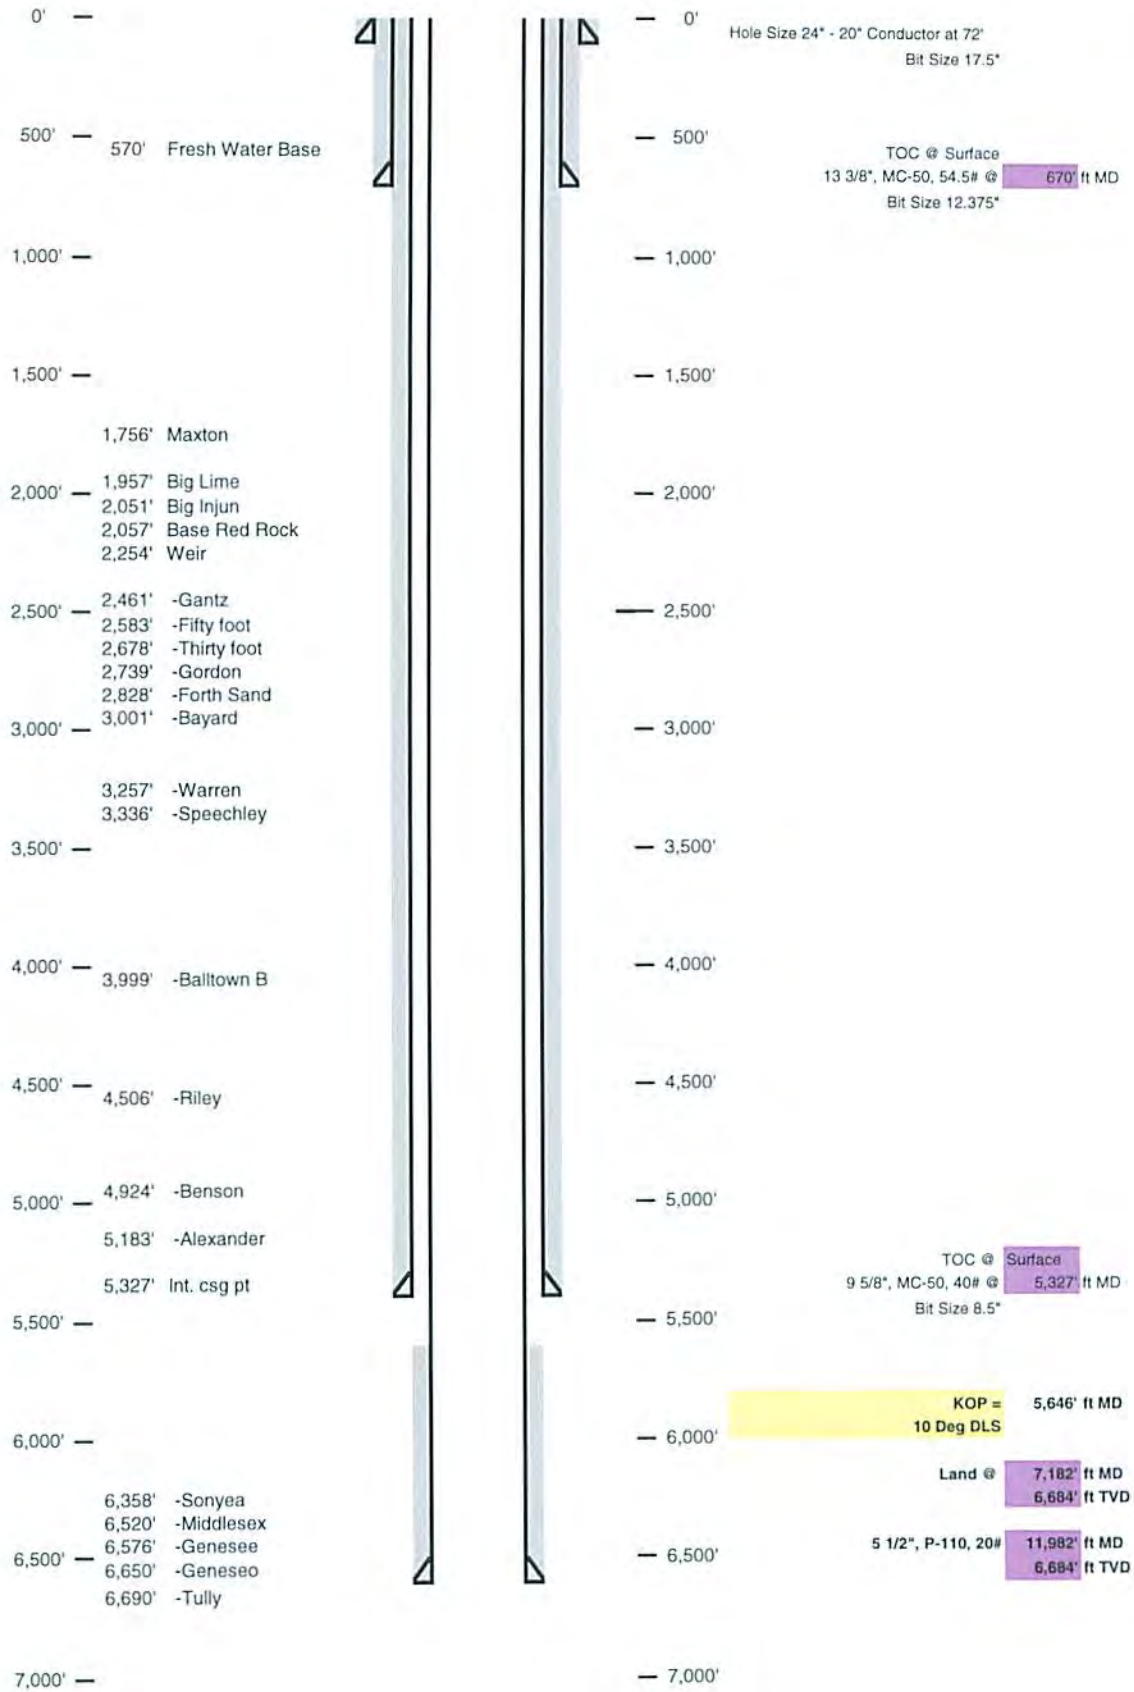

Received

08/09/2013

MAY 13 2013

Office of Oil and Gas
WV Dept. of Environmental Protection

