



West Virginia Department of Environmental Protection
Office of Oil and Gas
WELL LOCATION FORM: GPS

API: ? WELL NO.: ONE

FARM NAME: J.H. STICKEL

RESPONSIBLE PARTY NAME: FRANCIS PAT DANIELS - 304 873 1349

COUNTY: DODDRIDGE DISTRICT: NEW MILTON

QUADRANGLE: 35 - NEW MILTON

SURFACE OWNER: WILBUR DAN STICKEL 304 842 2903

ROYALTY OWNER: SEE ATTACHED SHEET FROM TAX FORM

UTM GPS NORTHING: 39° 21173

UTM GPS EASTING: 80.63587 GPS ELEVATION: 907'

The Responsible Party named above has chosen to submit GPS coordinates in lieu of preparing a new well location plat for a plugging permit or assigned API number on the above well. The Office of Oil and Gas will not accept GPS coordinates that do not meet the following requirements:

1. Datum: NAD 1983, Zone: 17 North, Coordinate Units: meters, Altitude: height above mean sea level (MSL) – meters.
2. Accuracy to Datum – 3.05 meters
3. Data Collection Method:

Survey grade GPS : Post Processed Differential

Real-Time Differential

Mapping Grade GPS : Post Processed Differential

Real-Time Differential

4. Letter size copy of the topography map showing the well location.

I the undersigned, hereby certify this data is correct to the best of my knowledge and belief and shows all the information required by law and the regulations issued and prescribed by the Office of Oil and Gas.

Francis Patrick Daniels
Signature

AGENT
Title


UNCLE JOHN'S OIL CO
1069 SNAKE RUN
NEW MILTON WV 26041
2/22/13
Date

RECEIVED
Office of Oil and Gas

FEB 27 2013

West Virginia Department of
Environmental Protection

STICKER WELL-LOCATED 1.5 MILES UP SNAKE RUN ROAD OFF MEAT HOUSE FORK RD. (ON LEFT GOING UP)

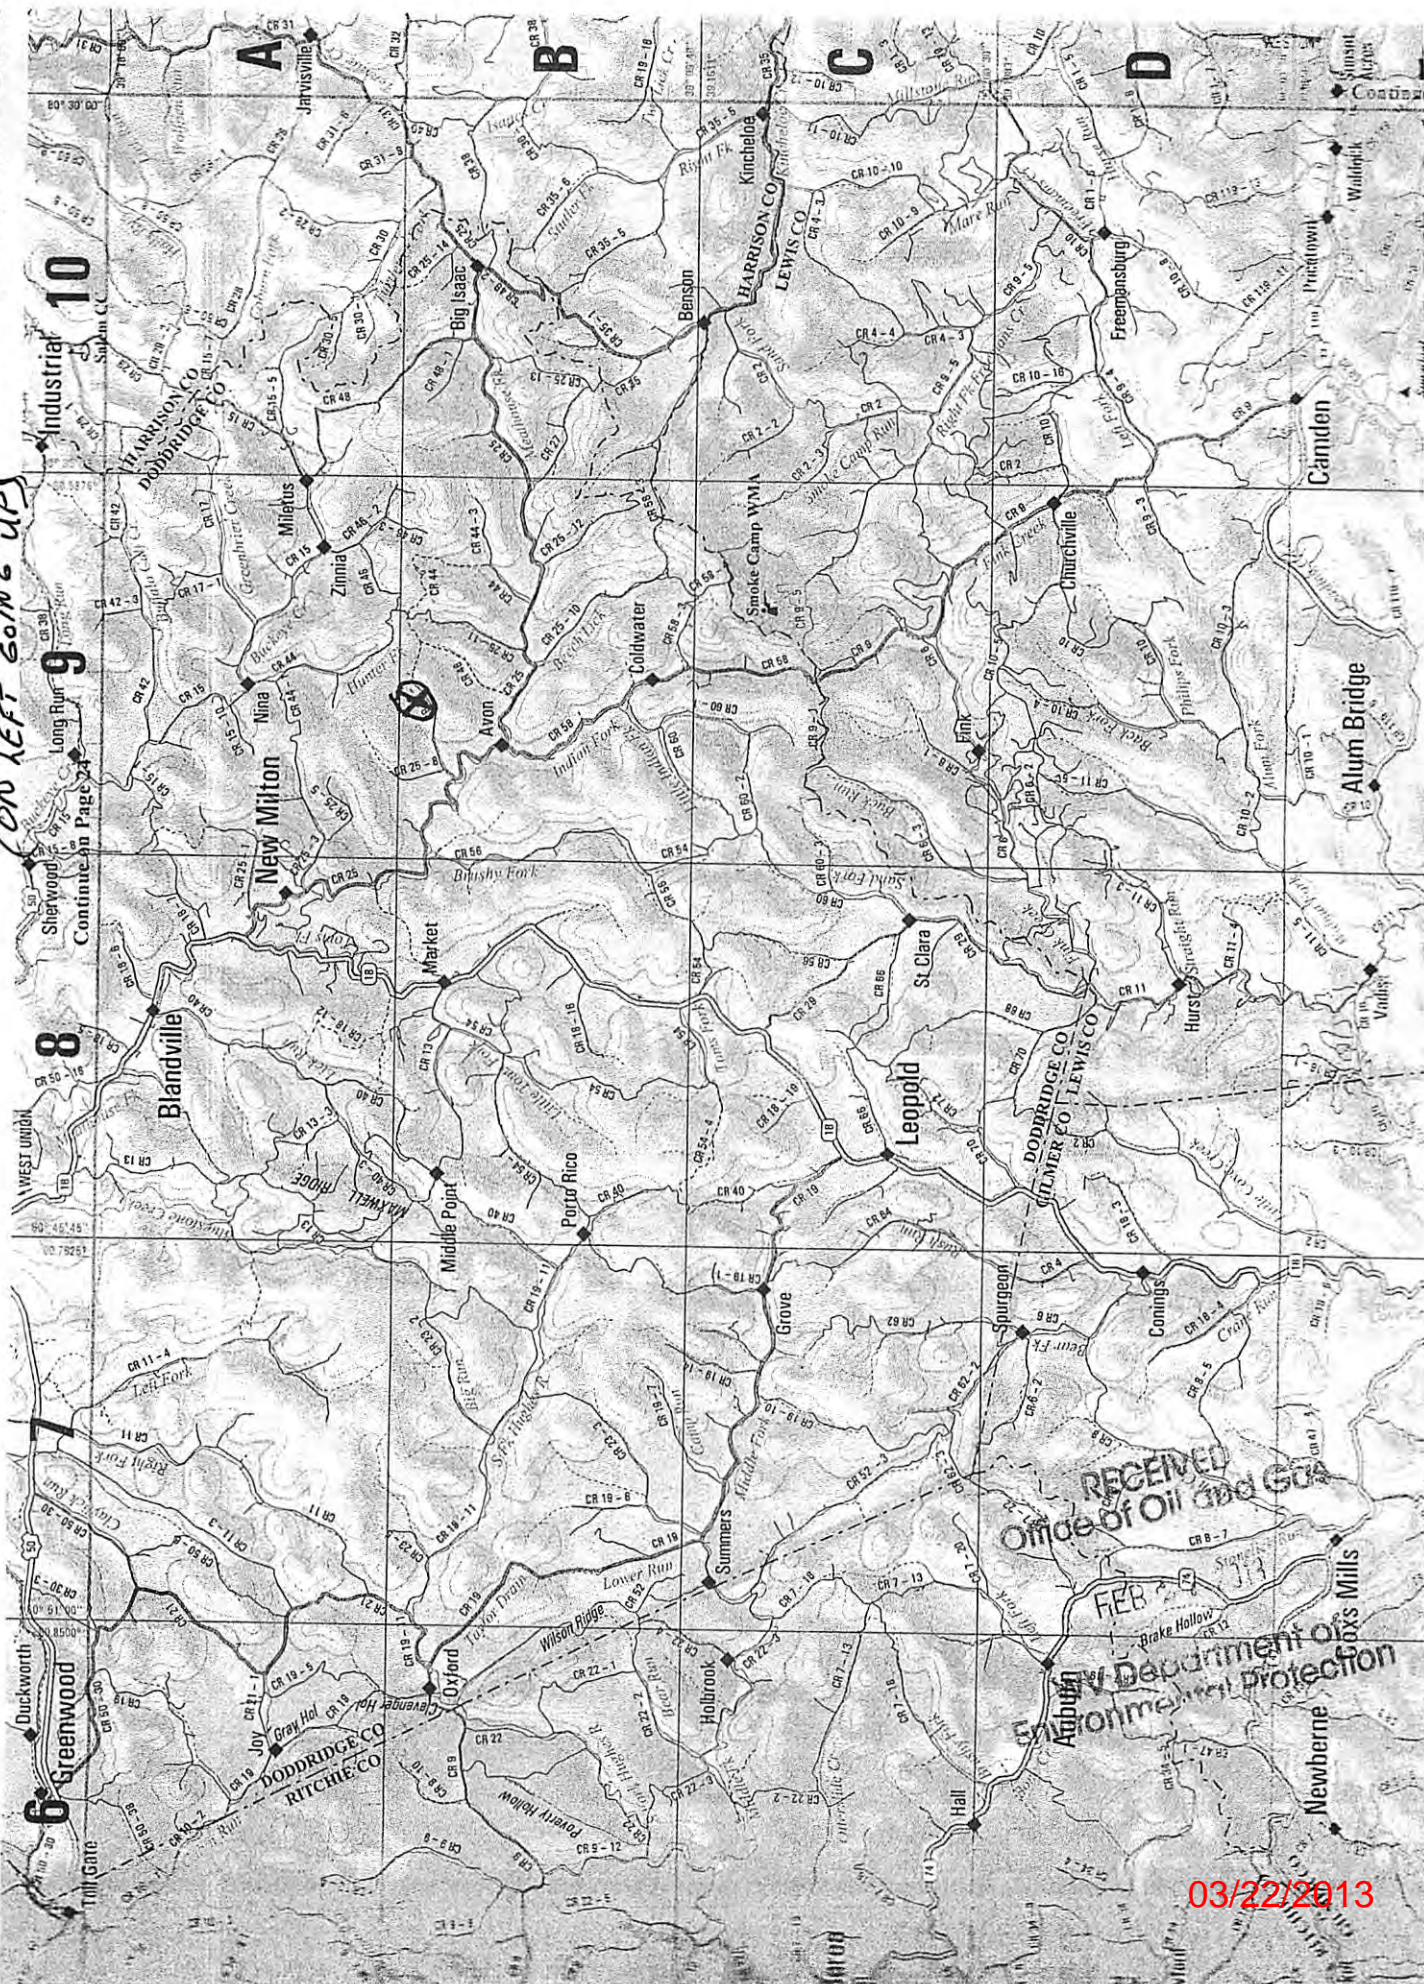

03/22/2013