


470 1706253

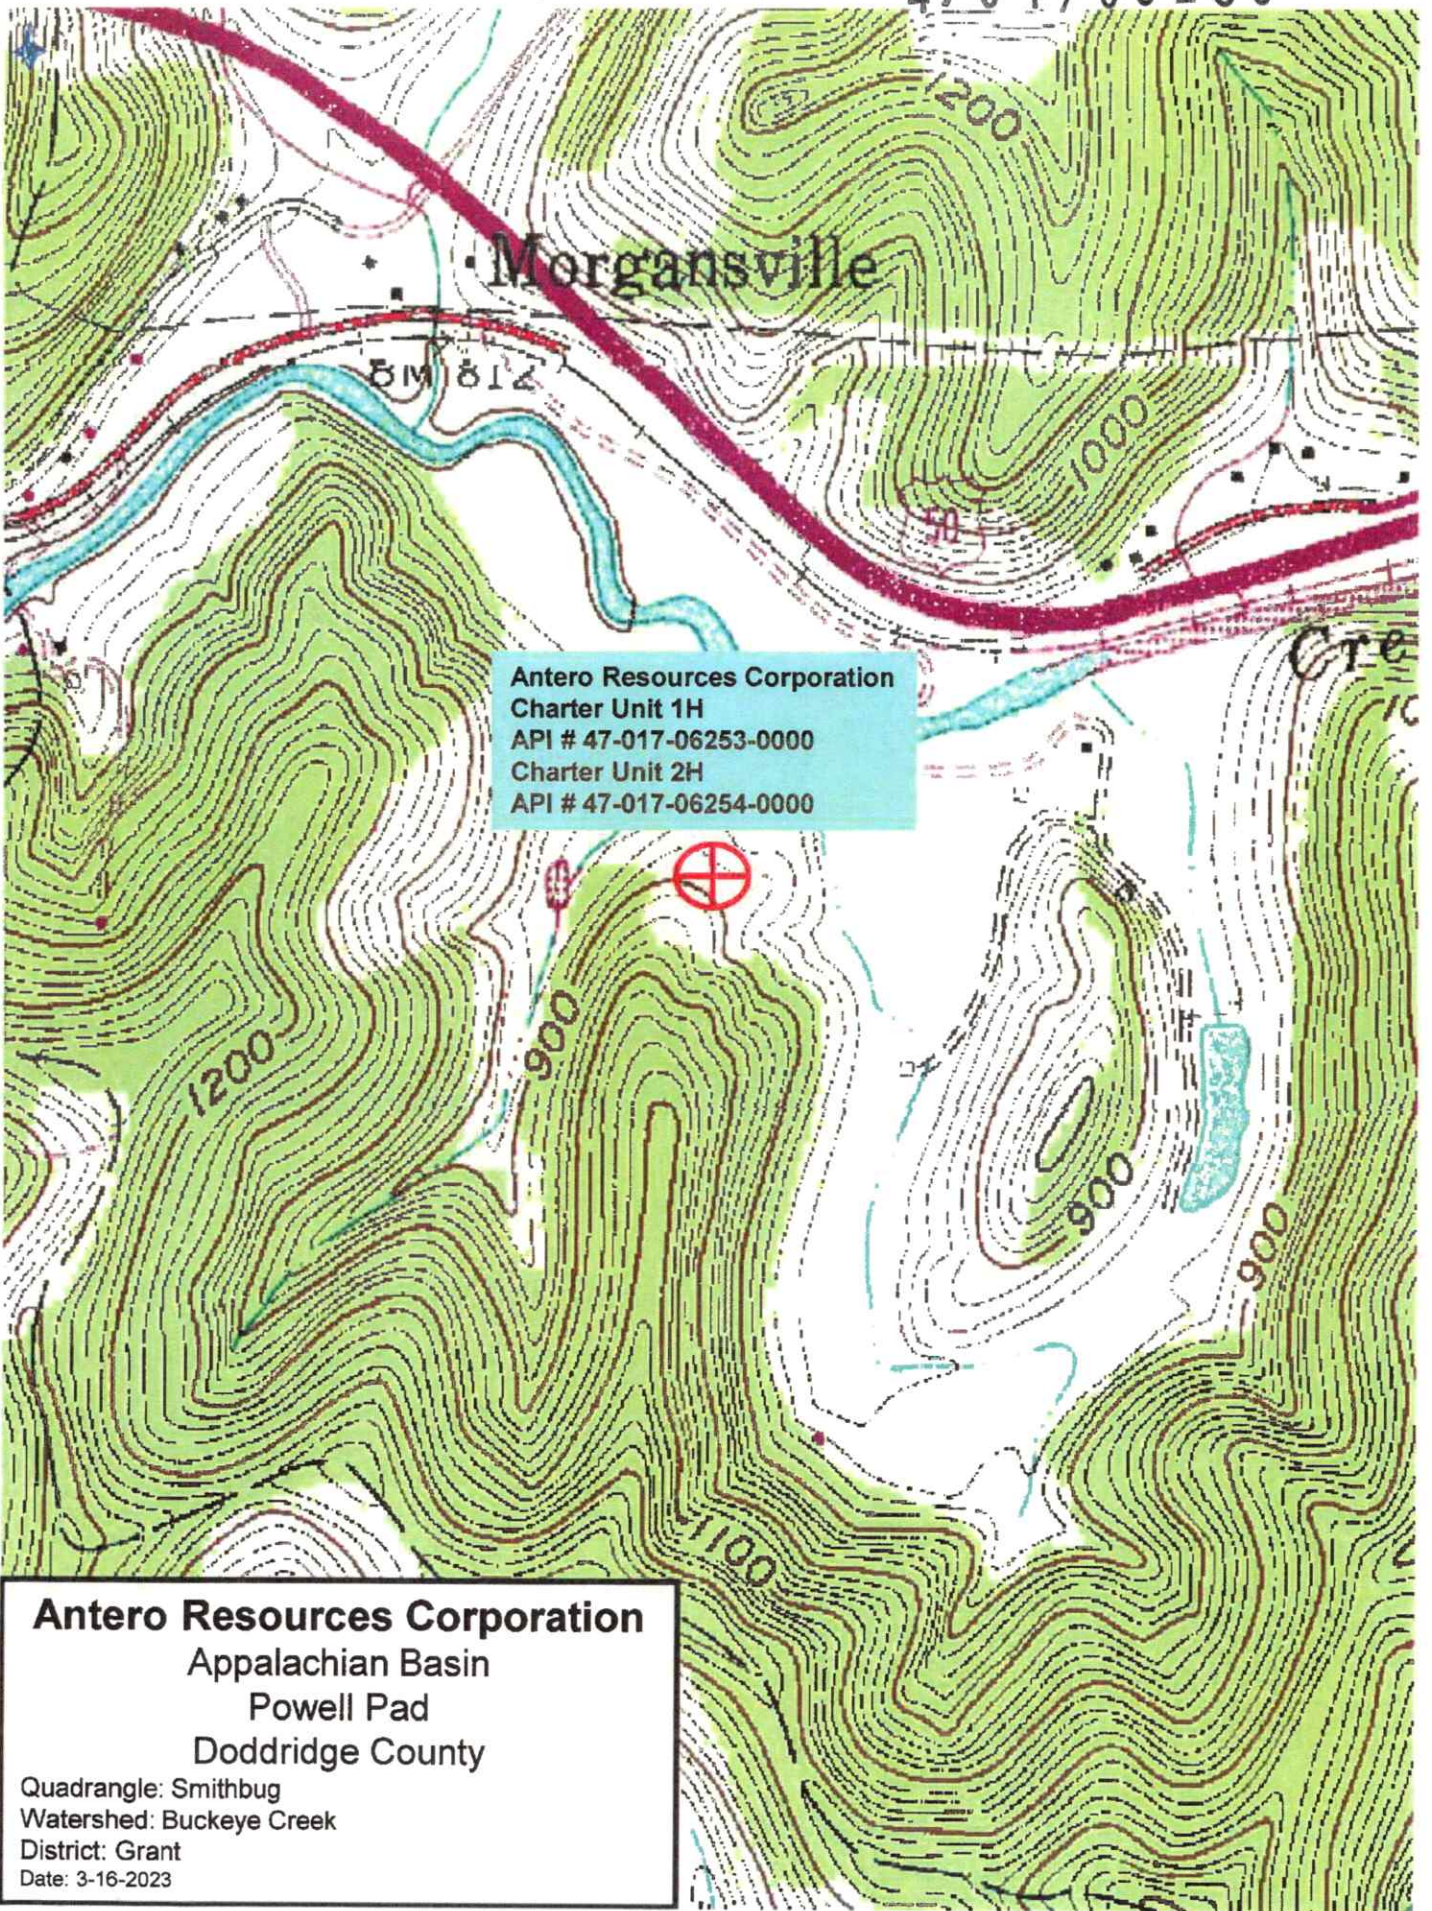

Antero Resources Corporation  
Charter Unit 1H  
API # 47-017-06253-0000  
Charter Unit 2H  
API # 47-017-06254-0000

**Antero Resources Corporation**  
Appalachian Basin  
Powell Pad  
Doddridge County  
Quadrangle: Smithbug  
Watershed: Buckeye Creek  
District: Grant  
Date: 3-16-2023

04/21/2023

4701706253

WW-7  
8-30-06



West Virginia Department of Environmental Protection  
Office of Oil and Gas  
**WELL LOCATION FORM: GPS**

API: 47-017-06253 WELL NO.: Charter 1H

FARM NAME: Powell

RESPONSIBLE PARTY NAME: Antero Resources Corporation

COUNTY: Doddridge DISTRICT: Grant

QUADRANGLE: Smithburg

SURFACE OWNER: D&M Powell LLC

ROYALTY OWNER: \_\_\_\_\_

UTM GPS NORTHING: 4347471.54 m

UTM GPS EASTING: 526660.47 m GPS ELEVATION: 878.5 ft

The Responsible Party named above has chosen to submit GPS coordinates in lieu of preparing a new well location plat for a plugging permit or assigned API number on the above well. The Office of Oil and Gas will not accept GPS coordinates that do not meet the following requirements:

1. Datum: NAD 1983, Zone: 17 North, Coordinate Units: meters, Altitude: height above mean sea level (MSL) – meters.
2. Accuracy to Datum – 3.05 meters
3. Data Collection Method:

Survey grade GPS  : Post Processed Differential \_\_\_\_\_  
Real-Time Differential

Mapping Grade GPS  : Post Processed Differential \_\_\_\_\_  
Real-Time Differential

4. Letter size copy of the topography map showing the well location.

I the undersigned, hereby certify this data is correct to the best of my knowledge and belief and shows all the information required by law and the regulations issued and prescribed by the Office of Oil and Gas.

Maha TWW  
Signature

Permittals manager  
Title

4/5/23  
Date