FORM WW 6

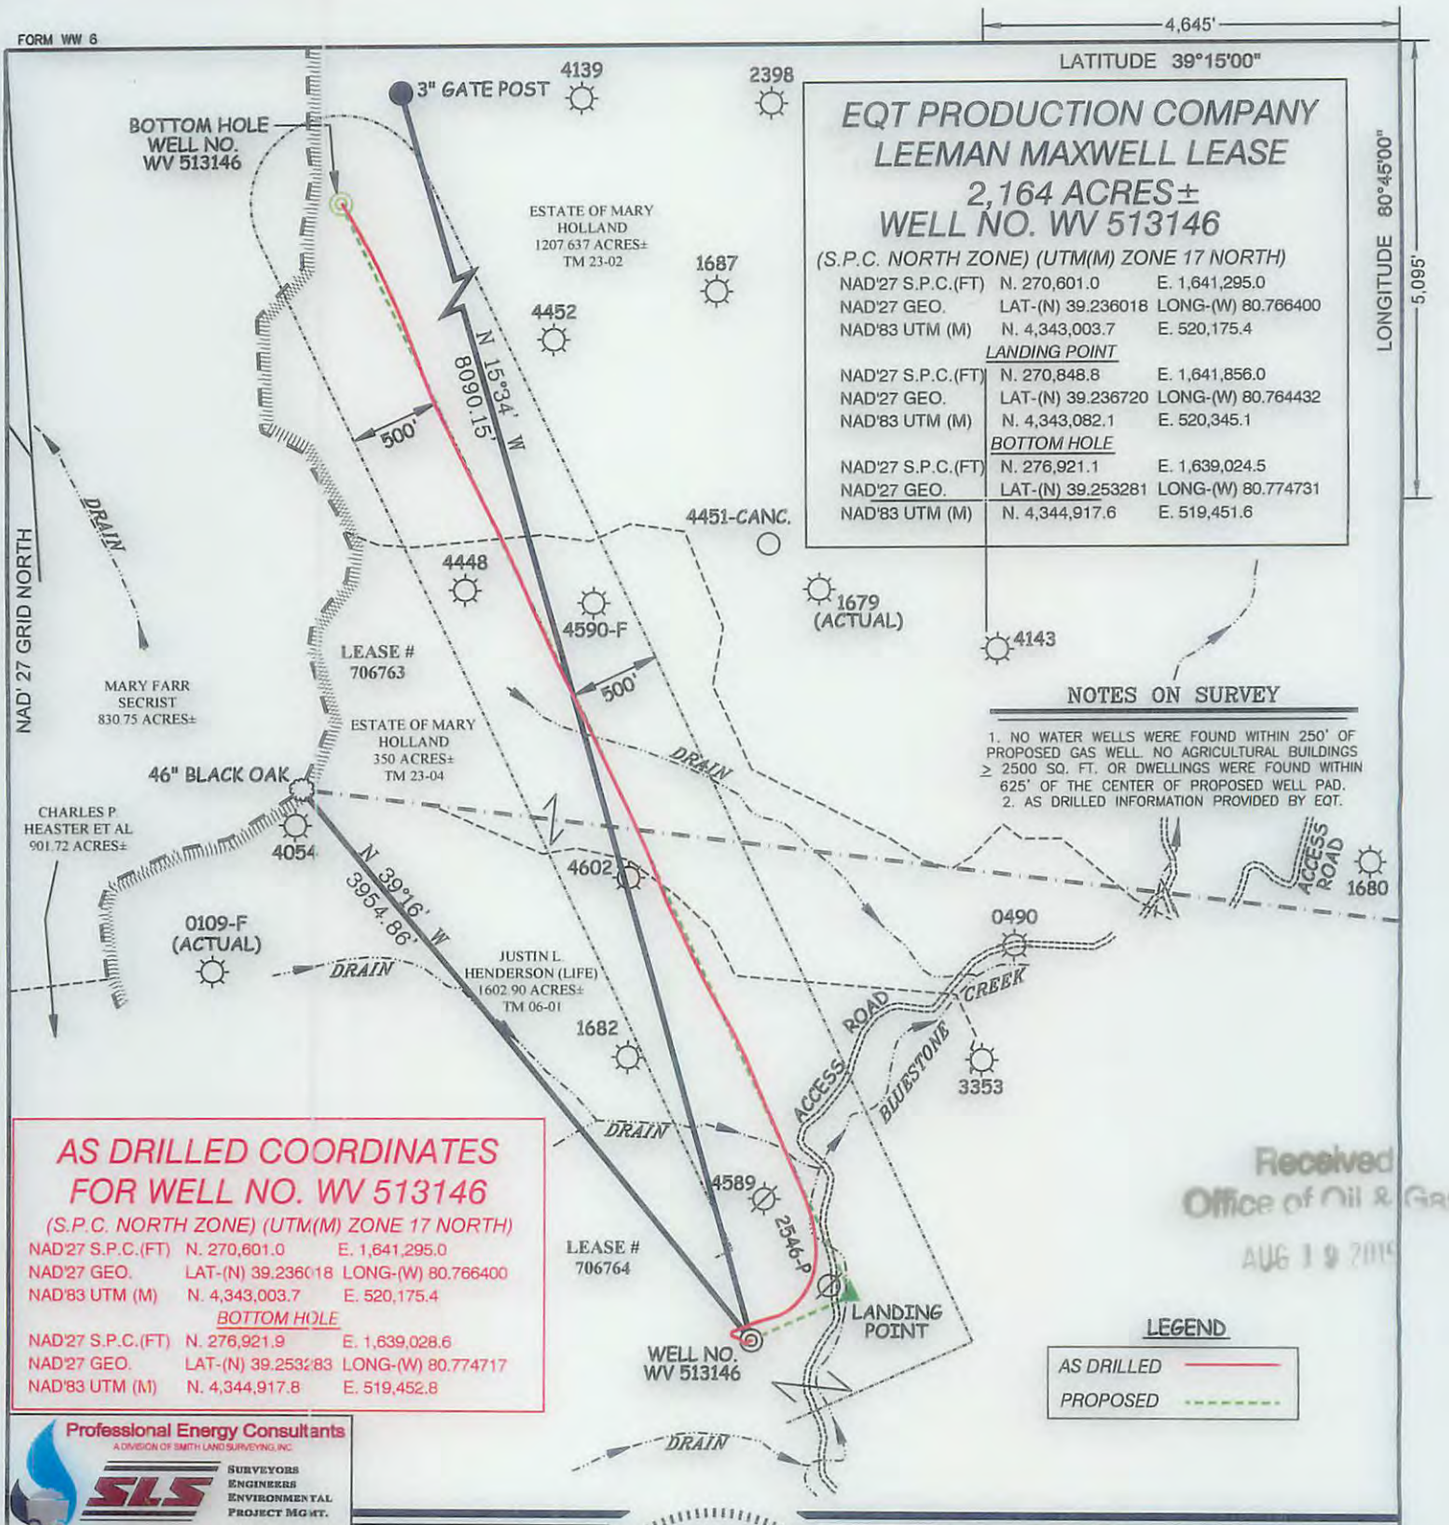

EQT PRODUCTION COMPANY
LEEMAN MAXWELL LEASE
2,164 ACRES±
WELL NO. WV 513146

(S.P.C. NORTH ZONE) (UTM(M) ZONE 17 NORTH)

NAD'27 S.P.C.(FT)	N. 270,601.0	E. 1,641,295.0
NAD'27 GEO.	LAT-(N) 39.236018	LONG-(W) 80.766400
NAD'83 UTM (M)	N. 4,343,003.7	E. 520,175.4
	LANDING POINT	
NAD'27 S.P.C.(FT)	N. 270,848.8	E. 1,641,856.0
NAD'27 GEO.	LAT-(N) 39.236720	LONG-(W) 80.764432
NAD'83 UTM (M)	N. 4,343,082.1	E. 520,345.1
	BOTTOM HOLE	
NAD'27 S.P.C.(FT)	N. 276,921.1	E. 1,639,024.5
NAD'27 GEO.	LAT-(N) 39.253281	LONG-(W) 80.774731
NAD'83 UTM (M)	N. 4,344,917.6	E. 519,451.6

NOTES ON SURVEY

1. NO WATER WELLS WERE FOUND WITHIN 250' OF PROPOSED GAS WELL. NO AGRICULTURAL BUILDINGS ≥ 2500 SQ. FT. OR DWELLINGS WERE FOUND WITHIN 625' OF THE CENTER OF PROPOSED WELL PAD.
2. AS DRILLED INFORMATION PROVIDED BY EQT.

AS DRILLED COORDINATES
FOR WELL NO. WV 513146

(S.P.C. NORTH ZONE) (UTM(M) ZONE 17 NORTH)

NAD'27 S.P.C.(FT)	N. 270,601.0	E. 1,641,295.0
NAD'27 GEO.	LAT-(N) 39.236018	LONG-(W) 80.766400
NAD'83 UTM (M)	N. 4,343,003.7	E. 520,175.4
	BOTTOM HOLE	
NAD'27 S.P.C.(FT)	N. 276,921.9	E. 1,639,028.6
NAD'27 GEO.	LAT-(N) 39.253283	LONG-(W) 80.774717
NAD'83 UTM (M)	N. 4,344,917.8	E. 519,452.8

LEGEND

AS DRILLED ——————

PROPOSED - - - - - - -

Received
Office of Oil & Gas
AUG 19 2015

Professional Energy Consultants
A DIVISION OF SMITH LAND SURVEYING, INC.
SLS SURVEYORS ENGINEERS ENVIRONMENTAL PROJECT MGMT.
(304) 462-5634 WWW.SLSSURVEYS.COM

I THE UNDERSIGNED, HEREBY CERTIFY THAT THIS PLAT IS CORRECT TO THE BEST OF MY KNOWLEDGE AND BELIEF AND SHOWS ALL THE INFORMATION REQUIRED BY LAW AND THE REGULATIONS ISSUED AND PRESCRIBED BY THE DIVISION OF ENVIRONMENTAL PROTECTION.

P.S. 677 Gregory A. Smith

GREGORY A. SMITH LICENSED No. 677 STATE OF WEST VIRGINIA PROFESSIONAL SURVEYOR

(+) DENOTES LOCATION OF WELL ON UNITED STATES TOPOGRAPHIC MAPS.

DATE APRIL 16 , 20 13

REVISED 03/06/14 & 01/13/15

OPERATORS WELL NO. WV 513146

API WELL NO. 47 — 017 — 06460
STATE COUNTY PERMIT

MINIMUM DEGREE OF ACCURACY 1 / 200

FILE NO. 7889ASDRILLED513146

SCALE 1" = 1000'

HORIZONTAL & VERTICAL CONTROL DETERMINED BY DGPS (SURVEY GRADE TIE TO CORS NETWORK)

STATE OF WEST VIRGINIA
DIVISION OF ENVIRONMENTAL PROTECTION
OFFICE OF OIL AND GAS

WELL TYPE: OIL ____ GAS X LIQUID INJECTION ____ WASTE DISPOSAL ____ IF "GAS" PRODUCTION X STORAGE ____ DEEP ____ SHALLOW X

LOCATION :

ELEVATION 969'(GROUND) 968'(PROPOSED) WATERSHED BLUESTONE CREEK

DISTRICT WEST UNION COUNTY DODDRIDGE QUADRANGLE OXFORD 7.5'

SURFACE OWNER JUSTIN L. HENDERSON (LIFE) ACREAGE 1,602.90±

ROYALTY OWNER LEEMAN MAXWELL HRS ACREAGE (2,164±) (1,000±)

PROPOSED WORK :

LEASE NO. 706764 / 706763

DRILL X CONVERT ____ DRILL DEEPER ____ REDRILL ____ FRACTURE OR STIMULATE X PLUG OFF OLD FORMATION ____ PERFORATE NEW FORMATION ____ PLUG AND ABANDON ____ CLEAN OUT AND REPLUG ____ OTHER ____

PHYSICAL CHANGE IN WELL (SPECIFY) ____

TARGET FORMATION MARCELLUS

ESTIMATED DEPTH 6399'

10/09/2015

COUNTY PERMIT

WELL OPERATOR EQT PRODUCTION COMPANY
ADDRESS 115 PROFESSIONAL PLACE P.O. BOX 280
BRIDGEPORT, WV 26330

DESIGNATED AGENT REX C. RAY
ADDRESS 115 PROFESSIONAL PLACE P.O. BOX 280
BRIDGEPORT, WV 26330

SLS
124600