FORM WW 6

8,522'

LATITUDE 39°17'30"

LONGITUDE 80°42'30"

10,475'

NAD' 27 GRID NORTH

EQT PRODUCTION COMPANY
MAXWELL LEASE
1447.16 ACRES±
WELL NO. WV 514139
(SMI28 H7)

(S.P.C. NORTH ZONE) (UTM(M) ZONE 17 NORTH)

NAD'27 S.P.C.(FT)	N. 280,283.8	E. 1,649,352.0
NAD'27 GEO.	LAT-(N) 39.262909	LONG-(W) 80.738429
NAD'83 UTM (M)	N. 4,345,994.6	E. 522,580.8
LANDING POINT		
NAD'27 S.P.C.(FT)	N. 281,082.3	E. 1,652,028.0
NAD'27 GEO.	LAT-(N) 39.265202	LONG-(W) 80.729018
NAD'83 UTM (M)	N. 4,346,251.4	E. 523,392.0
BOTTOM HOLE		
NAD'27 S.P.C.(FT)	N. 277,457.0	E. 1,653,718.4
NAD'27 GEO.	LAT-(N) 39.255313	LONG-(W) 80.722874
NAD'83 UTM (M)	N. 4,345,155.6	E. 523,925.4

LEGEND

LEASE LINE
SURFACE LINE
PROPOSED PATH
AS DRILLED PATH
OFFSET LINE
TIE LINE
CREEK
ROAD
FENCE LINE
COUNTY ROUTE
PLUGGED WELL
PROPOSED WELL
EXISTING WELL
PERMITTED WELL
TAX MAP–PARCEL 00–00

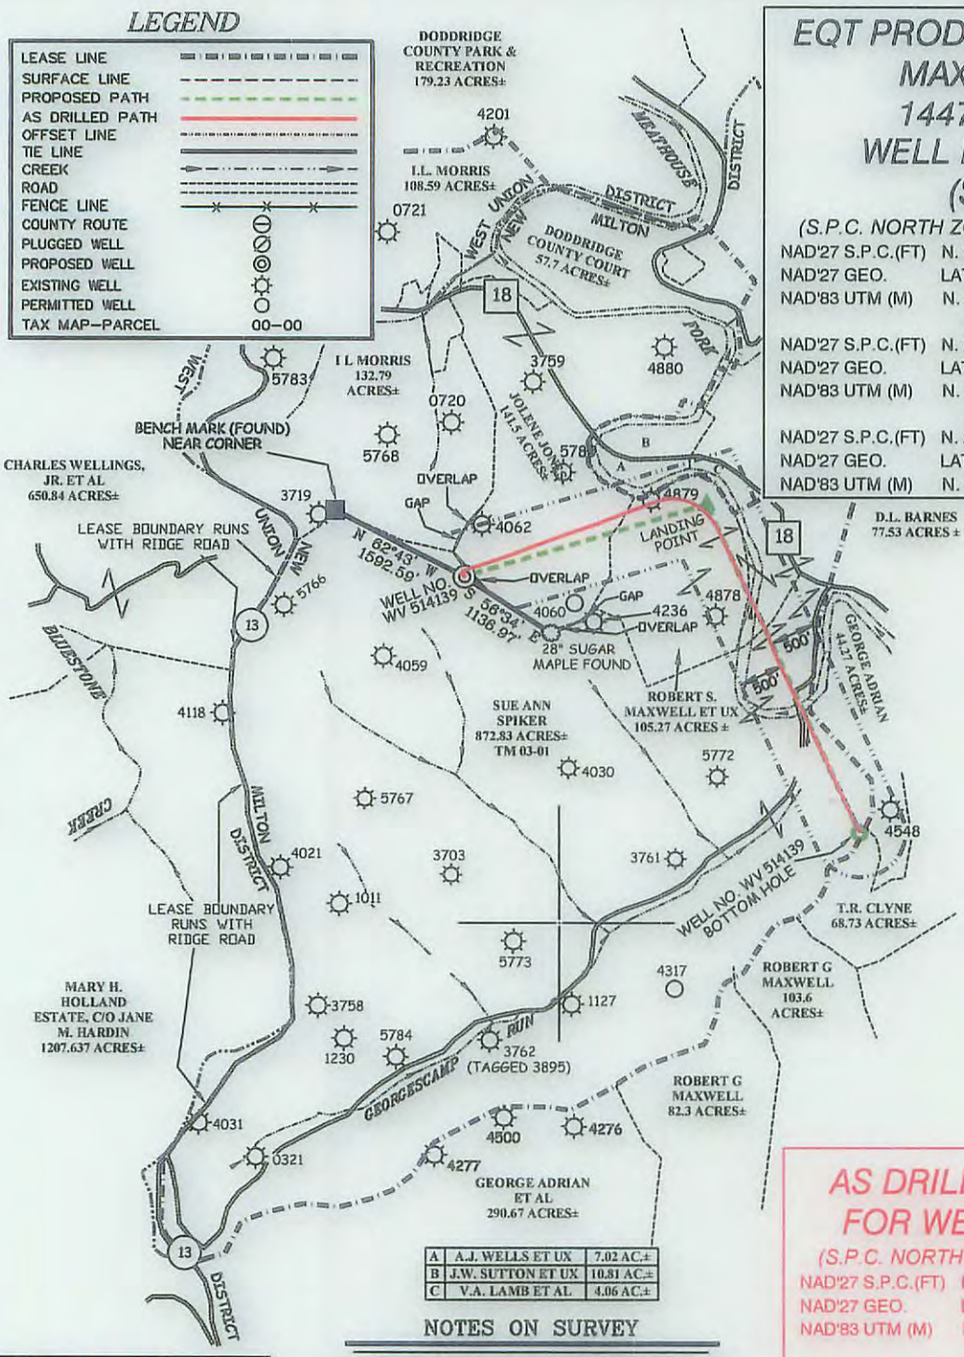

A	A.J. WELLS ET UX	7.02 AC.±
B	J.W. SUTTON ET UX	10.81 AC.±
C	V.A. LAMB ET AL	4.06 AC.±

AS DRILLED COORDINATES FOR WELL NO. WV 514139

(S.P.C. NORTH ZONE) (UTM(M) ZONE 17 NORTH)

NAD'27 S.P.C.(FT)	N. 280,283.8	E. 1,649,352.0
NAD'27 GEO.	LAT-(N) 39.262909	LONG-(W) 80.738429
NAD'83 UTM (M)	N. 4,345,994.6	E. 522,580.8
BOTTOM HOLE		
NAD'27 S.P.C.(FT)	N. 277,461.76	E. 1,653,721.39
NAD'27 GEO.	LAT-(N) 39.255326	LONG-(W) 80.722864
NAD'83 UTM (M)	N. 4,345,157.07	E. 523,926.28

NOTES ON SURVEY

1. NO WATER WELLS WERE FOUND WITHIN 250' OF PROPOSED GAS WELL. NO AGRICULTURAL BUILDINGS ≥ 2500 SQ. FT. OR DWELLINGS WERE FOUND WITHIN 625' OF THE CENTER OF PROPOSED WELL PAD.
2. AS DRILLED INFORMATION PROVIDED BY EQT.

Professional Energy Consultants
A DIVISION OF SMITH LAND SURVEYING, INC.
SLS SURVEYORS ENGINEERS ENVIRONMENTAL PROJECT MGMT.
(304) 462-5634 WWW.SLSSURVEYS.COM

I THE UNDERSIGNED, HEREBY CERTIFY THAT THIS PLAT IS CORRECT TO THE BEST OF MY KNOWLEDGE AND BELIEF AND SHOWS ALL THE INFORMATION REQUIRED BY LAW AND THE REGULATIONS ISSUED AND PRESCRIBED BY THE DIVISION OF ENVIRONMENTAL PROTECTION.

P.S. 2288 Earl N. Thompson

EARL N. THOMPSON LICENSED No. 2288 STATE OF WEST VIRGINIA PROFESSIONAL SURVEYOR

(+) DENOTES LOCATION OF WELL ON UNITED STATES TOPOGRAPHIC MAPS.

DATE AUGUST 19 , 20 14

REVISED NOVEMBER 12 , 20 15

OPERATORS WELL NO. WV 514139

API WELL NO. 47 — 017 — 06588H
STATE COUNTY PERMIT

MINIMUM DEGREE OF ACCURACY 1 / 200

FILE NO. 7428AD514139

SCALE 1" = 2,000'

HORIZONTAL & VERTICAL CONTROL DETERMINED BY DGPS (SURVEY GRADE TIE TO CORS NETWORK)

STATE OF WEST VIRGINIA
DIVISION OF ENVIRONMENTAL PROTECTION
OFFICE OF OIL AND GAS

WELL TYPE: OIL ___ GAS X LIQUID INJECTION ___ WASTE DISPOSAL ___ IF "GAS" PRODUCTION X STORAGE ___ DEEP ___ SHALLOW X

LOCATION:

ELEVATION 1254'(PAD ELEVATION) WATERSHED TRIBUTARY OF GEORGESCAMP RUN

DISTRICT NEW MILTON COUNTY DODDRIDGE QUADRANGLE SMITHBURG 7.5'

SURFACE OWNER SUE ANN SPIKER ACREAGE 872.83±

ROYALTY OWNER LEWIS MAXWELL HEIRS LEASE ACREAGE 1447.16± 02/05/2016

PROPOSED WORK: LEASE NO. 080617

DRILL X CONVERT ___ DRILL DEEPER ___ REDRILL ___ FRACTURE OR STIMULATE X PLUG OFF OLD FORMATION ___ PERFORATE NEW FORMATION ___ PLUG AND ABANDON ___ CLEAN OUT AND REPLUG ___ OTHER ___

PHYSICAL CHANGE IN WELL (SPECIFY) ___ TARGET FORMATION MARCELLUS

ESTIMATED DEPTH TVD 6,726'

COUNTY NAME PERMIT

WELL OPERATOR EQT PRODUCTION COMPANY **DESIGNATED AGENT** REX C. RAY

ADDRESS 115 PROFESSIONAL PLACE P.O. BOX 280 BRIDGEPORT, WV 26330

ADDRESS 115 PROFESSIONAL PLACE P.O. BOX 280 BRIDGEPORT, WV 26330

SLS 12/2015