

Latitude 39°17'30"

80° 35' 00"

Longitude

75'  
+

Topo Location

7.5' Loc. 1.66S 15' Loc. 4.54S  
0.28W (calc.) 0.28W

Company \_\_\_\_\_

Farm Ellen Kirk #1

15' Quad Centropnt SC  
(sec.)

7.5' Quad Salem

District GRANT

WELL LOCATION PLAT

County 017 Permit 30050






Well No. \_\_\_\_\_  
 Date \_\_\_\_\_  
 By \_\_\_\_\_  
 Title \_\_\_\_\_

Grant Dist

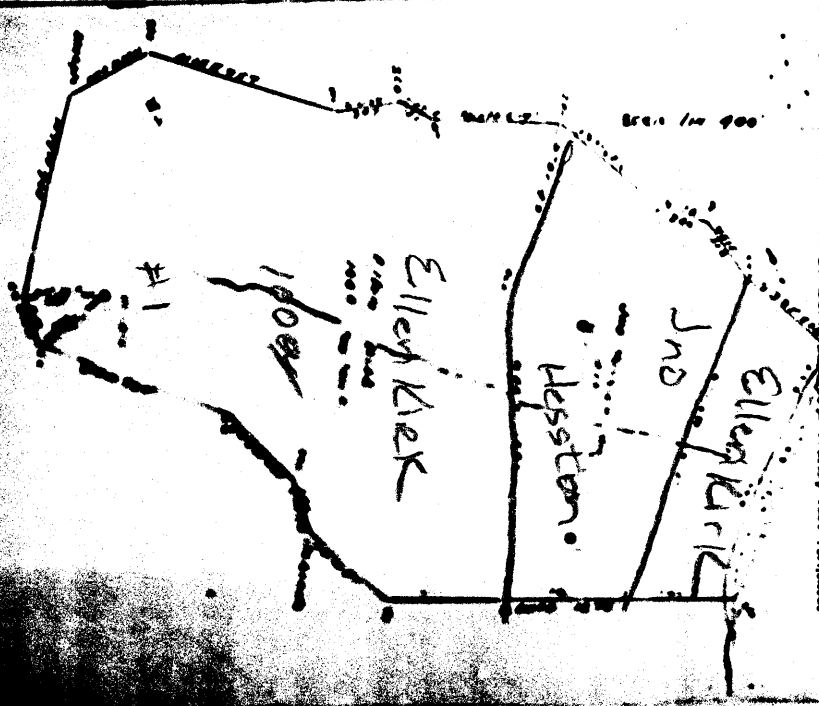

Scale 1" = 1000 feet  
 North is up






*8/1/40*

 







*Amey's*

#134-DH C Red

ELLEN KIRK NO. 1 WELL.

No. 43 O.F.-2-Doddridge.

Did - 50-A

Grant District, Doddridge County, W. Va.  
By South Penn Oil Co., P. O. Drawer 1255, Pittsburgh, Pa.  
On 100 acres (2 tracts), surface owned by F. M. Williams,  
Industrial, W. Va., and mineral rights by Ellen Hanafell,  
1409 E. Oak St., New Albany, Ind.  
Elevation, 1371' L.  
14' conductor; 10" casing, 545'; 8 $\frac{1}{4}$ " 1630'; 6-5/8" 2562'.  
Coal was encountered at 1120-1128'.  
Liner: 5 x 5 $\frac{1}{2}$ " F. J. liner, 3203-2982'.  
Abandonment reported to Dept. of Mines July 10, 1931.  
Well was shot twice.....?  
Producing hole.

|                                      | Top. | Bottom. |
|--------------------------------------|------|---------|
| Conductor                            | 0    | 14      |
| Pittsburgh Coal                      | 1120 | 1128    |
| Dunkard Sand                         | 1635 | 1695    |
| Salt Sand                            | 2040 | 2080    |
| Big Lime                             | 2405 | 2475    |
| Big Injun Sand                       | 2475 | 2555    |
| 50-Ft. Sand                          | 3060 | 3075    |
| Stray Sand                           | 3165 | 3170    |
| Gordon Sand (gas, 3166'; oil, 3203') | 3200 | 3213    |
| Total depth                          |      | 3228    |