


39° 25'

LATITUDE

08, 4, 08

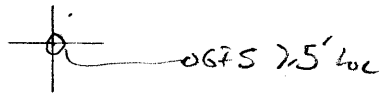

LONGITUDE

7.5 OGIS topo location

7.5' loc 1.35S 15' loc \_\_\_\_\_  
 1.15W (calc.) \_\_\_\_\_

Company \_\_\_\_\_

Farm \_\_\_\_\_

Quad Center Point

County \_\_\_\_\_

District McClellan

WELL LOCATION MAP

File No. 017-30163



Formation	Color	Hard or Soft	Top	Bottom	Oil, Gas or Water	Depth Found	Remarks

Date November 10, 1936

APPROVED SOUTH PENN OIL COMPANY, Owner

By Elton Young Land Agent.  
(Title)

McClellan District, Doddridge County, W. Va.  
 By South Penn Oil Co., C. of C. Bldg., Pittsburgh, Pa.  
 On 280 acres; surface owned by Ray and Esta George, Star Route,  
 West Union, W. Va., and minerals by Silas Langfitt Heirs,  
 %S. Benton Langfitt, Agent, 615 $\frac{1}{2}$  Market St., Parkersburg, W. Va.  
 Elevation, 744.12' L.  
 Drilling commenced May 8, 1894; completed June 20, 1894.  
 Shot 11-22-04; 9-26-07; 9-18-19; and 7-29-22.  
 52 bbls. oil first 24 hrs.  
 10" casing, 417'; 8 $\frac{1}{4}$ " , 960'; 5 $\frac{3}{16}$ " , 1802'; 3" tubing, 1828 $\frac{1}{2}$ '.  
 Coal was encountered at 477-482' (Est.)  
 Oil well. Abandonment reported to Dept. of Mines Nov. 10, 1936.  
 Record to RCT from D.G. Courtney (Dept. of Mines) 5-5-37.

	Top.	Bottom.
Pittsburgh Coal	477	482 (Est.)
Big Injun Sand (1st pay, 1882'; 2nd pay,.....?)	1805	
Total depth		1901 $\frac{1}{2}$