m

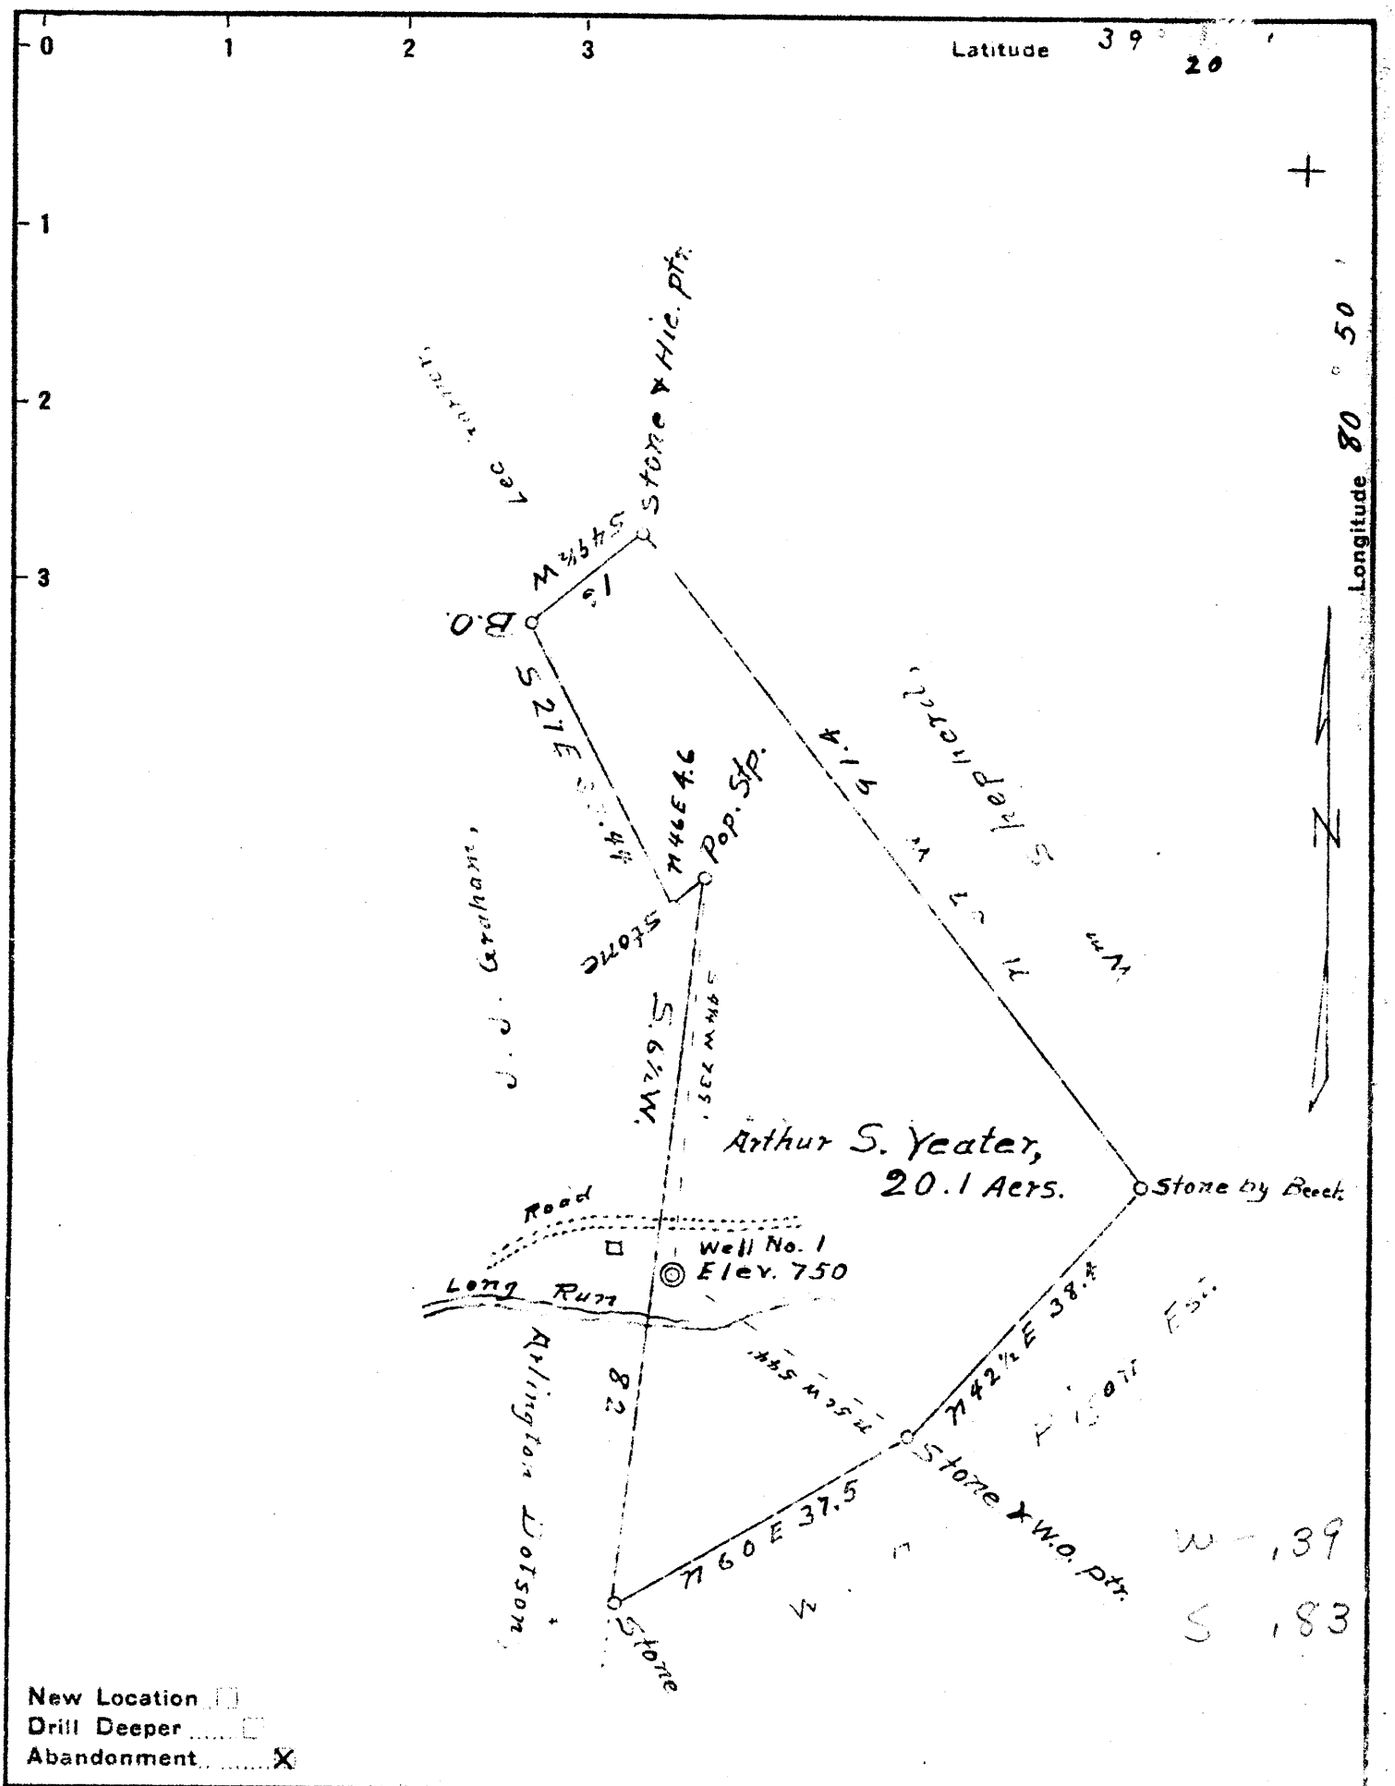

New Location ☐
Drill Deeper ☐
Abandonment ☒

Company N.J. Graham, Agt. et al.
Address West Union, W.Va.
Farm Arthur S. Yeater,
Tract One Acres 20.1 Lease No.
Well (Farm) No. Serial No.
Elevation (Spirit Level) 750
Quadrangle West Union SC
County Doddridge District Central,
Engineer J.M. Martin,
Engineer's Registration No. 84
File No. Drawing No.
Date 20 Scale 20 P = 1"

STATE OF WEST VIRGINIA
DEPARTMENT OF MINES
OIL AND GAS DIVISION
CHARLESTON

WELL LOCATION MAP

FILE NO. DOD-335A

Wat 01771426

+ Denotes location of well on United States Topographic Maps, scale 1 to 62,500, latitude and longitude lines being represented by border lines as shown.

— Denotes one inch spaces on border line of original tracing.