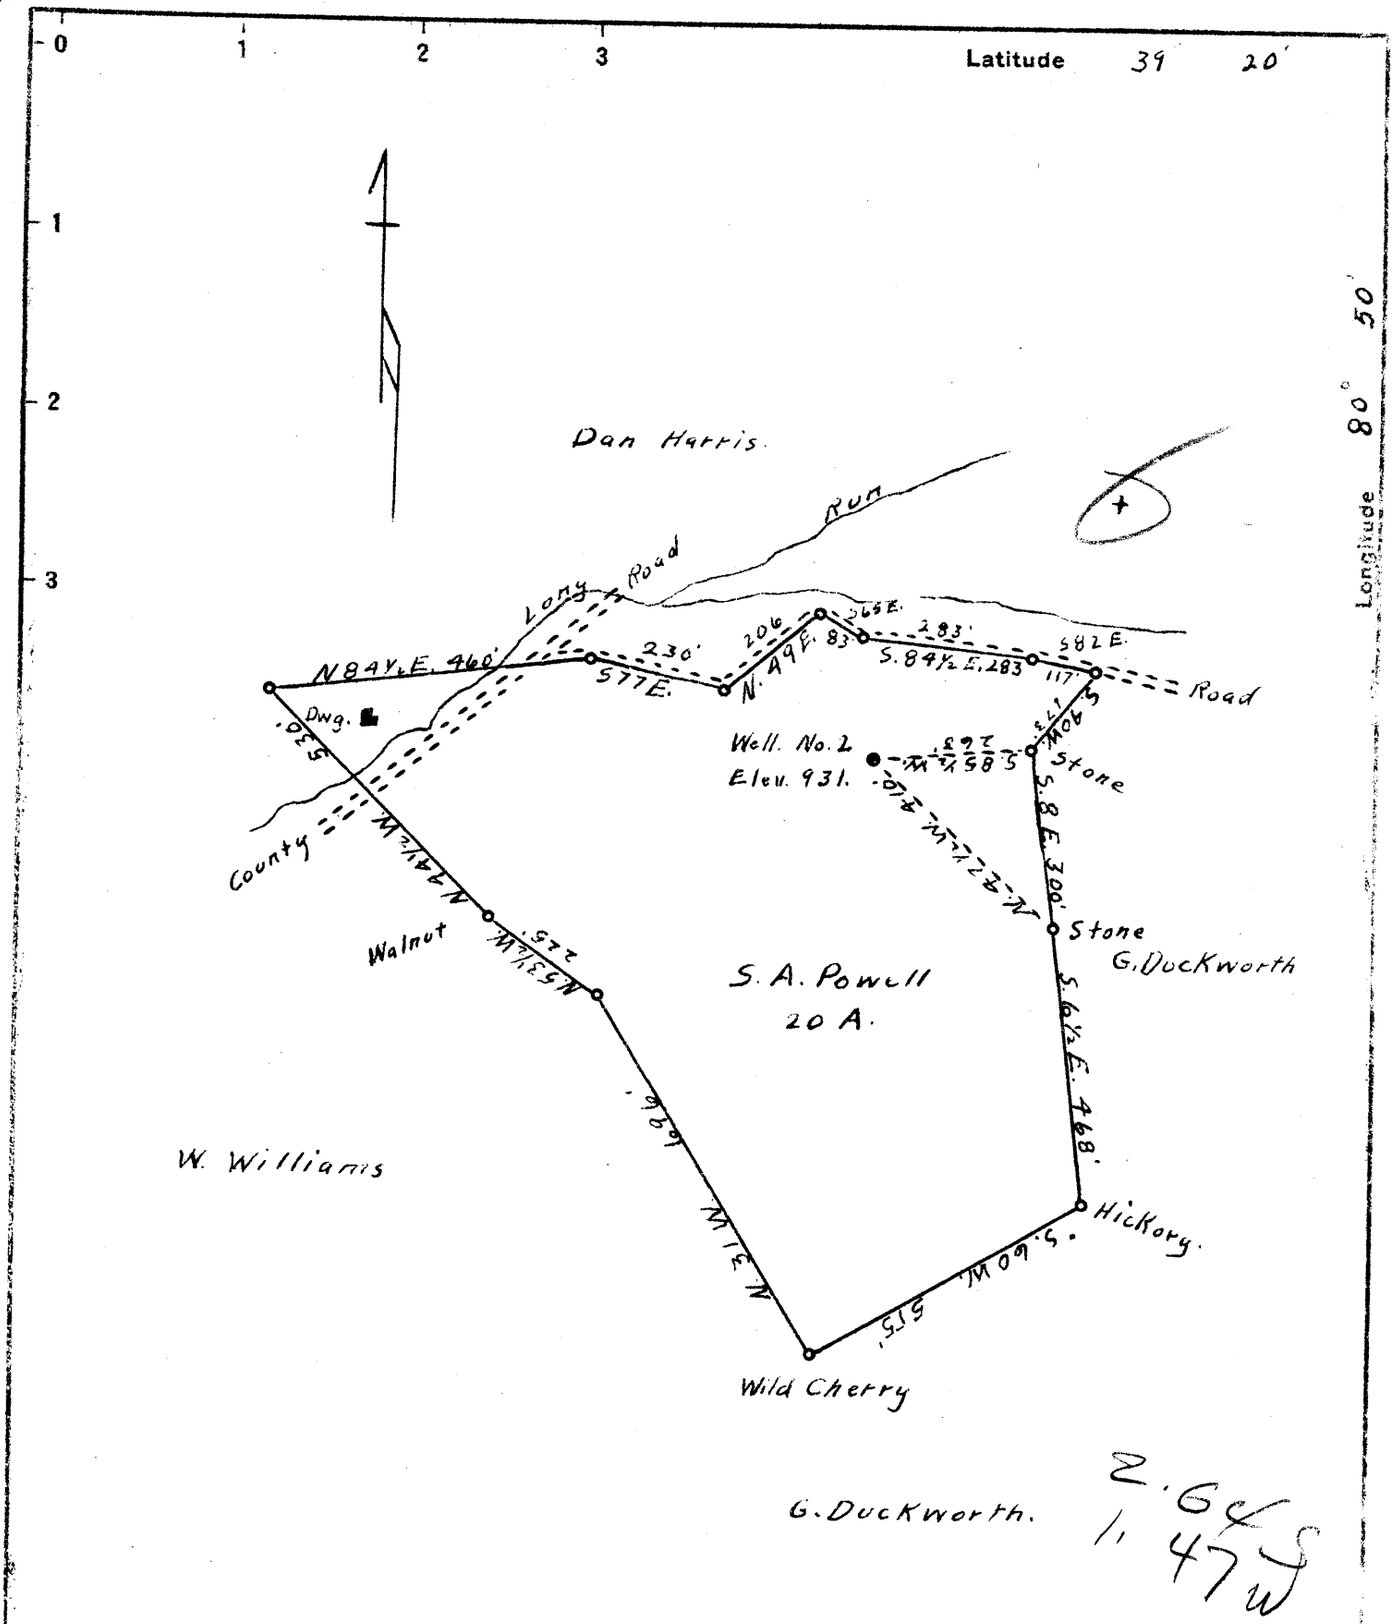

New Location
Drill Deeper
Abandonment +

7.5' loc
2,535 37 20
1,93 W 80 50
Kla 9/15/98
1" loc cale.

Company Reno Oil Co.
Address Sistersville West Va.
Farm S. A. Powell
Tract _____ Acres 20 Lease No. _____
Well (Farm) No. 2 Serial No. _____
Elevation (Spirit Level) 931
Quadrangle West Union
County Doddridge District Central
Engineer A K Westfall
Engineer's Registration No. Co. Surveyor, Ritchie, Co.
File No. _____ Drawing No. _____
Date June 3, 1942 Scale 1" = 300'

STATE OF WEST VIRGINIA
DEPARTMENT OF MINES
OIL AND GAS DIVISION
CHARLESTON

WELL LOCATION MAP

FILE NO. DOD-398-A

+ Denotes location of well on United States Topographic Maps, scale 1 to 62,500, latitude and longitude lines being represented by border lines as shown.

— Denotes one inch spaces on border line of original tracing.