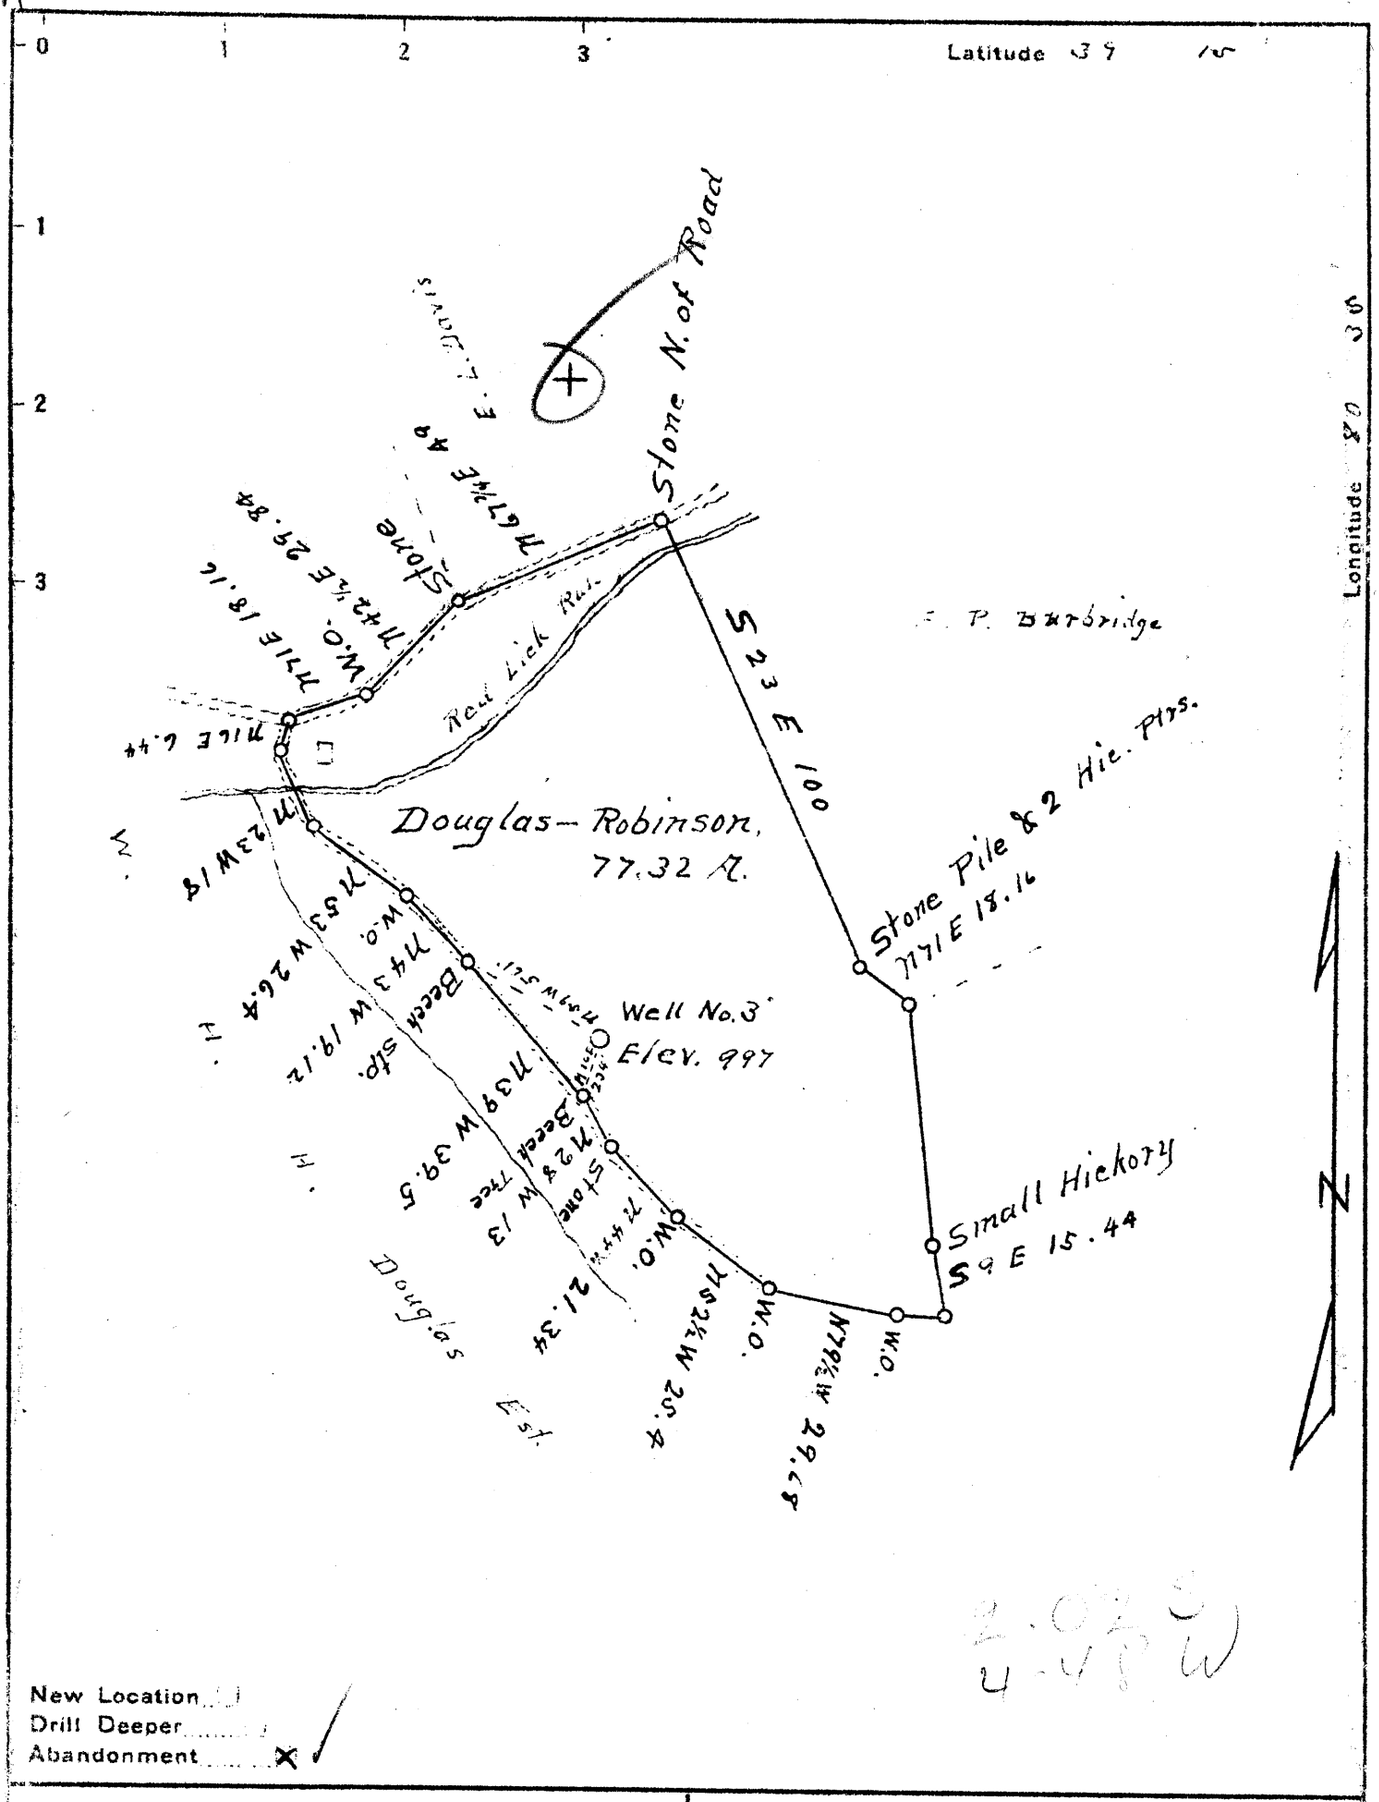

New Location
Drill Deeper
Abandonment ✗

Company Trainer and Travis,
Address West Union, W.Va.
Farm Douglas - Robison
Tract One Acres 77.32 Lease No.
Well (Farm) No. 3 Serial No.
Elevation (Spirit Level) 997
Quadrangle Vadis
County Doddridge District New Milton
Engineer J. M. Martin
Engineer's Registration No. 84
File No. Drawing No.
Date Sept 3rd 1942 Scale 40 P = 1"

STATE OF WEST VIRGINIA
DEPARTMENT OF MINES
OIL AND GAS DIVISION
CHARLESTON

WELL LOCATION MAP

FILE NO. D.O.D.-412-A

+ Denotes location of well on United States Topographic Maps, scale 1 to 62,500, latitude and longitude lines being represented by border lines as shown.

— Denotes one inch spaces on border line of original tracing.

IMPERIAL TRACING CLOTH