
4703300836 P

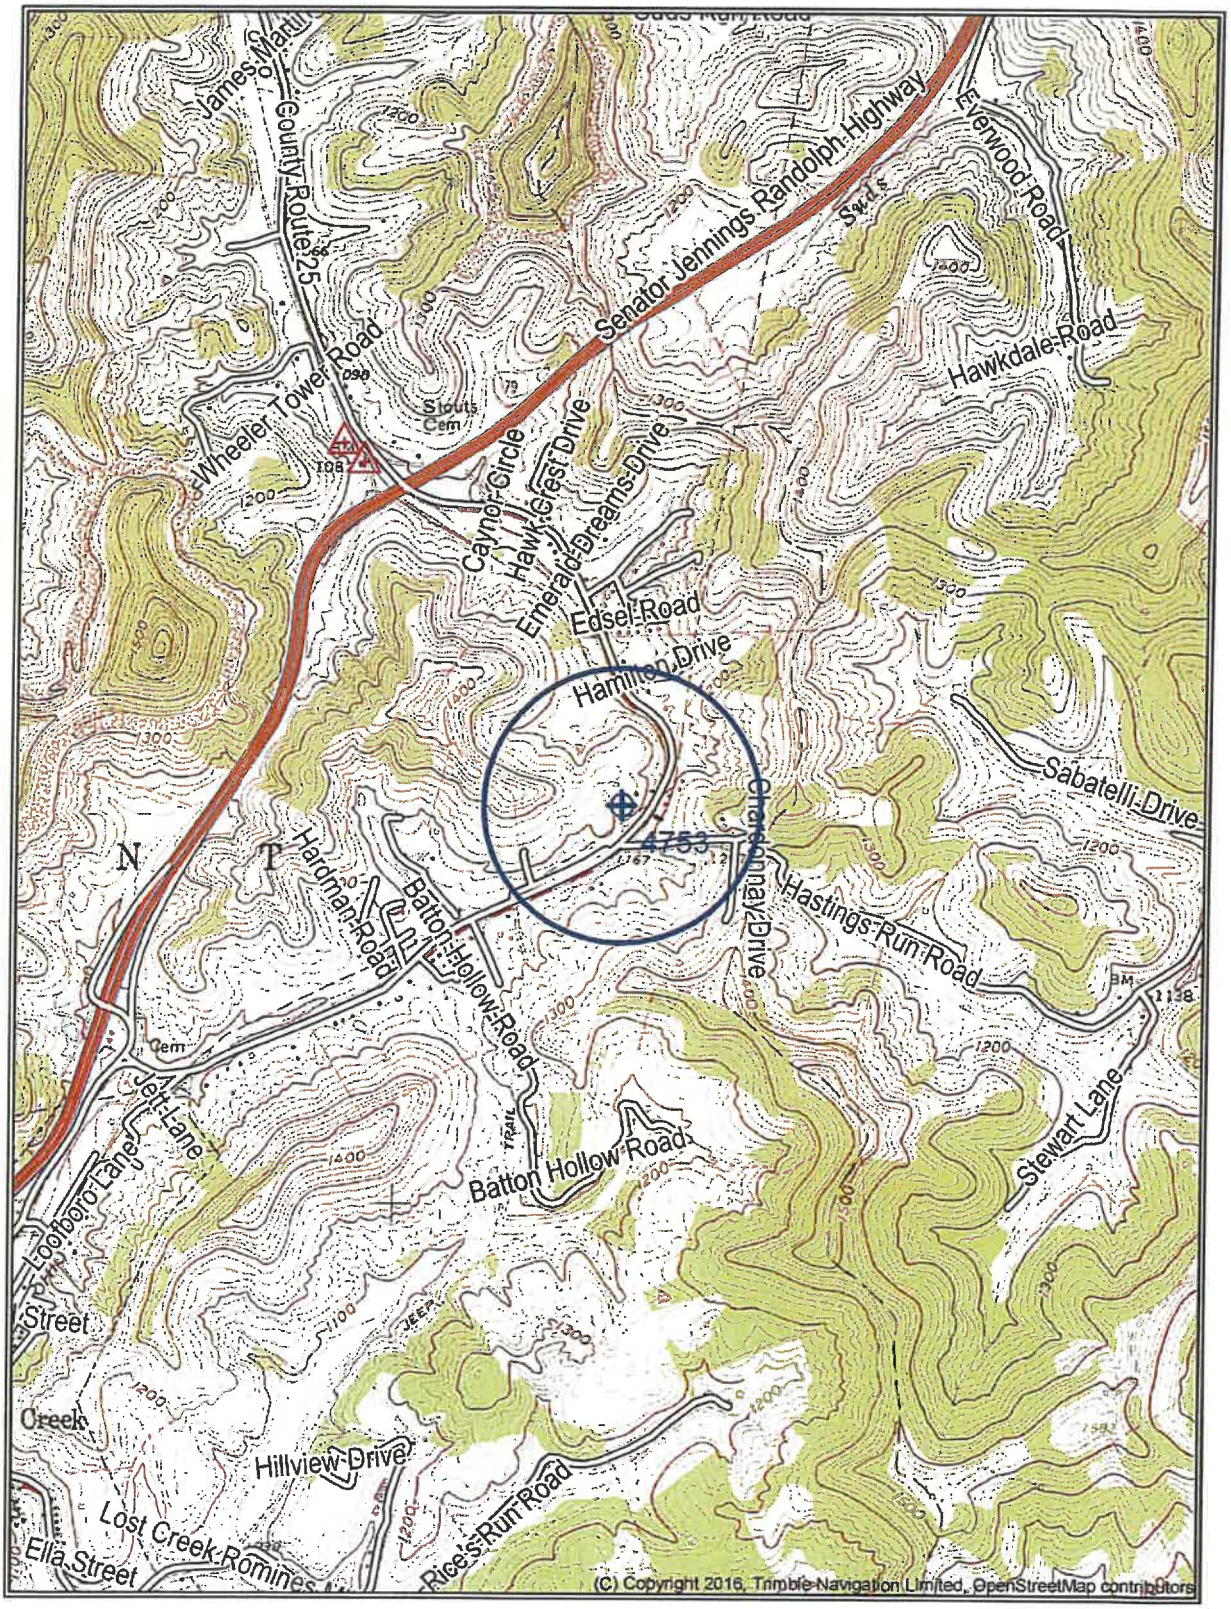

SCALE 1:24000

0 1000 2000 3000 4000 5000 6000

Feet

10/16/2026

4703300836P

WW-7
8-30-06

West Virginia Department of Environmental Protection
Office of Oil and Gas
WELL LOCATION FORM: GPS

API: 47-033-00836 **WELL NO.:** 4753

FARM NAME: Rebecca Bond

RESPONSIBLE PARTY NAME: Eastern Gas Transmission and Storage

COUNTY: Harrison **DISTRICT:** Grant

QUADRANGLE: Mount Clare

SURFACE OWNER: John William Rymer, L/E, and Ann Kessler,Remainder

ROYALTY OWNER: John William Rymer etal

UTM GPS NORTHING: 4336813

UTM GPS EASTING: 558354 **GPS ELEVATION:** 362.73m / 1190'

The Responsible Party named above has chosen to submit GPS coordinates in lieu of preparing a new well location plat for a plugging permit or assigned API number on the above well. The Office of Oil and Gas will not accept GPS coordinates that do not meet the following requirements:

1. Datum: NAD 1983, Zone: 17 North, Coordinate Units: meters, Altitude: height above mean sea level (MSL) – meters.
2. Accuracy to Datum – 3.05 meters
3. Data Collection Method:

Survey grade GPS ____: Post Processed Differential _____

Real-Time Differential _____

Mapping Grade GPS X: Post Processed Differential _____

Real-Time Differential _____

4. **Letter size copy of the topography map showing the well location.**

I the undersigned, hereby certify this data is correct to the best of my knowledge and belief and shows all the information required by law and the regulations issued and prescribed by the Office of Oil and Gas.

Signature Director - Surface Title 9-28-2026 Date

10/16/2026