

WW-7
8-30-06



West Virginia Department of Environmental Protection
Office of Oil and Gas
WELL LOCATION FORM: GPS

API: 47-033-00933 WELL NO. A-547

FARM NAME: Hiram Munday

RESPONSIBLE PARTY NAME: Diversified Production LLC

COUNTY: Harrison DISTRICT: Grant

QUADRANGLE: Weston

SURFACE OWNER: Larry D. Myers Revocable Trust

ROYALTY OWNER: Diversified Production LLC

UTM GPS NORTHING: 4,338,037.57

UTM GPS EASTING: 550,748.91 GPS ELEVATION: 1,052'

The Responsible Party named above has chosen to submit GPS coordinates in lieu of preparing a new well location plat for a plugging permit or assigned API number on the above well. The Office of Oil and Gas will not accept GPS coordinates that do not meet the following requirements:

- Datum: NAD 1983, Zone: 17 North, Coordinate Units: meters, Altitude: height above mean sea level (MSL) – meters.
- Accuracy to Datum – 3.05 meters.
- Data Collection Method:
Survey grade GPS _____; Post Processed Differential _____
Real-Time Differential _____
Mapping Grade GPS X _____; Post Processed Differential X _____
Real-Time Differential _____

RECEIVED

Office of Oil and Gas

FEB 01 2022

WV Department of Environmental Protection

4. Letter size copy of the topography map showing the well location.
I the undersigned, hereby certify this data is correct to the best of my knowledge and belief and shows all the information required by law and the regulations issued and prescribed by the Office of Oil and Gas.

[Signature]
Signature

Director Technical Services
Title

1/31/2022
Date




Diversified Gas & Oil
Corporation
100 Diversified Way
Pikeville KY, 41051

33
47-041-00933

Plugging Map

Legend

- Well
- Access Road
- Pits
- Pad
- Public Roads

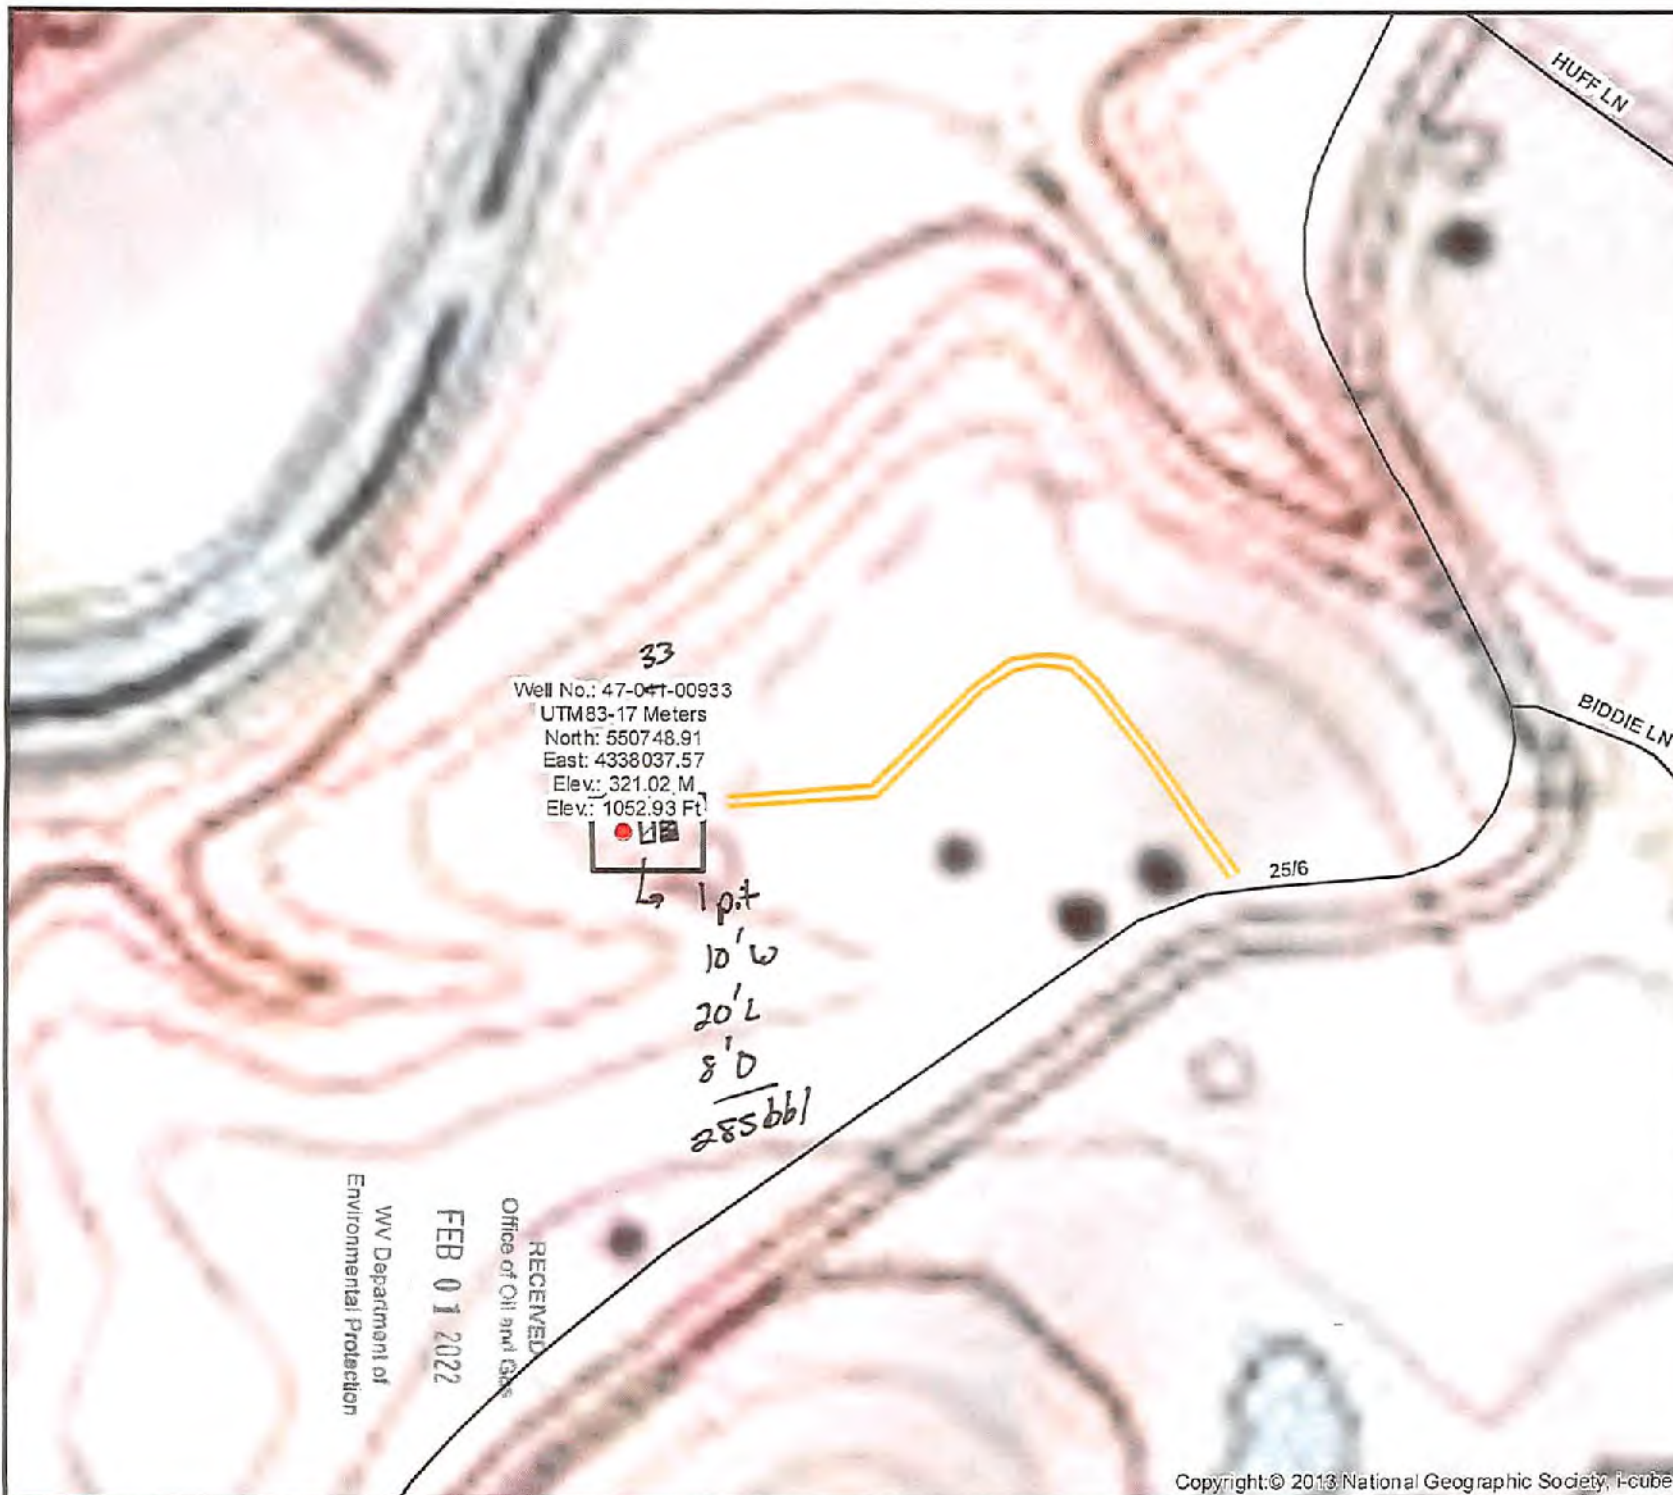


33
Well No.: 47-041-00933
UTM83-17 Meters
North: 550748.91
East: 4338037.57
Elev.: 321.02 M
Elev.: 1052.93 Ft



1 pit
10' W
20' L
8' D
199538


RECEIVED
Office of Oil and Gas
WV Department of
Environmental Protection
FEB 01 2022

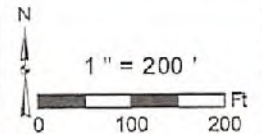

4703300933P

4703300933P

47-033-00933

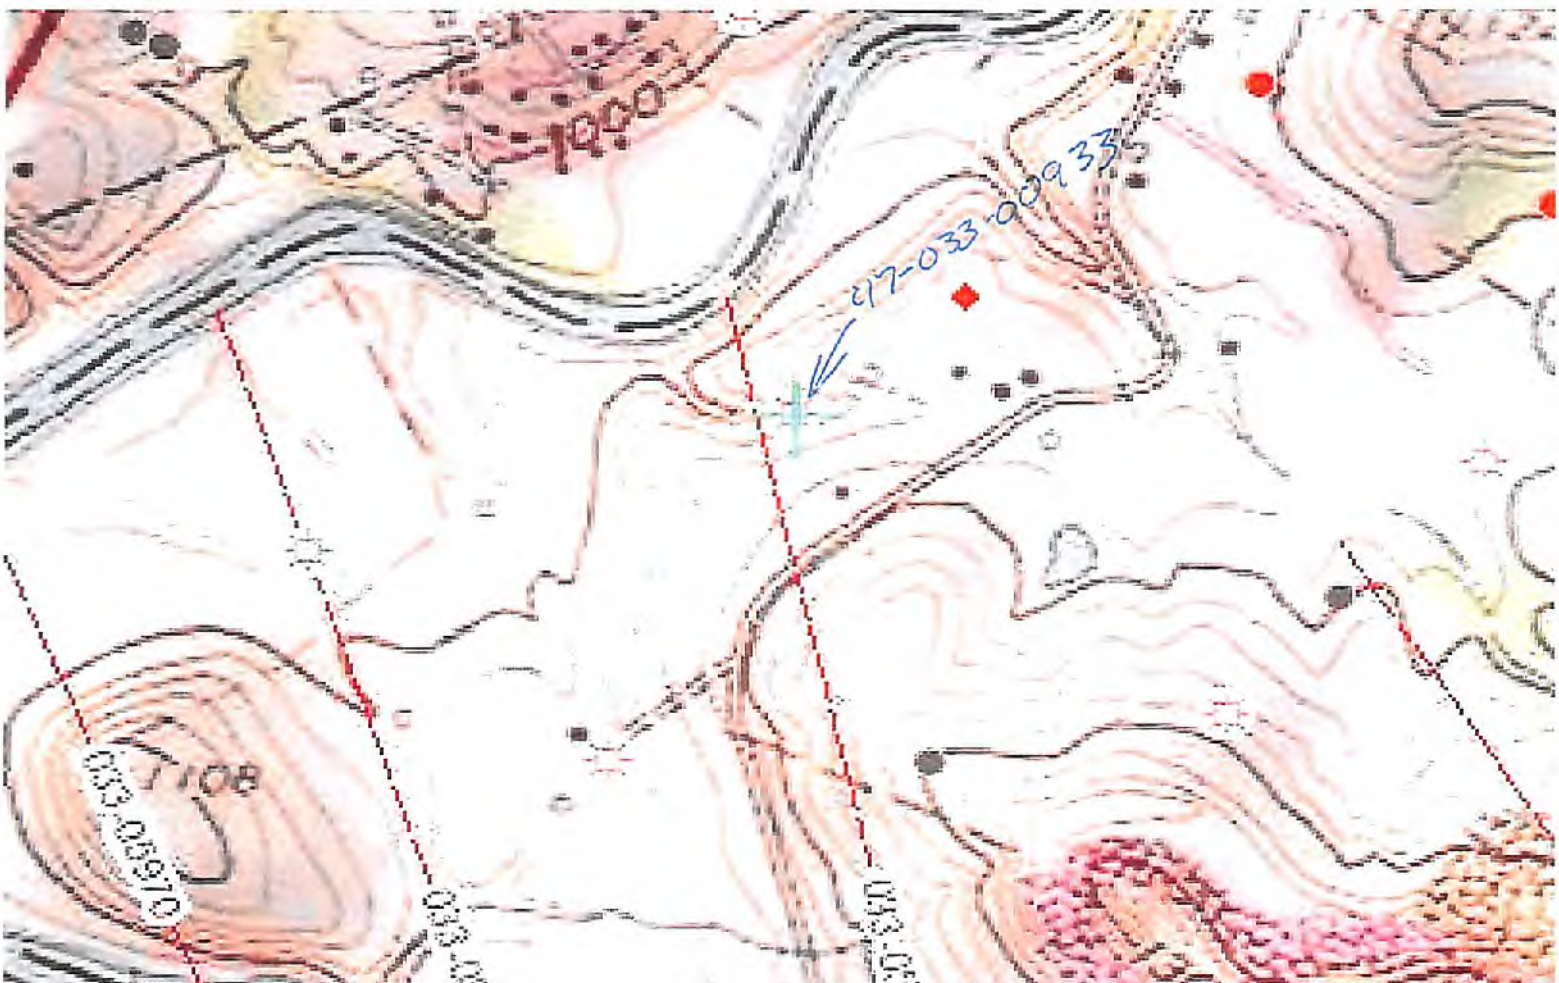


RECEIVED
Office of Oil and Gas
FEB 01 2022
WV Department of
Environmental Protection

47-033-00933P

47-033-00933-00-00

550749E, 4338038N, UTM17 NAD83

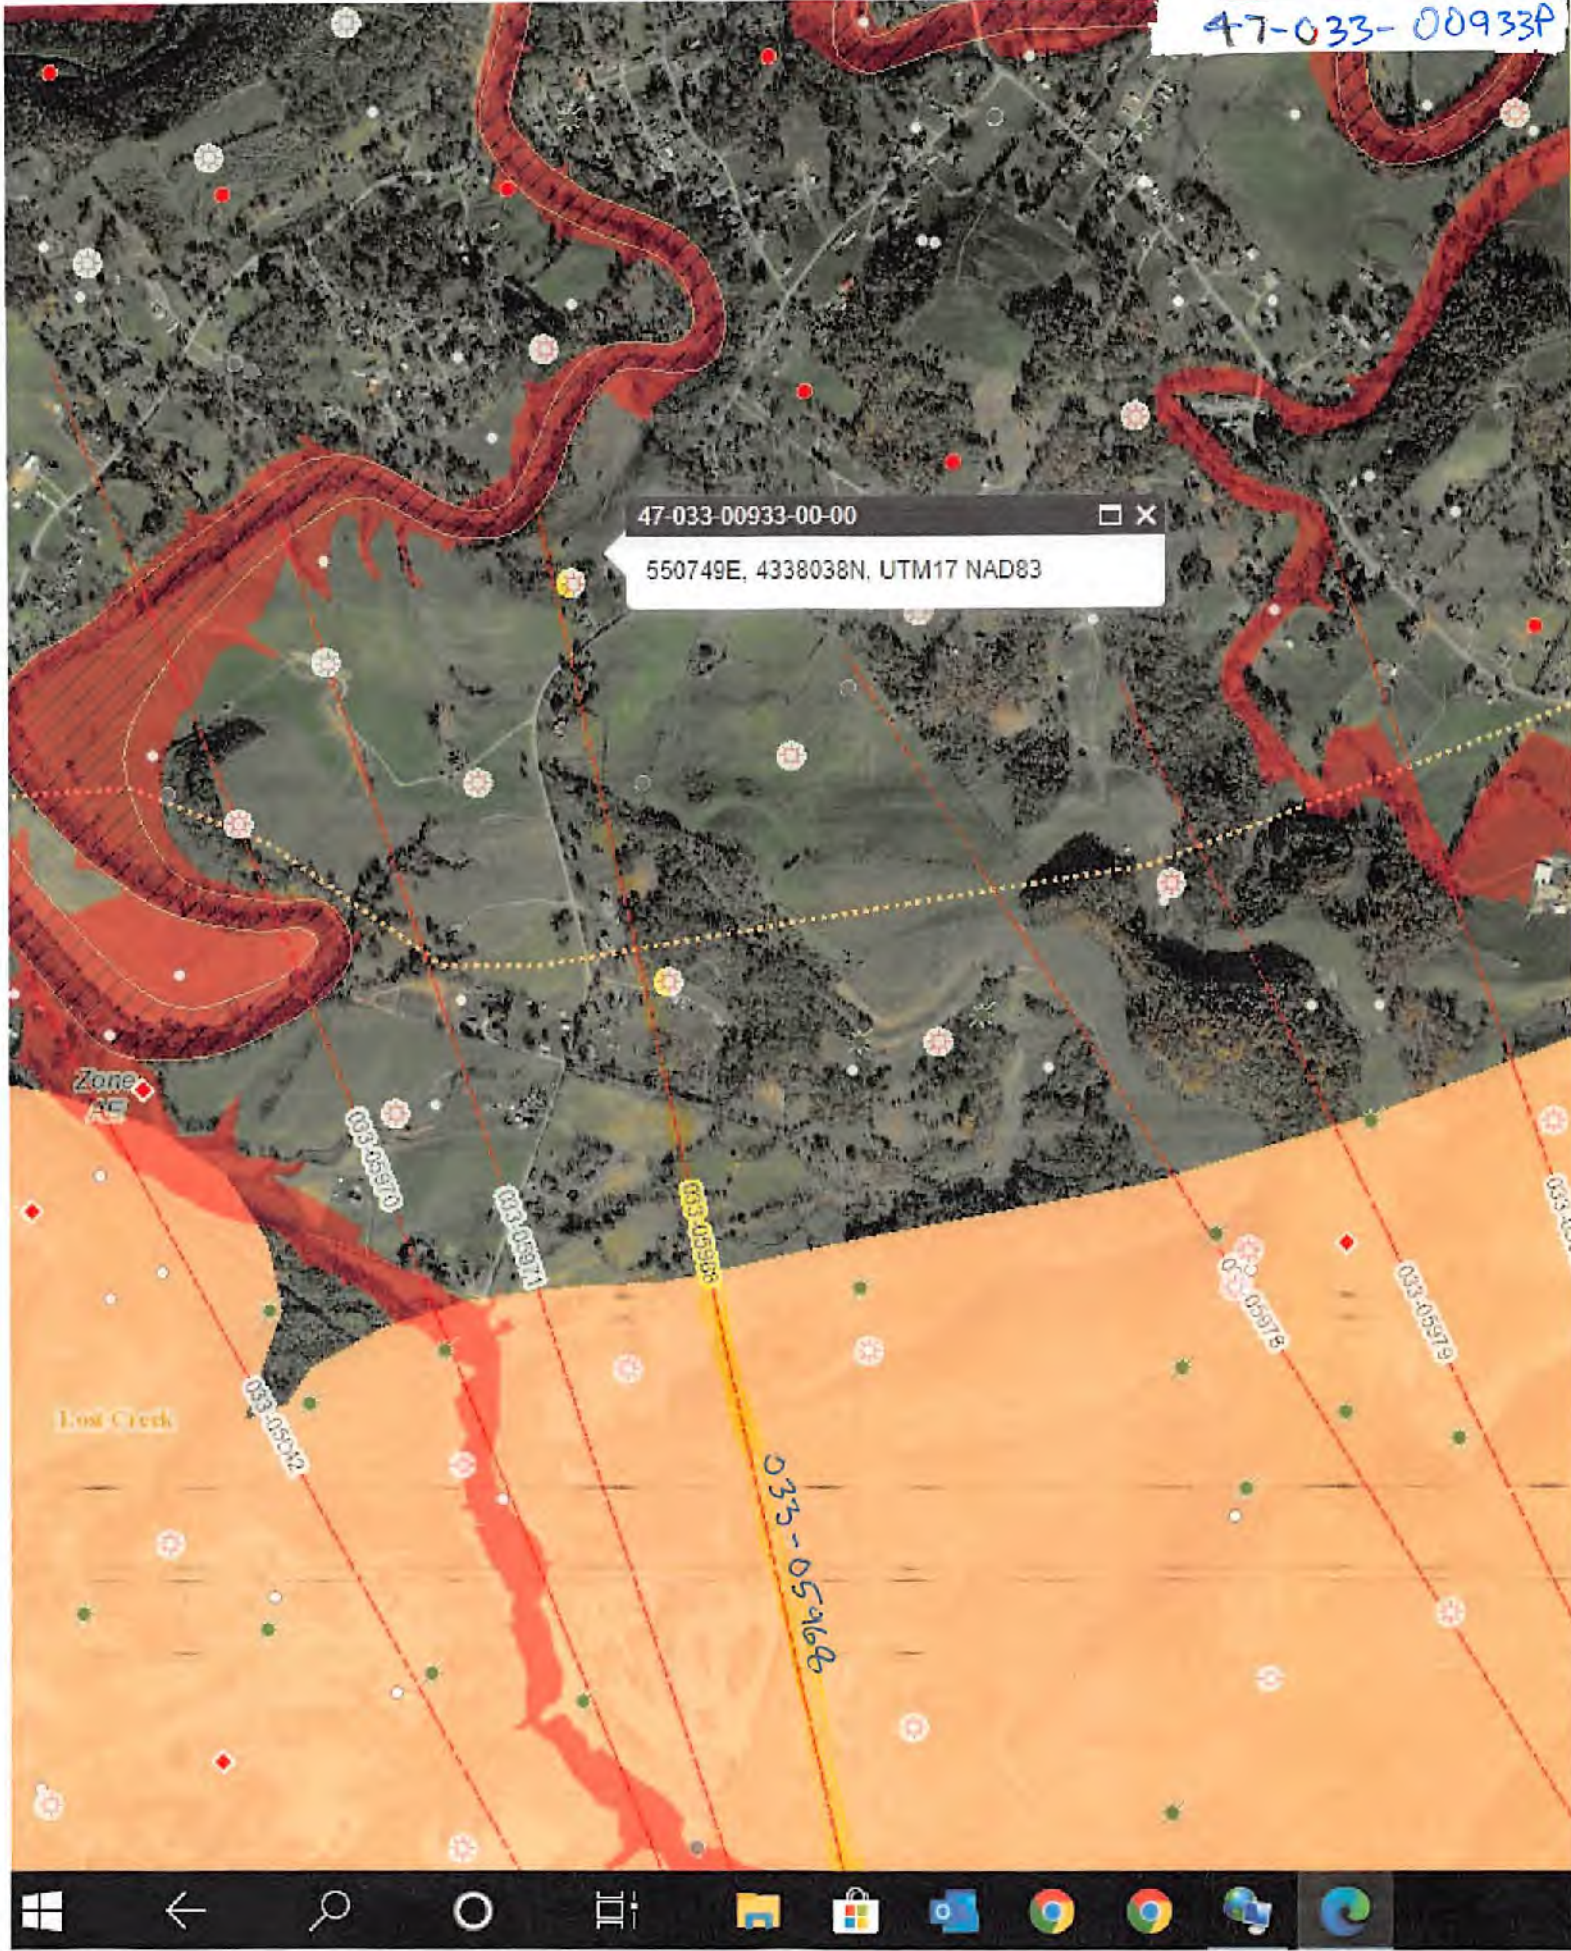

02/18/2022