

33 01729A

WW-7
5-02

West Virginia Department of Environmental Protection
Office of Oil & Gas

WELL LOCATION FORM: GPS

API: 47- 033 - 1729 WELL NO: No.8

FARM NAME: W.B. Carpenter

RESPONSIBLE PARTY NAME: HG Energy, LLC

COUNTY: Harrison DISTRICT: Tenmile

QUADRANGLE: Salem 7.5'

SURFACE OWNER: Earl & Belva Junkins

ROYALTY OWNER: HG Energy LLC et al.

UTM GPS NORTHING: 4,347,677

UTM GPS EASTING: 542,415 GPS ELEVATION: 398 m. 1308'


The Responsible Party named above has chosen to submit GPS coordinates in lieu of preparing a new well location plat for a plugging permit on the above well. The Office of Oil & Gas will not accept GPS coordinates that do not meet the following requirements:

- 1. Datum: NAD 1983, Zone:17 North, Coordinate Units: meters, Altitude: height above mean sea level (MSL) - meters.
- 2. Accuracy to Datum - 3.05 meters
- 3. Data Collection Method:

Survey Grade GPS Post Processed Differential
Real-Time Differential

Mapping Grade GPS Post Processed Differential
Real-Time Differential

I the undersigned, hereby certify this data is correct to the best of my knowledge and belief and shows all the information required by law and the regulations issued and prescribed by the Office of Oil and Gas.

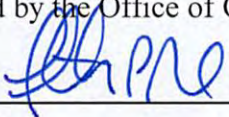
Signature Timothy P. Roush

Professional Surveyor
Title

July 3, 2013
Date


Received

JUL 18 2013

Office of Oil and Gas
WV Dept. of Environmental Protection

3301729

SUBJECT WELL
W.B. Carpenter No.8
47-033-1729

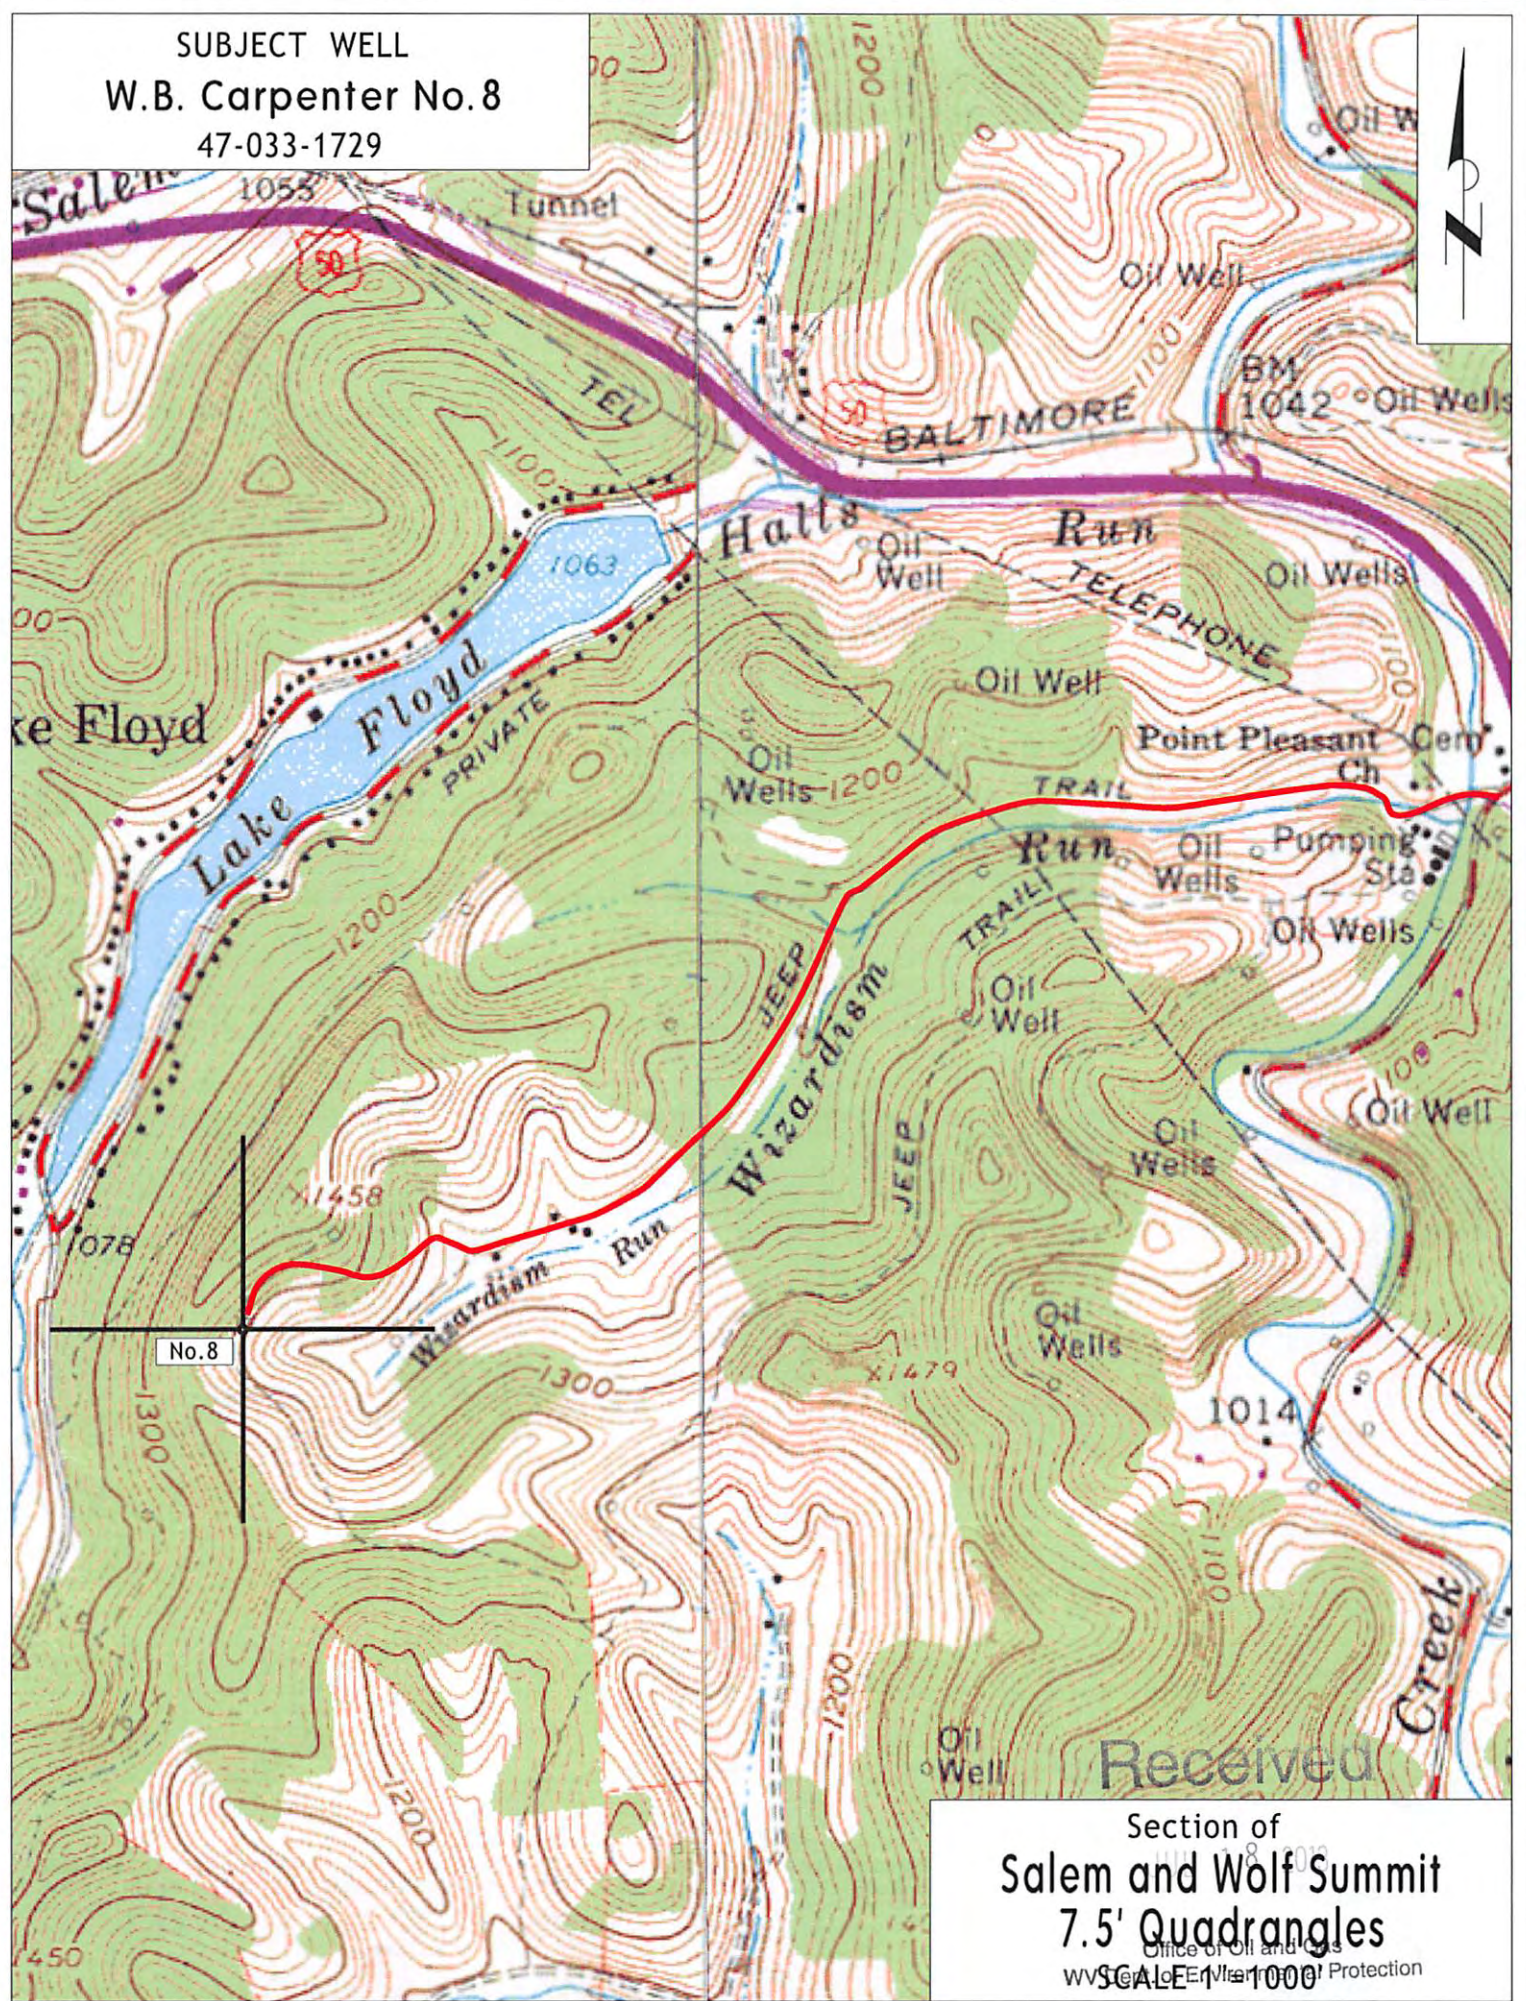

Section of
Salem and Wolf Summit
7.5' Quadrangles
Office of Oil and Gas
WV SCALE 1:1000
Department of Environmental Protection

Received