
Untitled KML file Saved on this device

4703302043 P

File Edit View Add Tools Help

Search Google Earth

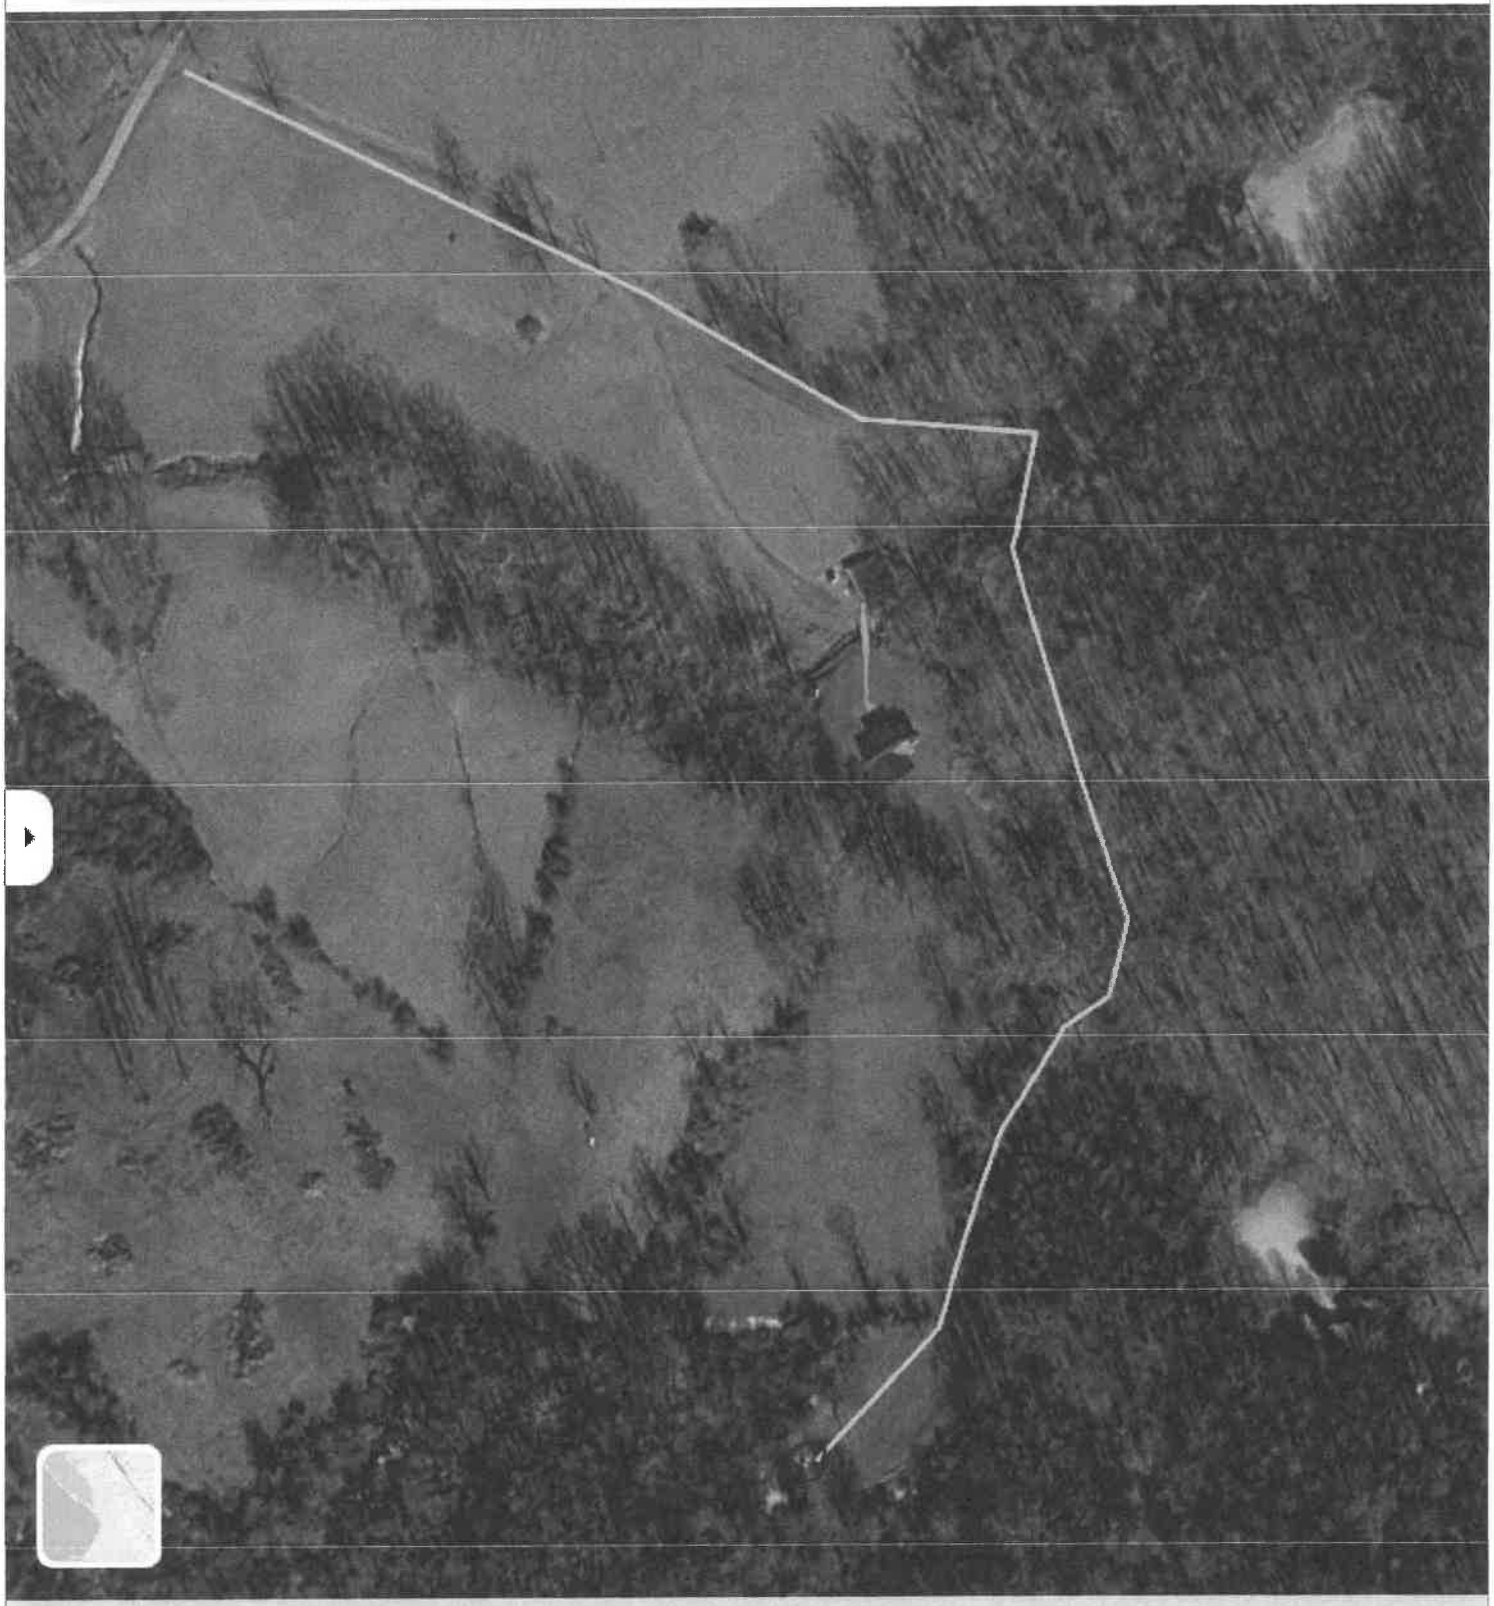

Google 100% Data attribution 2/17/2026

10/16/2026

4703302043P



RECEIVED
OCT 14 2026
WV Department of
Environmental Protection

2,000 1,000 0 2,000 Feet

N
W E
S

1:24,000 scale
From the Brownton USGS 7.5' Topographic Quadrangle

WVGES
West Virginia Geological and Economic Survey

10/16/2026

4703302043P

WW-7
8-30-06

West Virginia Department of Environmental Protection
Office of Oil and Gas
WELL LOCATION FORM: GPS

API: 47-0330-2043 **WELL NO.:** 1

FARM NAME: Lester Clevenger

RESPONSIBLE PARTY NAME: Charles W Clevenger Irrevocable Trust, Mary M Tucker, Trustee

COUNTY: Harrison **DISTRICT:** Simpson

QUADRANGLE: Brownton

SURFACE OWNER: Mary M Tucker, Douglas D Tucker, William L Clevenger, Candace V Clevenger

ROYALTY OWNER: Mary M Tucker, Douglas D Tucker, William L Clevenger, Candace V Clevenger

UTM GPS NORTHING: 4342441.7

UTM GPS EASTING: 567961.6 **GPS ELEVATION:** 1220'

The Responsible Party named above has chosen to submit GPS coordinates in lieu of preparing a new well location plat for a plugging permit or assigned API number on the above well. The Office of Oil and Gas will not accept GPS coordinates that do not meet the following requirements:

1. Datum: NAD 1983, Zone: 17 North, Coordinate Units: meters, Altitude: height above mean sea level (MSL) – meters.
2. Accuracy to Datum – 3.05 meters
3. Data Collection Method:

Survey grade GPS ____: Post Processed Differential _____

Real-Time Differential _____

Mapping Grade GPS ____: Post Processed Differential _____

Real-Time Differential _____

RECEIVED
Office of Oil and Gas
SEP 04 2026
WV Department of Environmental Protection

4. **Letter size copy of the topography map showing the well location.**

I the undersigned, hereby certify this data is correct to the best of my knowledge and belief and shows all the information required by law and the regulations issued and prescribed by the Office of Oil and Gas.

Mary M. Tucker — Signature

Trustee — Title

8/28/2026 — Date

10/16/2026