

UTM Coordinates (NAD83) Meters  
 N - 4,351,832  
 E - 547,590

CALL TABLE

A	S58° 55'E	558.24'	E	N38° 06'W	90.17'
B	N66° 07'E	2465.68'	F	N31° 00'W	82.92'
C	N35° 26'W	118.20'	G	N26° 47'W	58.60'
D	N34° 31'W	273.90'	H	N21° 39'W	99.00'

WELL TIES

- ① N46° 25'E 3934'
- ② N22° 32'E 4397'

**NOTES ON SURVEY**  
 1 - The survey shown hereon is from original drilling permit dated July 20, 1995.  
 2 - Plat has been updated to show as-drilled Latitude/Longitude information and current surface owner information.  
 3 - Latitude and Longitude established by DGPS (Sub-meter Mapping Grade).

(H) DENOTES LOCATION OF WELL ON UNITED STATES TOPOGRAPHIC MAPS

FILE NO. \_\_\_\_\_  
 MAP NO. N29 N 10 E 9 W  
 SCALE 1" = 1000'  
 MINIMUM DEGREE OF ACCURACY Sub-Meter DGPS  
 PROVEN SOURCE OF ELEVATION DGPS Survey

I THE UNDERSIGNED, HEREBY CERTIFY THAT THIS PLAT IS CORRECT TO THE BEST OF MY KNOWLEDGE AND BELIEF AND SHOWS ALL THE INFORMATION REQUIRED BY LAW AND THE REGULATIONS ISSUED AND PRESCRIBED BY THE DEPARTMENT OF MINES.

(SIGNED) [Signature]  
 TIMOTHY P. ROUSH PS 793



WEST VIRGINIA  
 Division of Environmental Protection  
 Office of Oil and Gas  
 601 57th Street  
 Charleston, West Virginia 25304



DATE October 22, 2014  
 FARM R.Q. Flowers No.3  
 API WELL NO. 47-033-04103 SW

WELL TYPE: OIL \_\_\_ GAS \_\_\_ LIQUID INJECTION X WASTE DISPOSAL \_\_\_ CORE \_\_\_  
 (IF "GAS") PRODUCTION \_\_\_ STORAGE \_\_\_ DEEP \_\_\_ SHALLOW \_\_\_  
 LOCATION: ELEVATION 1,527' WATERSHED Ten Mile Creek  
 DISTRICT Sardis COUNTY Harrison  
 QUADRANGLE Wolf Summit 7.5'

SURFACE OWNER Coastal Forest Resources Co. ACREAGE 56.5 Ac.  
 OIL & GAS ROYALTY OWNER HG Energy, LLC et al. LEASE ACREAGE 56.5 Ac.  
 LEASE NO. 99188-00

PROPOSED WORK: DRILL \_\_\_ CONVERT \_\_\_ DRILL DEEPER \_\_\_ REDRILL \_\_\_ FRACTURE OR STIMULATE X PLUG OFF OLD FORMATION \_\_\_ PERFORATE NEW FORMATION \_\_\_ OTHER PHYSICAL CHANGE IN WELL (SPECIFY) Well was drilled directionally S50°E 361' to BHL


RECEIVED  
 Office of Oil and Gas  
 FEB 06 2015  
 03/27/2015

PLUG AND ABANDON \_\_\_ CLEAN OUT AND REPLUG \_\_\_  
 TARGET FORMATION Fifth Sand ESTIMATED DEPTH 3,131' (MD)  
 WELL OPERATOR HG Energy LLC. DESIGNATED AGENT Diane White  
 ADDRESS 5260 DuPont Road ADDRESS 5260 DuPont Road  
Parkersburg, WV 26101 Parkersburg, WV 26101

WV Department of Environmental Protection



SUBJECT WELL  
**R.Q. Flowers No.3**  
47-033-04103

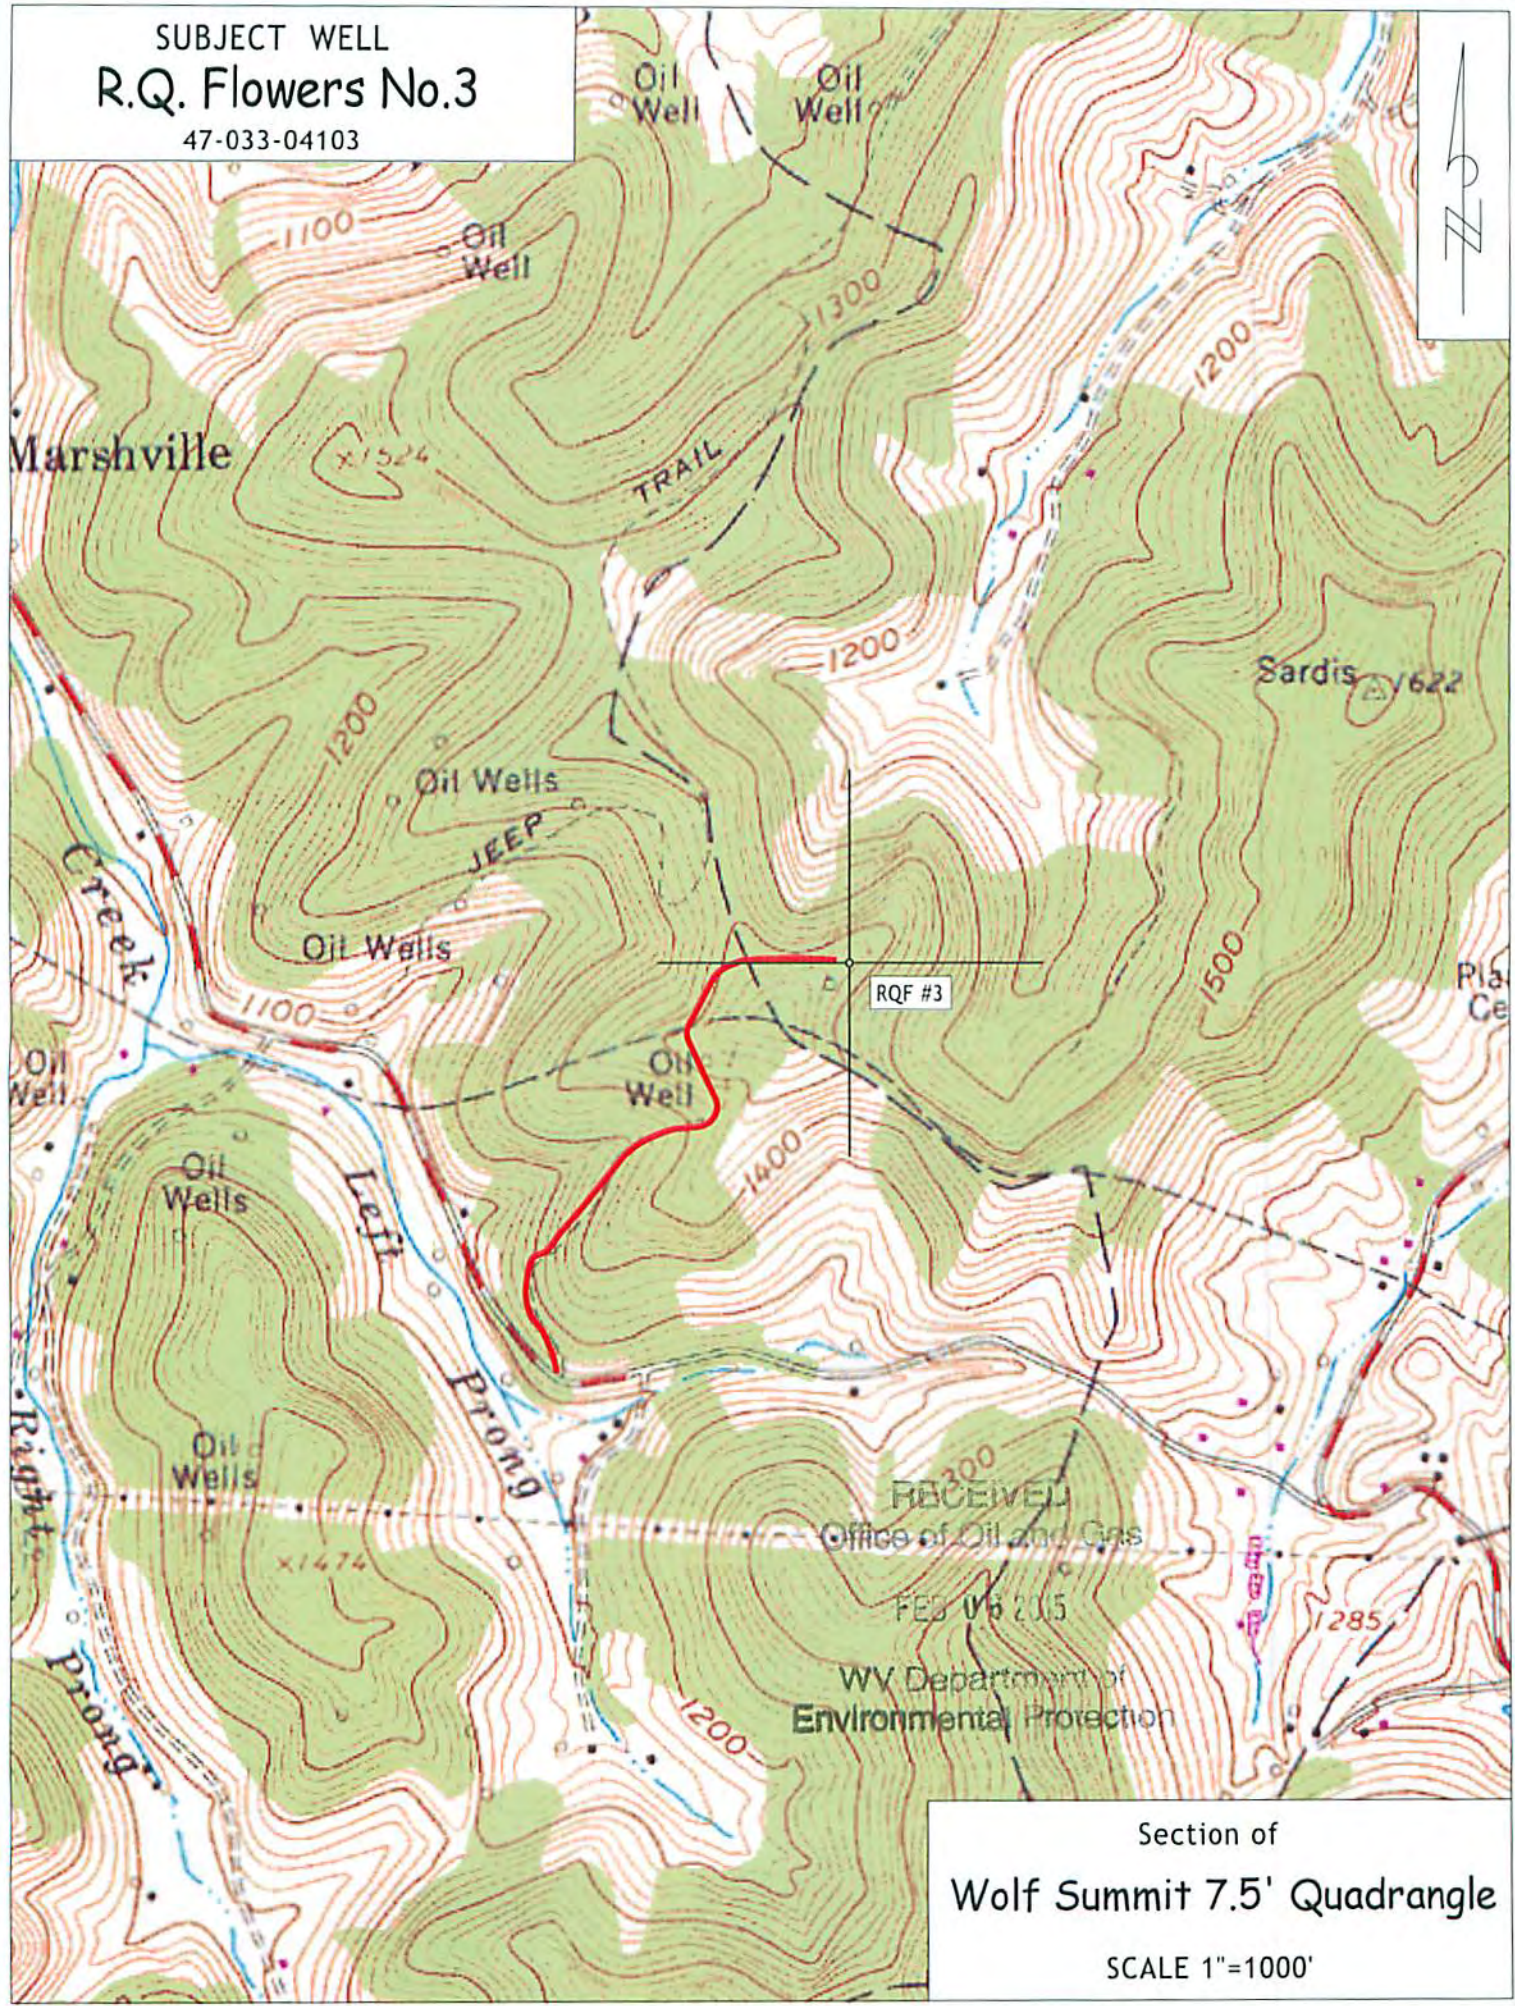

RQF #3

RECEIVED  
Office of Oil and Gas  
FEB 06 2015  
WV Department of  
Environmental Protection

Section of  
**Wolf Summit 7.5' Quadrangle**  
SCALE 1"=1000'