


47-033-04865



25'
4362
4361
4360
39°22'30"
80°22'30"

CLARKSBURG 16 (M)
LUMBERPORT 5 (M)

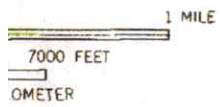

ROAD CLASSIFICATION

- Heavy-duty
- Medium-duty
- Light-duty
- Unimproved dirt

State Route

RECEIVED
Office of Oil and Gas

OCT 28 2024

WALLACE, W. VA.

NW/4 CLARKSBURG 15' QUADRANGLE
N 3922.5 - W 8022.5 / 7.5

11/22/2024

Well# 47-033-04865

WALLACE WV 7.5' Quad

Scale: 1" = 500'



× 1454

Cem

× 1471

Well# 47-033-04865

15

1300

1300

RECEIVED
Office of Oil and Gas

OCT 28 2024


WV Department of
Environmental Protection

4703304865

Well# 47-033-04865

WALLACE WV 7.5' Quad

Scale: 1" = 2000'

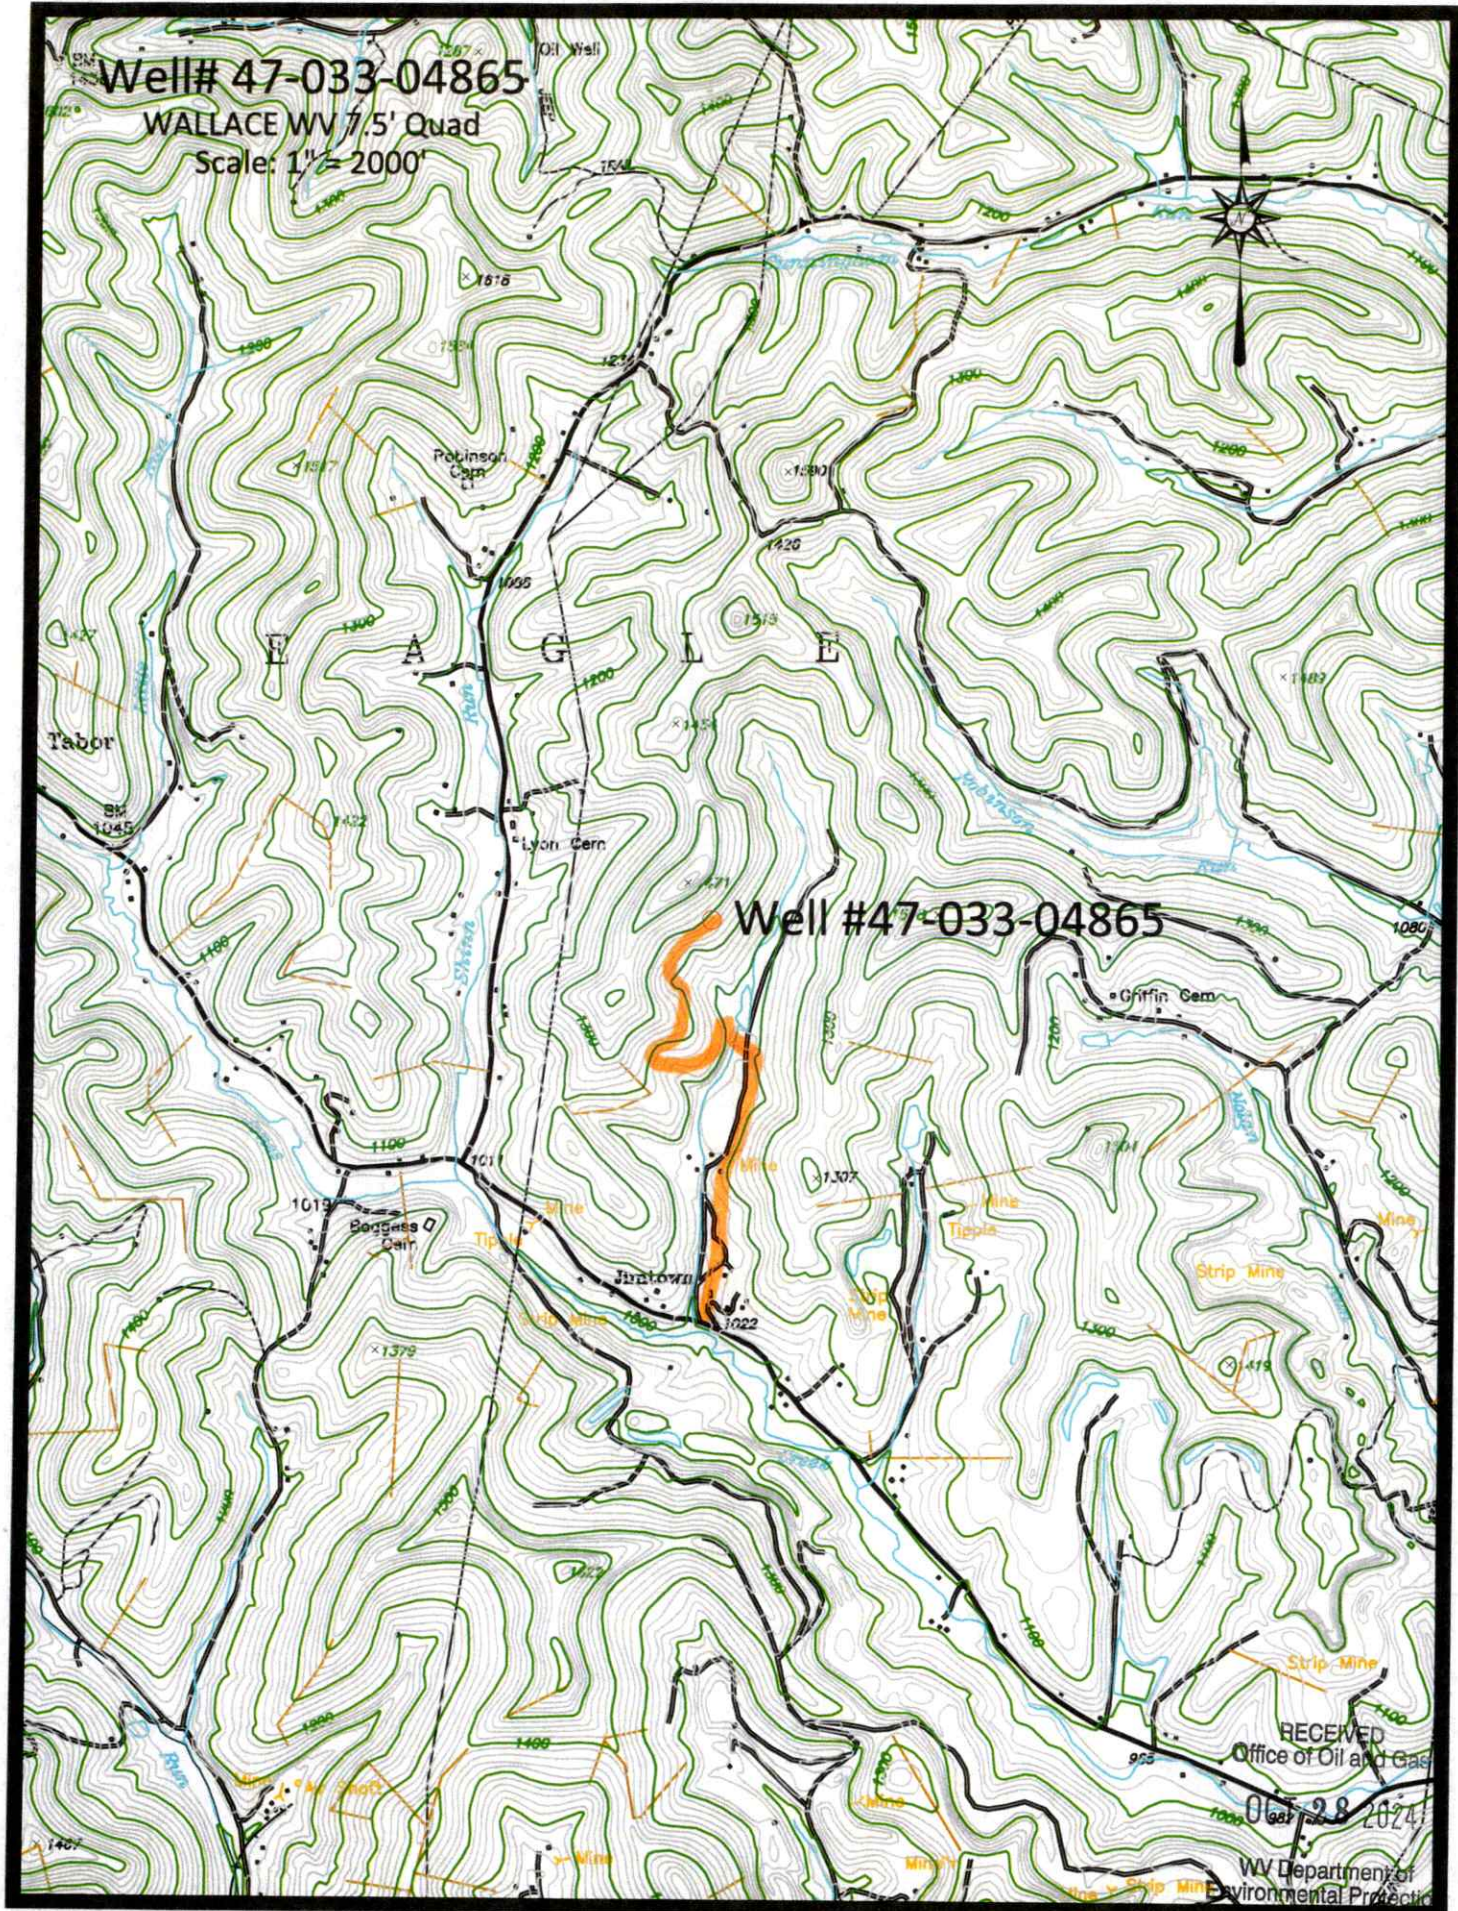

RECEIVED
Office of Oil and Gas
Oct 28 2024

WV Department of
Environmental Protection

11/22/2024

WW-7
8-30-06

4703304865



West Virginia Department of Environmental Protection
Office of Oil and Gas

WELL LOCATION FORM: GPS

API: 47-033-04865 WELL NO.: ROGERS 2104

FARM NAME: ROGERS

RESPONSIBLE PARTY NAME: WEST VIRGINIA LAND RESOURCES INC.

COUNTY: HARRISON DISTRICT: EAGLE

QUADRANGLE: WALLACE WV

SURFACE OWNER: HARRISON COUNTY COAL

ROYALTY OWNER: _____

UTM GPS NORTHING: 4,362,543 m

UTM GPS EASTING: 551,377 m GPS ELEVATION: 389 m

The Responsible Party named above has chosen to submit GPS coordinates in lieu of preparing a new well location plat for a plugging permit or assigned API number on the above well. The Office of Oil and Gas will not accept GPS coordinates that do not meet the following requirements:

1. Datum: NAD 1983, Zone: 17 North, Coordinate Units: meters, Altitude: height above mean sea level (MSL) – meters.
2. Accuracy to Datum – 3.05 meters
3. Data Collection Method:
Survey grade GPS : Post Processed Differential

Real-Time Differential _____

Mapping Grade GPS _____ : Post Processed Differential _____

Real-Time Differential _____

4. **Letter size copy of the topography map showing the well location.**

I the undersigned, hereby certify this data is correct to the best of my knowledge and belief and shows all the information required by law and the regulations issued and prescribed by the Office of Oil and Gas.

[Signature]
Signature

PS 2002
Title

OCTOBER 16, 2024
Date

RECEIVED
Office of Oil and Gas
OCT 28 2024
WV Department of
Environmental Protection

11/22/2024