

4703305689

WW-7  
8-30-06



West Virginia Department of Environmental Protection  
Office of Oil and Gas

WELL LOCATION FORM: GPS

API: 47-033-05689 WELL NO.: Carpenter 1H

FARM NAME: Washbourne

RESPONSIBLE PARTY NAME: Antero Resources Corporation

COUNTY: Harrison DISTRICT: Union

QUADRANGLE: Big Isaac & West Milford

SURFACE OWNER: Richard B. Washbourne

ROYALTY OWNER: \_\_\_\_\_

UTM GPS NORTHING: 4337314.03m

UTM GPS EASTING: 541723.40m GPS ELEVATION: 1289.9 ft

The Responsible Party named above has chosen to submit GPS coordinates in lieu of preparing a new well location plat for a plugging permit or assigned API number on the above well. The Office of Oil and Gas will not accept GPS coordinates that do not meet the following requirements:

1. Datum: NAD 1983, Zone: 17 North, Coordinate Units: meters, Altitude: height above mean sea level (MSL) – meters.
2. Accuracy to Datum – 3.05 meters
3. Data Collection Method:

Survey grade GPS  : Post Processed Differential \_\_\_\_\_

Real-Time Differential

Mapping Grade GPS  : Post Processed Differential \_\_\_\_\_

Real-Time Differential

4. Letter size copy of the topography map showing the well location.

I the undersigned, hereby certify this data is correct to the best of my knowledge and belief and shows all the information required by law and the regulations issued and prescribed by the Office of Oil and Gas.


MMW  
Signature

Reinhold Munnich  
Title

4/5/23  
Date

04/28/2023

4703305689

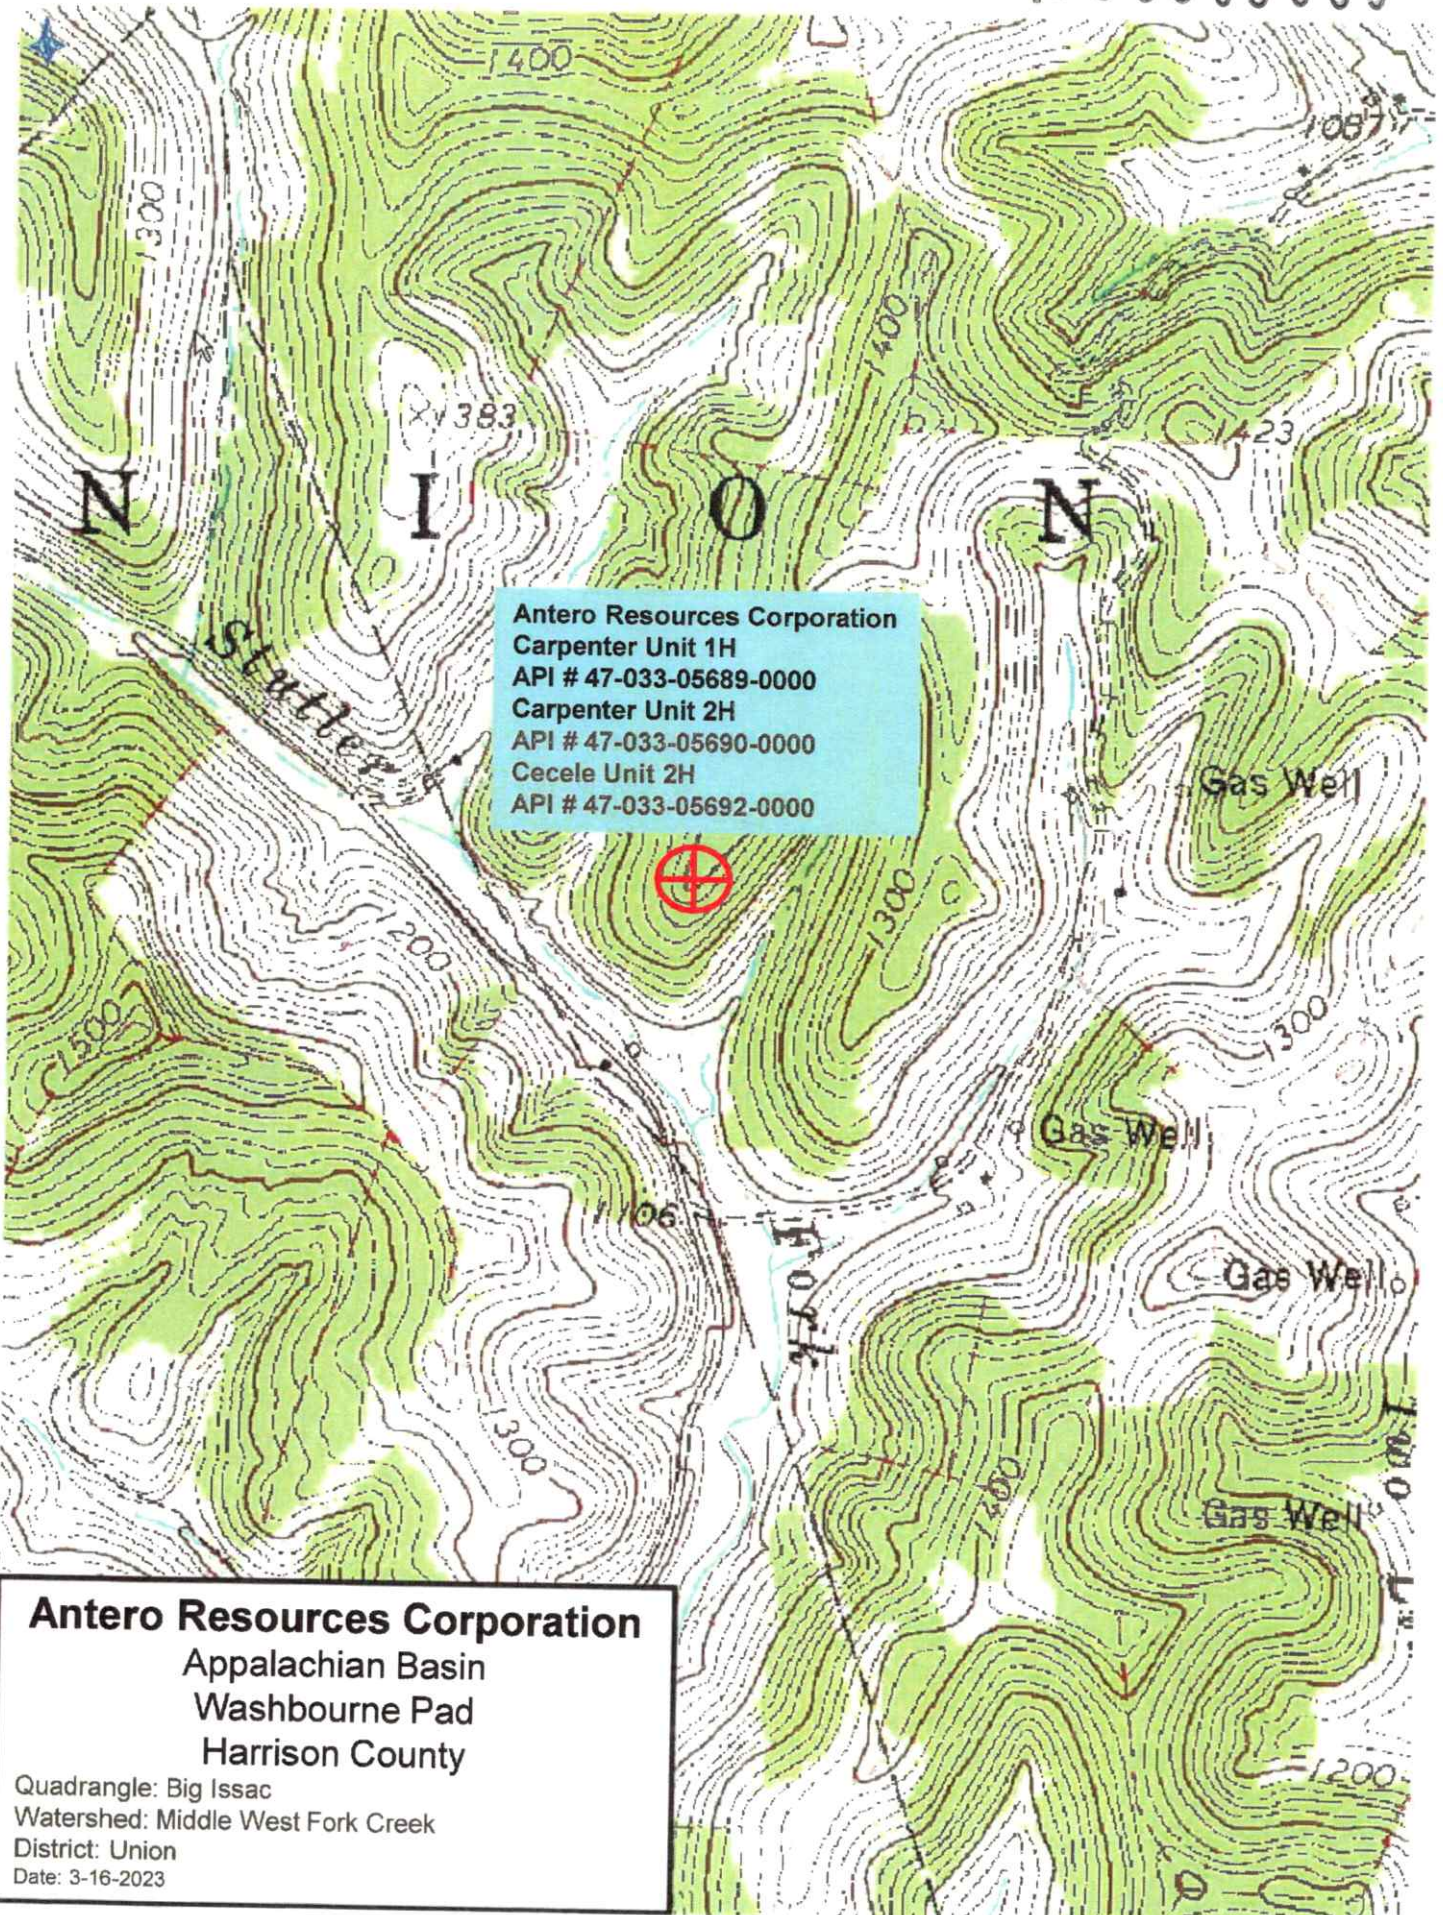

04/28/2023