

COUNTRY SOUTH WELL 4MH - AS-DRILLED			
ID	LEASE NUMBER	LESSOR	LEASE ACREAGE
A	BP049602	A B WILLIS & ET AL	33.00
B	BP053946	MELVILLE WATKINS & ET AL	108.00
C	BP035755	DELIA COLLINS ET AL	106.00
D	BP045972	E B CORE ET AL	51.00
E	BP037528	B T STROTHER ET AL	5.00
F	BP037529	B T STROTHER ET AL	112.00
G	BP024394	M O GOFF ET AL	620.00
H	BP002907	BELLE S PAYNE ET AL	800.00
I	BP045460	J C JOHNSON ET AL	292.00
J	BP066884	W.R. PATTON ET AL	37.25
K	BP045459	A T MCDONALD ET AL	118.00

COUNTRY SOUTH WELL 4MH - AS-DRILLED		
ID	SURFACE OWNER	DIST-TM-PAR
1	JAMES D. MILLER ET AL	5-230-45
2	DANAL "PETE" MCMILLION	5-230-44
3	JB ANGUS RANCH, LLC	5-230-49
4	JB ANGUS RANCH, LLC	3-13-12.5
5	JB ANGUS RANCH, LLC	5-250-12
6	CO-TRUSTEES OF THE H. WOOD THRASHER DESCENDANTS TRUST, DATED 1/1/2017	5-250-15
7	LINDA O. MORGAN	3-14-16
8	BEAU S. HANDLEY	15-270-60
9	BEAU S. HANDLEY	15-270-57
10	JON FALKENSTEIN ET AL	15-270-59
11	MARY V. MORGAN ET AL	15-270-61
12	SANDRA SUE BARTLETT ET AL	15-270-56
13	HECTOR A. & ILEANA MARTINEZ	15-270-58.1
14	ROBERT WATKINS	3-14-1.3
15	NORMA JEAN SWIGER	3-14-1.2
16	MARY V. MORGAN ET AL	15-270-22
17	MICHAEL E. & MARSHA L. SHEPHERD	15-270-48
18	MICHAEL E. & MARSHA L. SHEPHERD	3-14-2.31
19	ELIZABETH SNYDER	3-14-2.41
20	JOSEPH M. & DEBORAH TUCKER	3-14-2.14
21	JOSEPH M. & DEBORAH TUCKER	3-14-2.13
22	DAVID L. & BRENDA J. SMITH	3-14-2.27
23	JOSEPH MICHAEL & BETH A. ADAMS	3-14-2.45
24	JASON UNDERWOOD	3-14-4.3
25	JASON UNDERWOOD	3-14-4.2
26	CLAUDE J. RYAN III ET AL	3-14-4
27	JOSEPH R. GARRETT II ET AL	3-14-4.1
28	JOSEPH R. GARRETT II ET AL	3-14-5
29	JOSEPH R. GARRETT II ET AL	3-19-2
30	BRW DEVELOPMENT LLC	3-19-3

SEE PAGE 2 FOR PLAT DUE TO LENGTH OF LATERAL

# THRASHER

THE THRASHER GROUP, INC.  
600 WHITE OAKS BLVD.  
BRIDGEPORT, WV 26330  
PHONE 304-624-4108


## AS-DRILLED PLAT



Diversified  
Production LLC

FILE #: T70-11330 COUNTRY WELL PAD  
DRAWING #: COUNTRY 4MH AS-DRILLED  
SCALE: 1" = 2,000'  
DATE: JUNE 17, 2025

I, THE UNDERSIGNED, HEREBY CERTIFY THAT THIS PLAT IS CORRECT TO THE BEST OF MY KNOWLEDGE AND BELIEF AND SHOWS ALL THE INFORMATION REQUIRED BY LAW AND THE REGULATIONS ISSUED AND PRESCRIBED BY THE DEPARTMENT OF ENVIRONMENTAL PROTECTION.

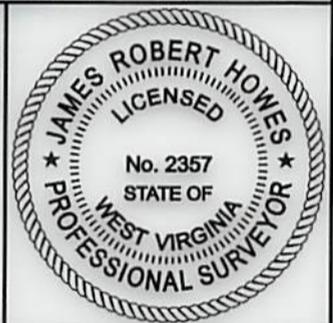

MINIMUM DEGREE OF ACCURACY: 1/2500  
PROVEN SOURCE SURVEY GRADE GPS OF ELEVATION: (NAVD 88, US FT)

SIGNED: *James R Howes*  
R.P.E.: \_\_\_\_\_ L.L.S.: P.S. No. 2357



(+) DENOTES LOCATION OF WELL ON UNITED STATES TOPOGRAPHIC MAPS  
WVDEP  
OFFICE OF OIL & GAS 601  
57TH STREET  
CHARLESTON, WV 25304

OPERATOR'S WELL #: COUNTRY 4MH AS-DRILLED

API WELL #: 47 33 06025  
STATE COUNTY PERMIT

WELL TYPE: OIL  WASTE DISPOSAL  PRODUCTION  DEEP  GAS  LIQUID INJECTION  STORAGE  SHALLOW   
WATERSHED: THOMAS FORK TO BOOTH'S CREEK ELEVATION: 1,134.30'±  
COUNTY/DISTRICT: HARRISON / CLAY-OUTSIDE QUADRANGLE: ROSEMONT, WV 7.5'  
SURFACE OWNER: JAMES D. MILLER ET AL ACREAGE: 24.14±  
OIL & GAS ROYALTY OWNER: A B WILLIS & ET AL ACREAGE: 33.00± **02/06/2026**  
DRILL  DRILL DEEPER  REDRILL  FRACTURE OR STIMULATE  PLUG OFF OLD FORMATION   
CONVERT  PLUG & ABANDON  CLEAN OUT & REPLUG  PERFORATE NEW FORMATION   
OTHER CHANGE  (SPECIFY): \_\_\_\_\_  
TARGET FORMATION: MARCELLUS ESTIMATED DEPTH: (LATERAL)TVD: 7,438'± TMD: 23,979'±

WELL OPERATOR: DIVERSIFIED PRODUCTION, LLC  
ADDRESS: 101 MCQUISTON DRIVE  
CITY: JACKSON CENTER STATE: PA ZIP CODE: 16133

DESIGNATED AGENT: CHRIS VEASEY  
ADDRESS: 400 SUMMER STREET  
CITY: CHARLESTON STATE: WV ZIP CODE: 25301

BHL is located on topo map 8,447 feet south of Latitude: 39° 20' 00"  
 SHL is located on topo map 7,865 feet south of Latitude: 39° 22' 30"

# COUNTRY 4MH

## PAGE 2 OF 2

WELL PAD  
ORIENTATION  
DETAIL  
NTS



**WELL RESTRICTIONS**

1. OCCUPIED DWELLING WITHIN 625 FEET OF CENTER OF PAD.
2. NO AGRICULTURE BUILDINGS > 2500 SQ FT. WITHIN 625 FEET OF CENTER OF PAD.
3. NO WATER WELLS OR DEVELOPED SPRINGS ARE WITHIN 250 FEET OF PROPOSED WELL.
4. NO NATURALLY PRODUCING TROUT STREAM WITHIN 300 FEET OF LIMITS OF DISTURBANCE.
5. NO GROUND INTAKE OR PUBLIC WATER SUPPLY WITHIN 1000 FEET OF WELL PAD, LIMITS OF DISTURBANCE, E & S CONTROLS.

**NOTES ON SURVEY**


1. SURFACE AND ROYALTY OWNER INFORMATION AND THEIR BOUNDARIES SHOWN HEREON WERE PLOTTED FROM DEEDS AND/OR TAX PARCEL MAPS PROVIDED BY CLIENT AND/OR FIELD LOCATIONS.
2. THIS PLAT DOES NOT REPRESENT A BOUNDARY SURVEY OF THE PARCELS SHOWN HEREON.
3. ALL INSETS ARE GRID NORTH UNLESS OTHERWISE DEPICTED.

LINE	BEARING	DISTANCE
L1	N 63°21'37" W	1087.78'
L2	N 45°28'56" W	1117.67'
L3	N 26°51'58" W	660.42'

SURFACE HOLE LOCATION (SHL) AS-DRILLED	
UTM 17-NAD83 (M):	NAD83, WV NORTH (FT)
NORTHING: 4356293.632	NORTHING: 311635.979
EASTING: 567932.304	EASTING: 1767292.863
LANDING POINT LOCATION (LPL) AS-DRILLED	
UTM 17-NAD83 (M):	NAD83, WV NORTH (FT)
NORTHING: 4356071.524	NORTHING: 310917.490
EASTING: 567743.291	EASTING: 1766660.510
TURNING POINT 1 (TP1) AS-DRILLED	
UTM 17-NAD83 (M):	NAD83, WV NORTH (FT)
NORTHING: 4353690.142	NORTHING: 303055.220
EASTING: 568624.328	EASTING: 1769421.430
TURNING POINT 2 (TP2) AS-DRILLED	
UTM 17-NAD83 (M):	NAD83, WV NORTH (FT)
NORTHING: 4353614.867	NORTHING: 302806.450
EASTING: 568556.669	EASTING: 1769523.440
TURNING POINT 3 (TP3) AS-DRILLED	
UTM 17-NAD83 (M):	NAD83, WV NORTH (FT)
NORTHING: 4353441.714	NORTHING: 302233.830
EASTING: 568738.034	EASTING: 1769780.970
TURNING POINT 4 (TP4) AS-DRILLED	
UTM 17-NAD83 (M):	NAD83, WV NORTH (FT)
NORTHING: 4353208.874	NORTHING: 301465.600
EASTING: 568814.994	EASTING: 1770020.790
TURNING POINT 5 (TP5) AS-DRILLED	
UTM 17-NAD83 (M):	NAD83, WV NORTH (FT)
NORTHING: 4353077.678	NORTHING: 301033.000
EASTING: 568853.401	EASTING: 1770139.650
BOTTOM HOLE LOCATION (BHL) AS-DRILLED	
UTM 17-NAD83 (M):	NAD83, WV NORTH (FT)
NORTHING: 4351505.226	NORTHING: 295842.53
EASTING: 568415.672	EASTING: 1771898.800

**AS-DRILLED  
PLAT**


02/06/2026

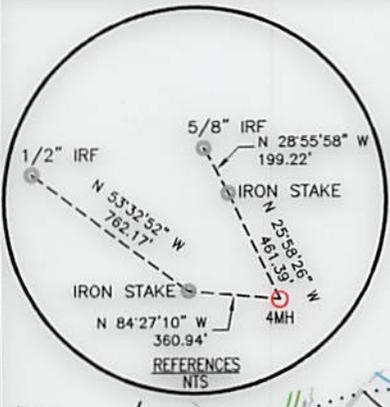

GRID NORTH  
WV STATE PLANE  
NORTH ZONE NAD83 (2011)

**LEGEND**

- TOPO MAP POINT
- SURFACE HOLE / BOTTOM HOLE
- LANDING POINT
- TURNING POINT
- EXISTING GAS WELLS
- PERMITTED GAS WELLS
- PLUGGED GAS WELLS
- ABANDONED GAS WELLS
- REFERENCE POINT
- LEASE BOUNDARY
- SURVEYED PARCEL
- ADJONER PARCEL
- LESSORS
- SURFACE OWNERS
- AS-DRILLED WELL PATH
- ROAD CENTER LINE
- STREAM CENTER LINE

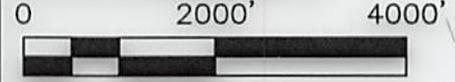

**THRASHER**  
 THE THRASHER GROUP, INC.  
 600 WHITE OAKS BLVD.  
 BRIDGEPORT, WV 26330  
 PHONE 304-624-4108



BHL is located on topo map 7,970 feet west of Longitude: 80° 10' 00"  
 SHL is located on topo map 911 feet west of Longitude: 80° 12' 30"