


1951 #3 - Sandover - Mex

HUC: 30124

NOT COUNTED

S. J. Davis #2

 










