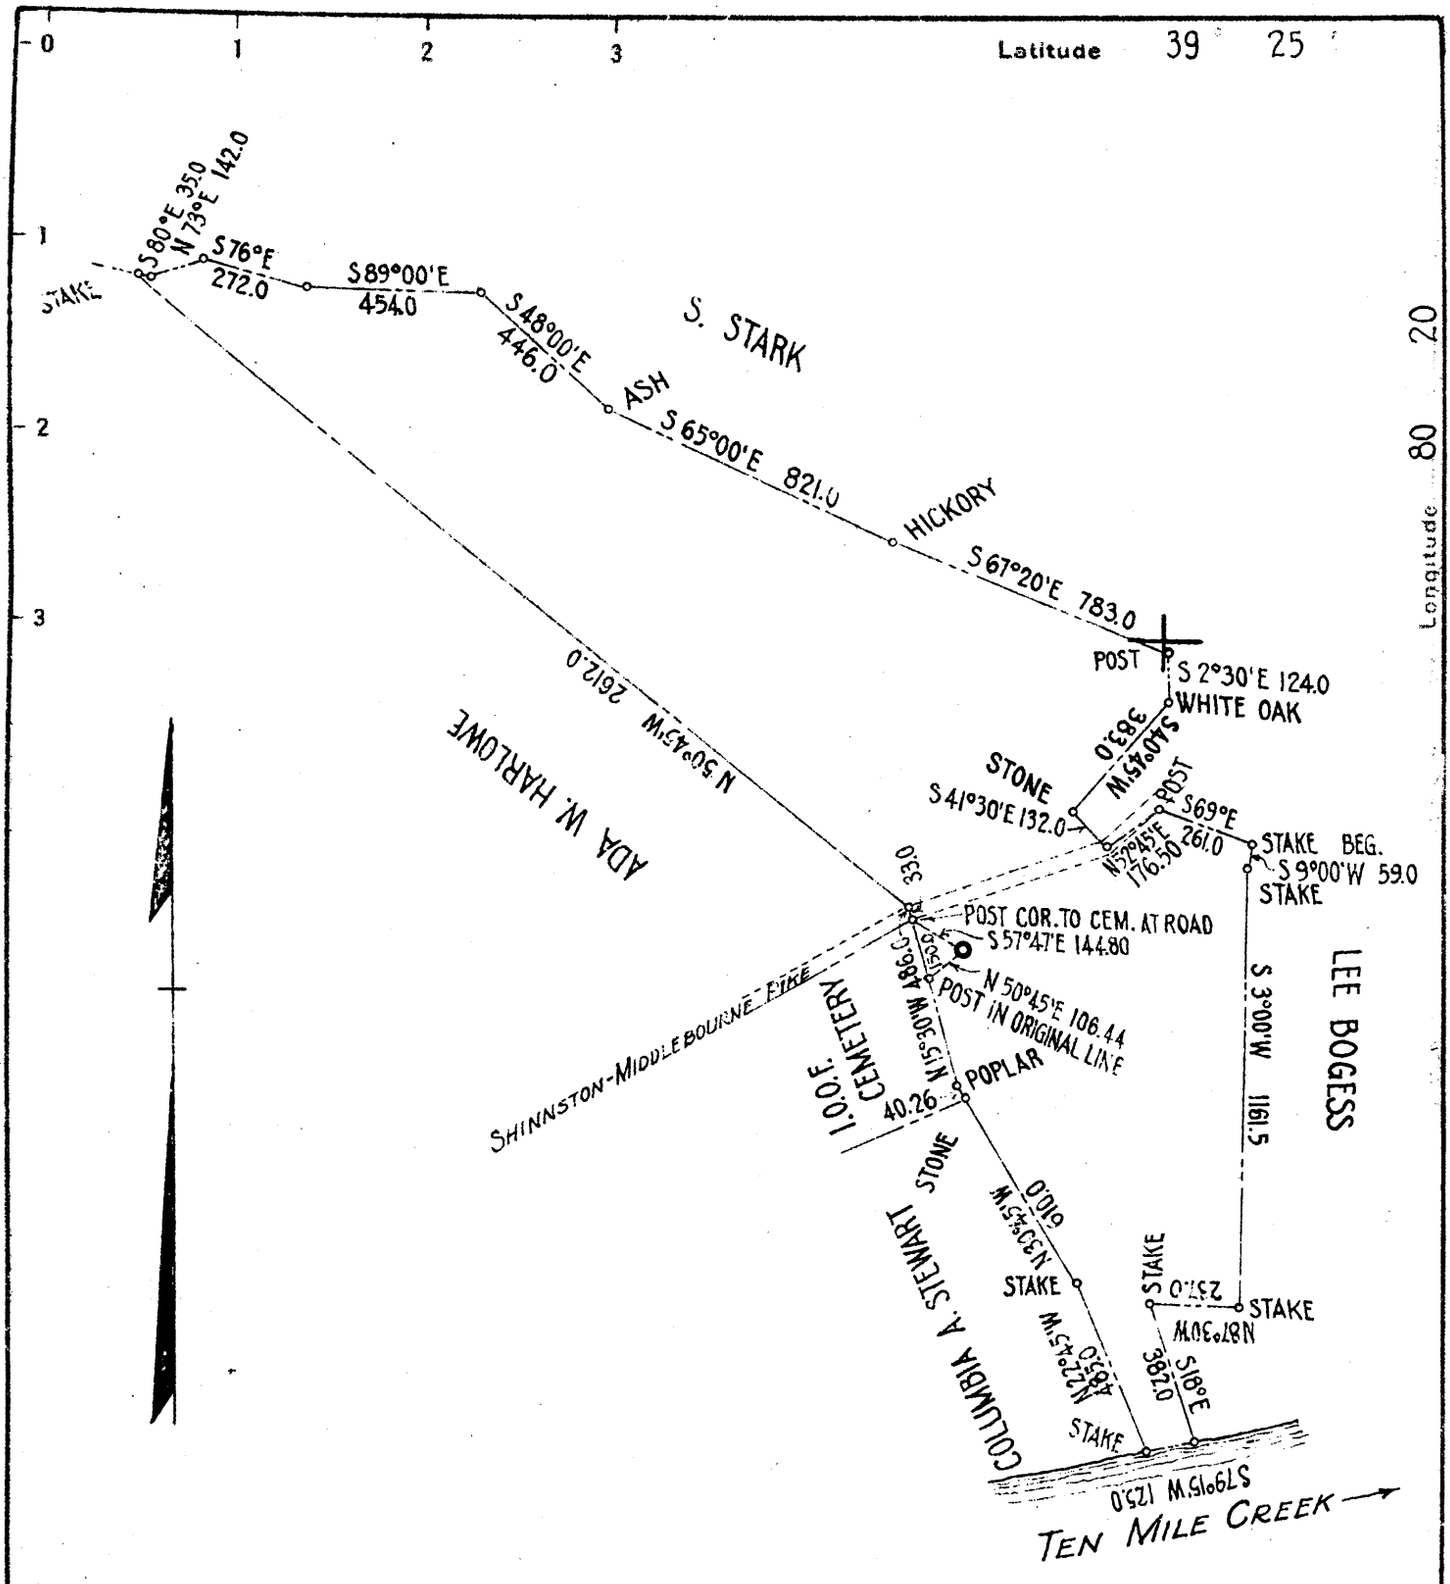

3.24S
1.46W

W - 1.5
S 3.29

New Location
Drill Deeper
Abandonment X

Company EAGLE GAS CO. 0255
Address LUMBERPORT W.VA.
Farm E.T. FORTNEY HRS.
Tract ____ Acres 59.24 Lease No. ____
Well (Farm) No. 1 Serial No. ____
Elevation (Spirit Level) 1051.02
Quadrangle CLARKSBURG C
County HARRISON District EAGLE
Engineer HORNOR BROS. ENGRS. BY Jane Allen Hornor
Engineer's Registration No. 602
File No. ____ Drawing No. ____
Date 12-9-1939 Scale 1" = 500'

STATE OF WEST VIRGINIA
DEPARTMENT OF MINES
OIL AND GAS DIVISION
CHARLESTON

WELL LOCATION MAP

FILE NO. HAR-548A

+ Denotes location of well on United States Topographic Maps, scale 1 to 62,500, latitude and longitude lines being represented by border lines as shown.

— Denotes one inch spaces on border line of original tracing.