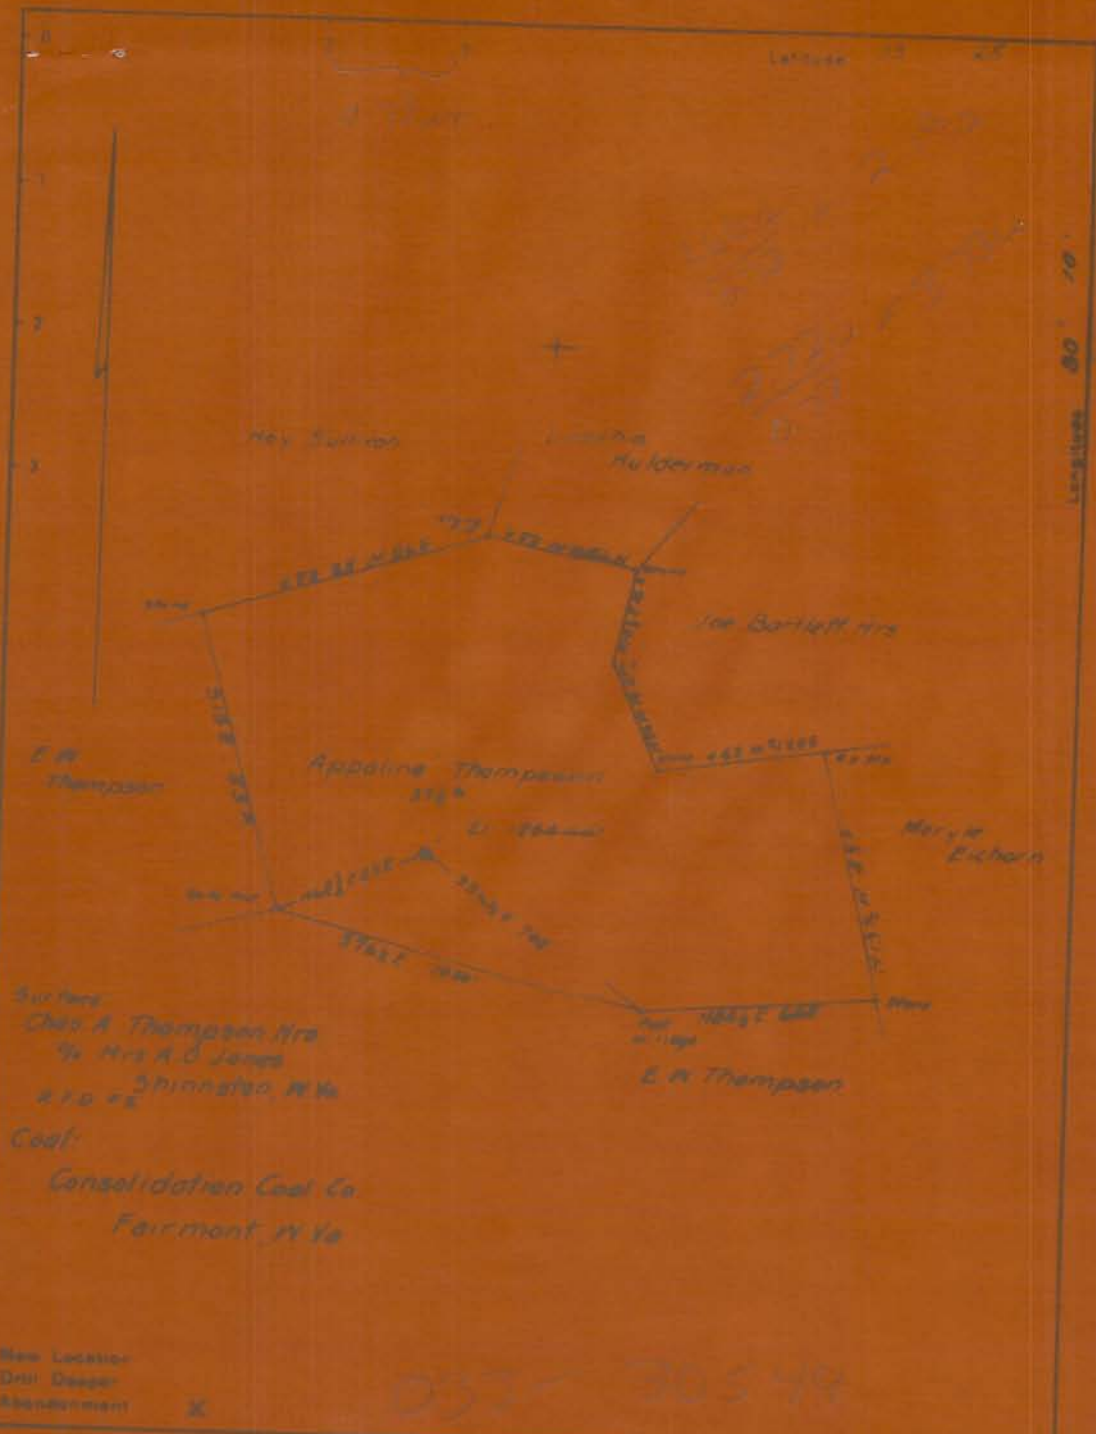
Latitude
Longitude
Hoy Sutton
Hulderman
Joe Bartlett Hrs
E W Thompson
Appaline Thompson
Meryle Eichorn
E W Thompson
Surface
Chas A Thompson Hrs
% Mrs A O Jones
Shinnston W Va
Coal
Consolidation Coal Co
Fairmont W Va
New Location
Drill Deeper
Abandonment
Company South Penn Oil Co
Address 411 7th Ave Pittsburgh, Pa
Farm Appaline Thompson
STATE OF WEST VIRGINIA
DEPARTMENT OF MINES
OIL AND GAS DIVISION

STATE OF WEST VIRGINIA

DEPARTMENT OF MINES

OIL AND GAS DIVISION

WELL RECORD

Permit No. [illegible]

Oil or Gas Well (Kind) OIL

Company South Penn Oil Company

Address 411 Seventh Ave., Pittsburgh, Pa.

Farm Pipeline Thompson [illegible]

Location (Waters)

Well No. 1 Elev. [illegible]

District Clay County Harrison

The surface of tract is owned in fee by Chas. [illegible] Thompson Mrs. [illegible]

c/o Mrs. [illegible] Address [illegible]

Mineral rights are owned by [illegible] Oil Co. [illegible]

[illegible]

Drilling commenced [illegible]

Drilling completed [illegible]

Date shot [illegible]

Open flow [illegible]

Casing and Tubing	Used in Drilling	Left in Well	Packers
			Kind of Packer
	[illegible]		Size of
	[illegible]		Depth set
			Perf. top
			Perf. bottom
			Perf. top
			Perf. bottom

Volume										
Rock Pressure										
Oil	[illegible]									
Fresh Water										
Salt Water	[illegible]									

Casing	Cemented	Size	No. Ft.	Date
[illegible]	[illegible]	[illegible]	[illegible]	[illegible]
[illegible]	[illegible]	[illegible]	[illegible]	[illegible]
[illegible]	[illegible]	[illegible]	[illegible]	[illegible]

Formation	Color	Hard or Soft	Top	Bottom	Oil, Gas or Water	Depth Found	Remarks
Pittsburgh Sand			[illegible]	[illegible]			
Big Dunkard Sand			[illegible]	[illegible]			
Second Salt Sand			[illegible]	[illegible]			
					[illegible]	[illegible]	
Pocono Sand			[illegible]	[illegible]			
Little Lime			[illegible]	[illegible]			
Pencil Cave			[illegible]	[illegible]			
Big Lime				[illegible]			
Big Injun Sand			[illegible]	[illegible]			
Squaw Sand			[illegible]	[illegible]			
Fifty Foot Sand			[illegible]	[illegible]			
					[illegible]		
					[illegible]		
					[illegible]		
Total Depth				[illegible]			

033-30549

DEPARTMENT OF MINES

OIL AND GAS DIVISION

AFFIDAVIT OF PLUGGING AND FILLING WELL

AFFIDAVIT SHOULD BE MADE IN THIS [illegible] TO [illegible] PROPRIETARY [illegible] SHOULD BE [illegible] OPERATOR AT THEIR RESPECTIVE [illegible]

Consolidation Coal Co.

[illegible]

c/o C.M.Shipe, Jr.,Eng'r.
Fairmont, W.Va.

[illegible]

[illegible]

Chas. A.Thompson Heirs

[illegible]

[illegible] Shinnston, W.Va.

[illegible]

STATE INSPECTOR SUPERVISING PLUGGING

SOUTH PENN NATURAL GAS COMPANY

[illegible]

Union Trust Building,
Parkersburg, W.Va.

[illegible]

January 19, 1942

WELL AND LOCATION

Clay (Dist.)

Harrison (Count)

Well No. 1

Appaline Thompson Farm

None.

AFFIDAVIT

STATE OF WEST VIRGINIA

County of Harrison

Birdy Mitchell and Harvey Goodwin

[illegible] South Penn Natural Gas Co. [illegible]

11th day of April, 1941 [illegible]

BAND OR ZONE RECORD	FILLING MATERIAL			PLUGS USED	CASING	
Fifty Foot	Clay	2245	11.5	6-5/8" wood		
	Cement	413	212			
Permanent Bridge at		1722				
Big Injun Sand	Clay	1810	1635	6-5/8" wood		
	Cement	1637	1622			
Permanent Bridge at		1260				
Maxon-Salt Sands	Clay	1260	880	6-5/8" wood	970'	6-5/8" 624'
	Cement	877	667			
Permanent bridge at		758				
Big Dunkard	Clay	758	670	6-5/8" wood		
	Cement	667	657			
	Clay	657	315			

Hole caved to 970', and 10" casing sawed to 2" extending 8' above ground.

[illegible]

DESCRIPTION OF MONUMENT

Cement 30"X30"X10"-cement post on center, 3' feet high.

Inscription: [illegible]
Apr. 1, 1941

[illegible]