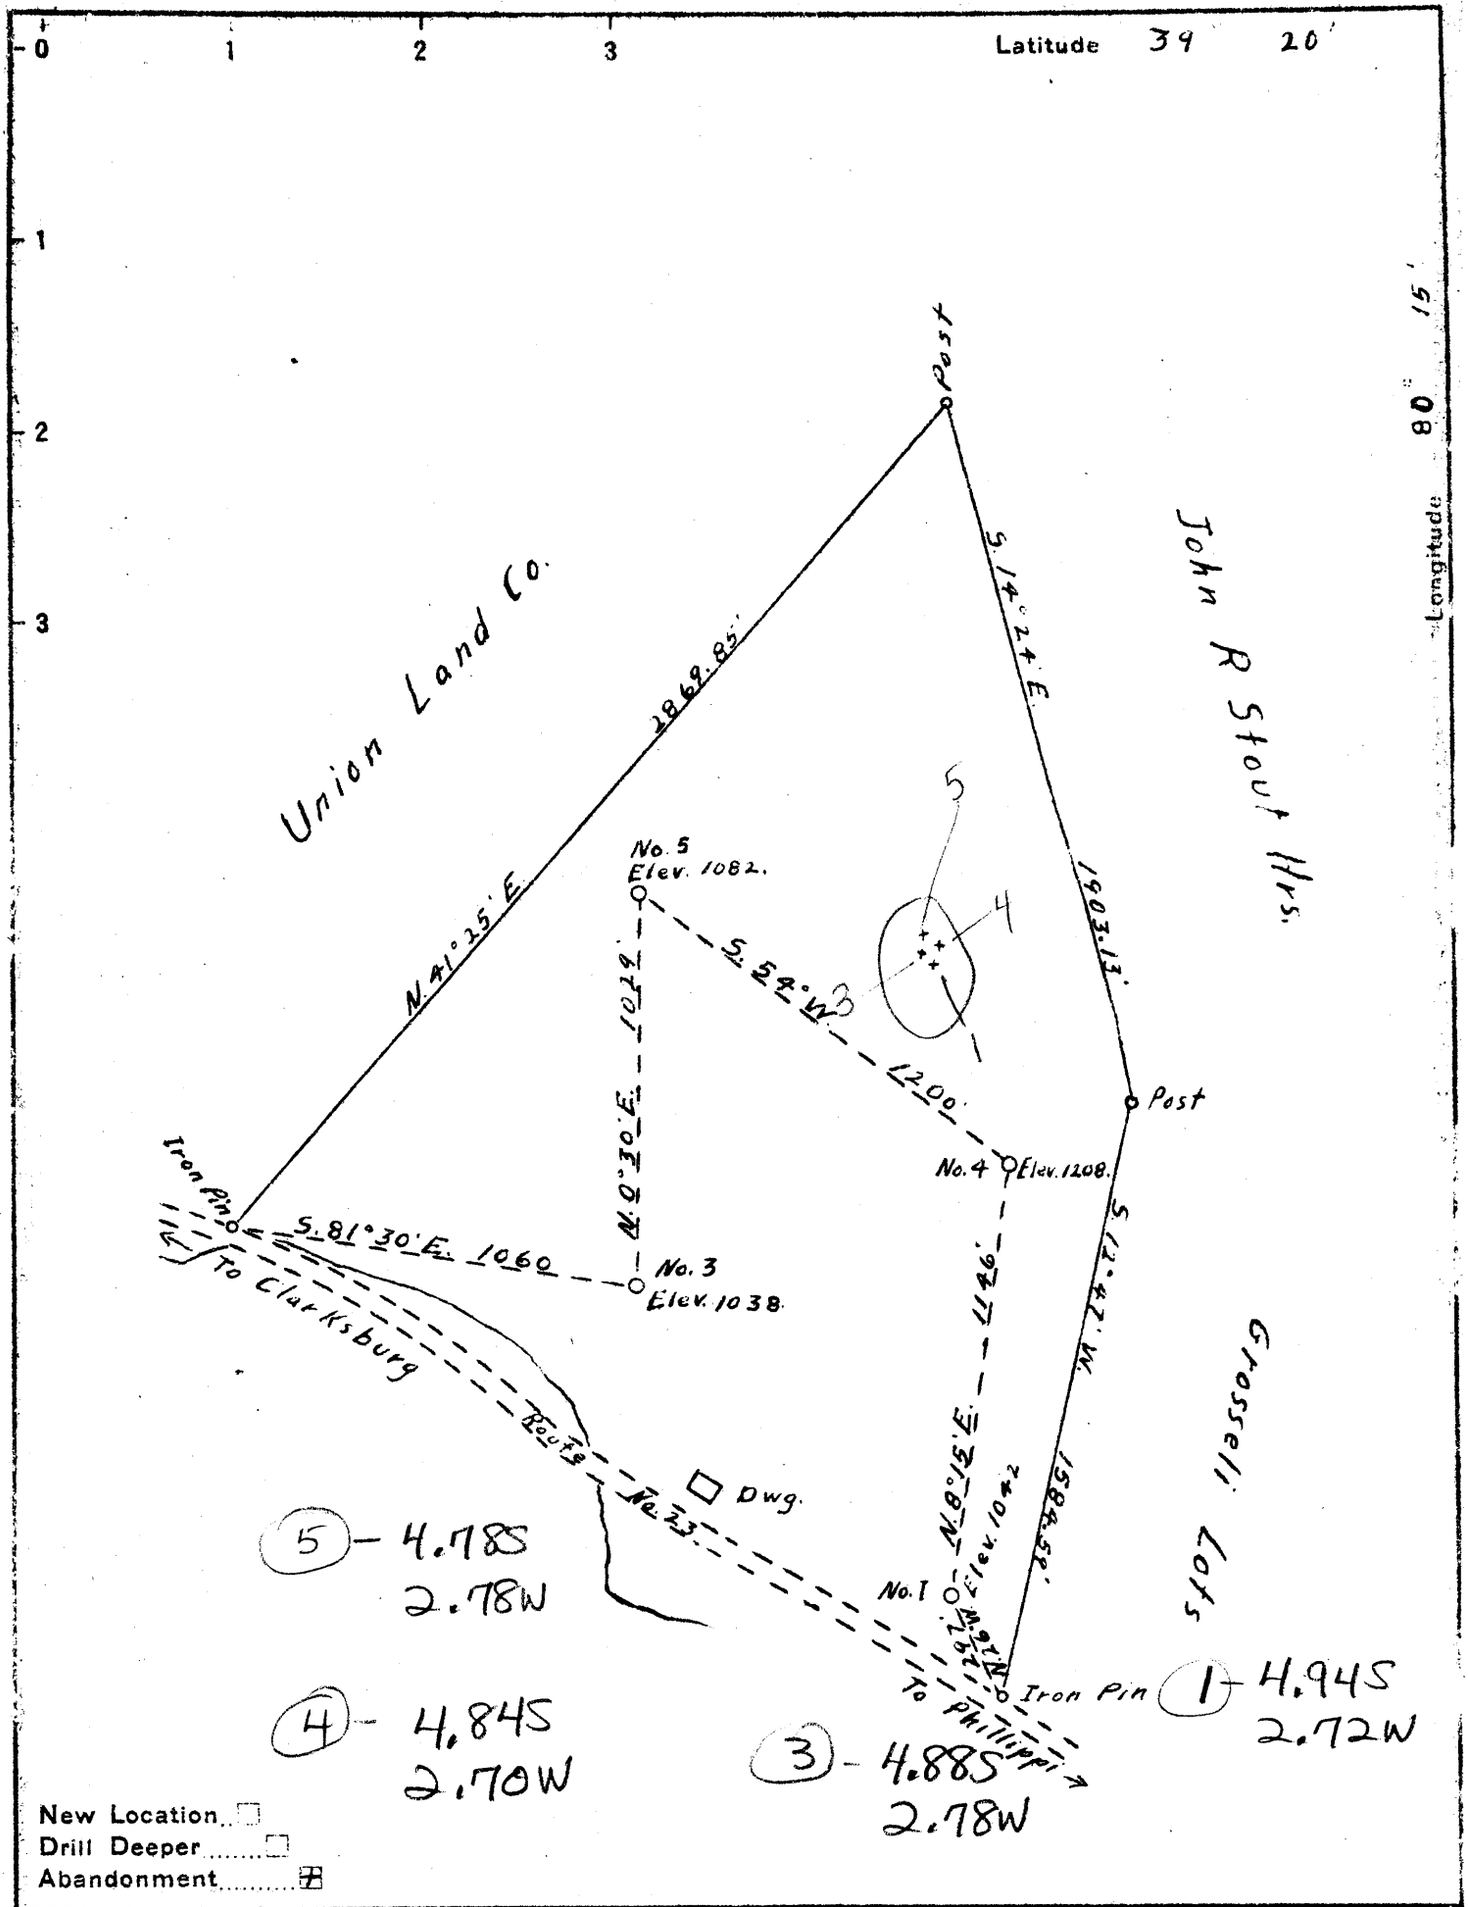

New Location ☐
Drill Deeper ☐
Abandonment ☒

Company William Moses
Address Main St. Salem W. Va.
Farm George Chorpening
Tract _____ Acres 92.3 Lease No. _____
Well (Farm) No. 1-3-4-5 Serial No. _____
Elevation (Spirit Level) 1042-1038-1208-1082
Quadrangle Clarksburg
County Harrison District Coal
Engineer A. T. Westfall
Engineer's Registration No. Surveyor, Kitchie Co.
File No. _____ Drawing No. _____
Date Sept. 22, 1943 Scale 1" = 500'

STATE OF WEST VIRGINIA
DEPARTMENT OF MINES
OIL AND GAS DIVISION
CHARLESTON

WELL LOCATION MAP

FILE NO. HAR-785-#4
HAR-787-#1
HAR-788-#5 } A
HAR-786-#3

+ Denotes location of well on United States Topographic Maps, scale 1 to 62,500, latitude and longitude lines being represented by border lines as shown.

— Denotes one inch spaces on border line of original tracing.

IMPERIAL TRACING CLOTH