


TOP HOLE
 NAD 83
 LAT. 38° 53' 29.98"
 LON. -81° 41' 21.07"
 UTM, NAD 83 ZONE 17, METERS
 N. 4304979.839
 E. 440230.919

ACTUAL LANDING POINT
 NAD 83
 LAT. 38° 53' 18.969"
 LON. -81° 41' 03.148"
 UTM, NAD 83 ZONE 17, METERS
 N. 4304637.238
 E. 440660.158

ACTUAL BOTTOM HOLE
 NAD 83
 LAT. 38° 52' 54.155"
 LON. -81° 41' 11.342"
 UTM, NAD 83 ZONE 17, METERS
 N. 4303873.819
 E. 440456.993

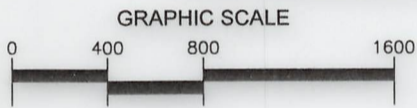


(+) DENOTES LOCATION OF WELL ON UNITED STATES TOPOGRAPHIC MAPS

FILE No 2201-2345-001-011
 DRAWING No. RIPLEY-12411
 SCALE 1"=800'
 MINIMUM DEGREE OF ACCURACY 1:200
 PROVEN SOURCE OF ELEVATION TRIMBLE R10
GPS UNIT

I THE UNDERSIGNED, HEREBY CERTIFY THAT THIS PLAT IS CORRECT TO THE BEST OF MY KNOWLEDGE AND BELIEF AND SHOWS ALL THE INFORMATION REQUIRED BY LAW AND THE REGULATIONS ISSUED AND PRESCRIBED BY THE DIVISION OF ENVIRONMENTAL PROTECTION.

(SIGNED) *R. Thaw*
ROBERT F. THAW PS #965

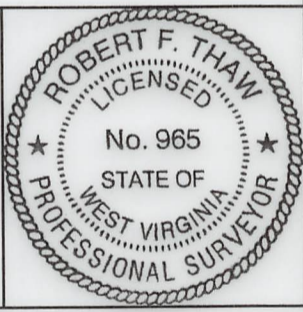

STATE OF WEST VIRGINIA
 DIVISION OF ENVIRONMENTAL PROTECTION
 OFFICE OF OIL AND GAS
 NITRO, WV



DATE SEPTEMBER 04 2024
 OPERATOR'S WELL No. 12411
 API WELL No.

WELL TYPE: OIL GAS LIQUID INJECTION WASTE DISPOSAL STATE 47 COUNTY 035 PERMIT 02460
 (IF "GAS") PRODUCTION STORAGE DEEP SHALLOW
 LOCATION: ELEVATION 616.2' WATER SHED SANDY CREEK
 DISTRICT RAVENSWOOD COUNTY JACKSON
 QUADRANGLE SANDYVILLE, WV

SURFACE OWNER DAVID W. & MARCELLA R. CURRY ACREAGE 37.82
 OIL & GAS ROYALTY OWNER SALLIE L. HITE (SUR.) OTIS & Katie Coast (BHL)
 LEASE ACREAGE 38.5 (SUR.) 50 (BHL) LEASE NO. 1052507 (SUR.) 1052786 (BHL) 02 SEP 19 2025

PROPOSED WORK: DRILL CONVERT DRILL DEEPER REDRILL FRACTURE
 STIMULATE PLUG OFF OLD FORMATION PERFORATE NEW FORMATION
 OTHER PHYSICAL CHANGE IN WELL (SPECIFY) REWORK
 PLUG AND ABANDON CLEAN OUT AND REPLUG

TARGET FORMATION ORISKANY ESTIMATED DEPTH 4810' TVD/9100' MD
 WELL OPERATOR COLUMBIA GAS TRANSMISSION, LLC DESIGNATED AGENT MARIA MEDVEDEVA
 ADDRESS PO BOX 1273, CHARLESTON, WV 25325-1273 ADDRESS 1700 MACCORKLE AVE., S.E. CHARLESTON, WV 25314

FORM IV-6 (8-78)