

WW-7  
8-30-06



West Virginia Department of Environmental Protection  
Office of Oil and Gas

**WELL LOCATION FORM: GPS**

API: 47-39-01172 WELL NO.: L.M. Bryan  
 FARM NAME: L.M Bryan  
 RESPONSIBLE PARTY NAME: Shale Gas Production, LLC  
 COUNTY: Kanawha DISTRICT: Jefferson  
 QUADRANGLE: St. Albans  
 SURFACE OWNER: Donald C. Bryan/David Curtis Bryan  
 ROYALTY OWNER: Bryan Heirs  
 UTM GPS NORTHING: 4246526.6  
 UTM GPS EASTING: 423653.2 GPS ELEVATION: 711.28

The Responsible Party named above has chosen to submit GPS coordinates in lieu of preparing a new well location plat for a plugging permit or assigned API number on the above well. The Office of Oil and Gas will not accept GPS coordinates that do not meet the following requirements:

1. Datum: NAD 1983, Zone: 17 North, Coordinate Units: meters, Altitude: height above mean sea level (MSL) – meters.
2. Accuracy to Datum – 3.05 meters
3. Data Collection Method:

Survey grade GPS  : Post Processed Differential

Real-Time Differential

Mapping Grade GPS  : Post Processed Differential

Real-Time Differential

4. Letter size copy of the topography map showing the well location.

I the undersigned, hereby certify this data is correct to the best of my knowledge and belief and shows all the information required by law and the regulations issued and prescribed by the Office of Oil and Gas.

*L.M. Bryan* *Land Manager* *10/2/17*  
 Signature Title Date


RECEIVED  
Office of Oil and Gas

OCT 03 2017


WV Department of  
Environmental Protection

10/20/2017

47039011729

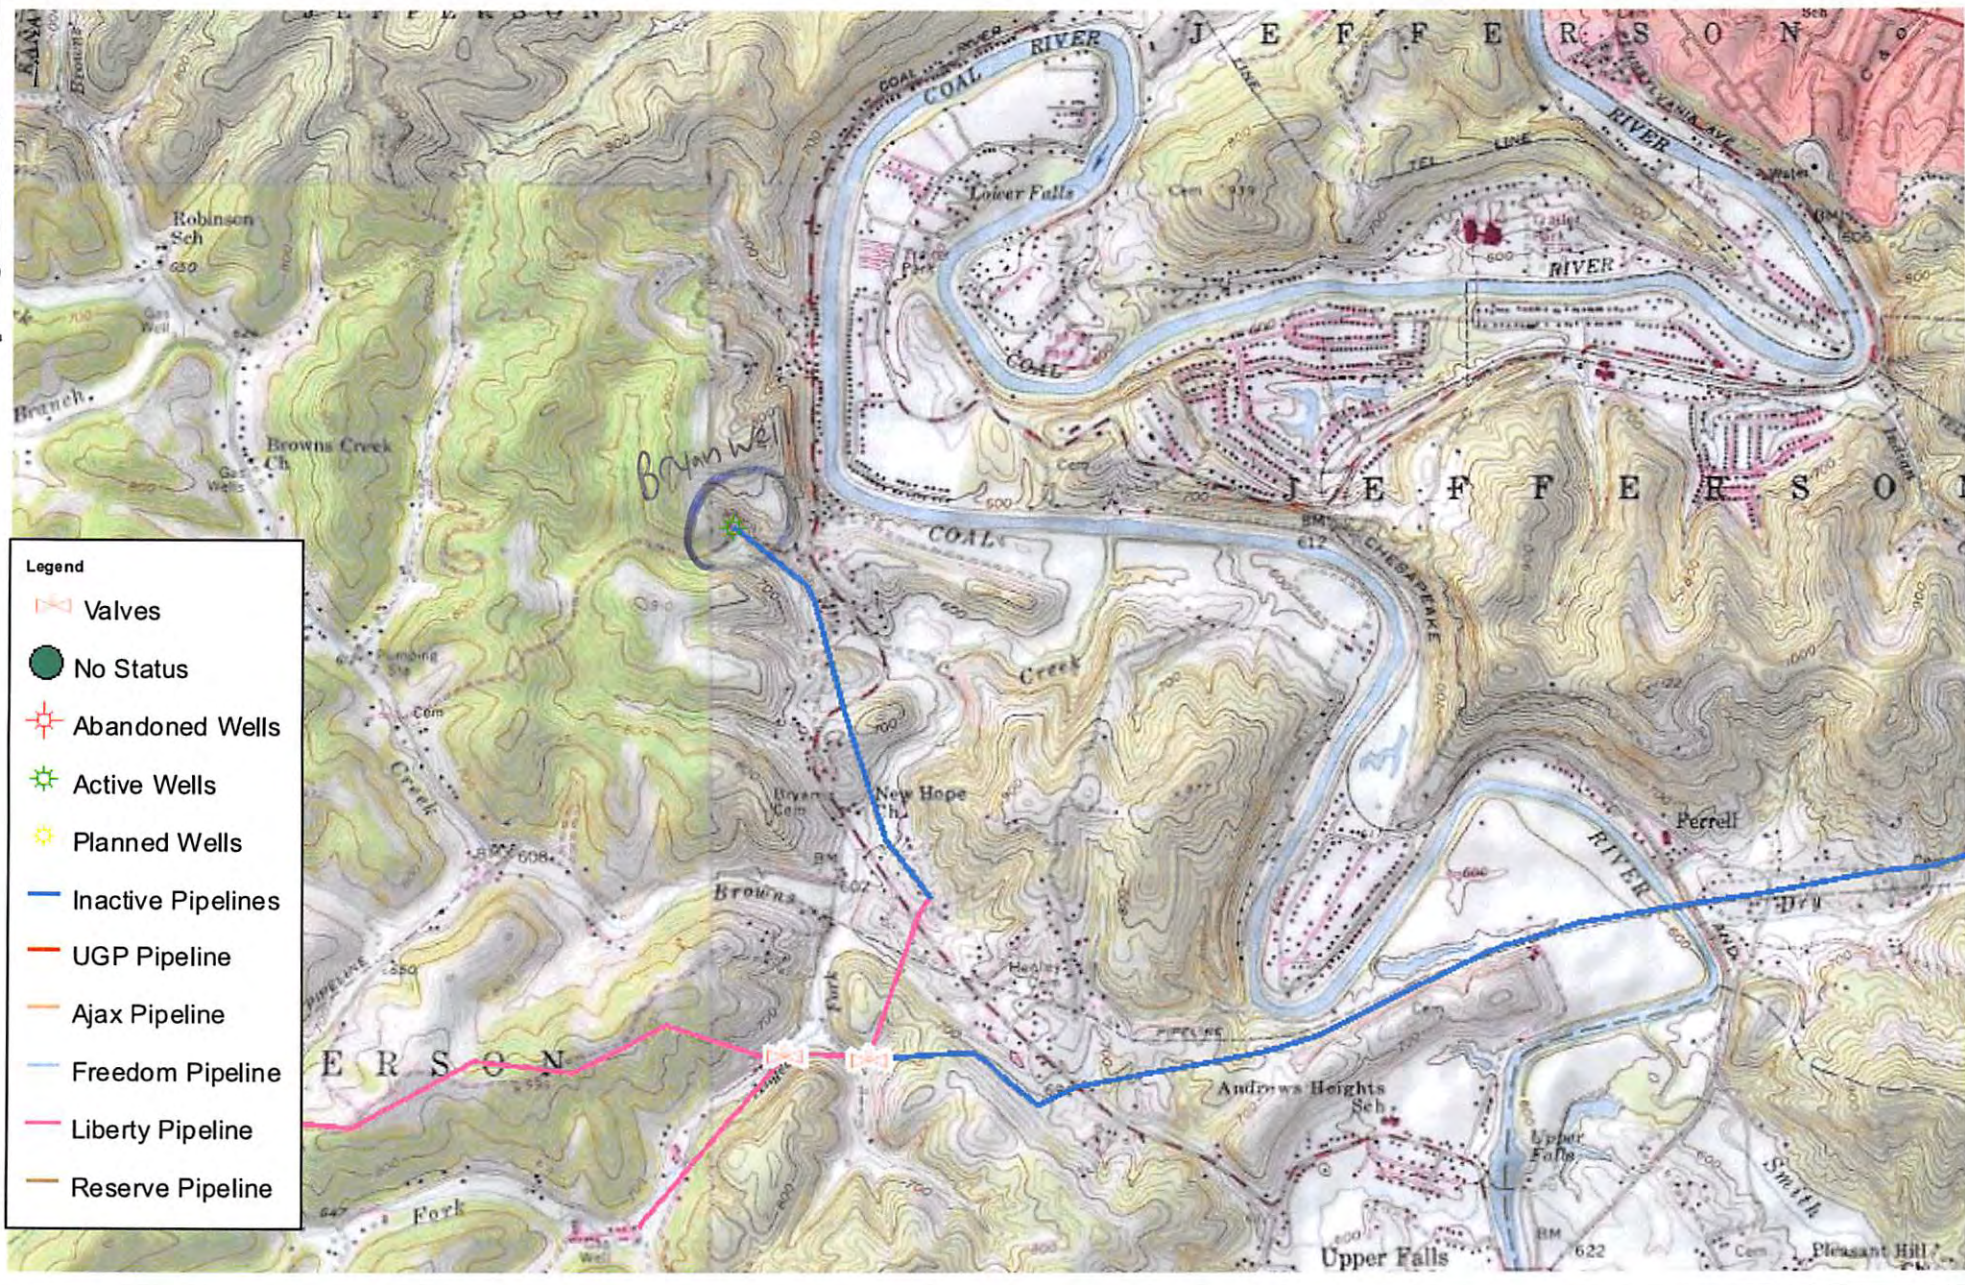

- Legend**
- Valves
  - No Status
  - Abandoned Wells
  - Active Wells
  - Planned Wells
  - Inactive Pipelines
  - UGP Pipeline
  - Ajax Pipeline
  - Freedom Pipeline
  - Liberty Pipeline
  - Reserve Pipeline

TITLE	CREATED BY	Administrator	SCALE
	DATE	7/17/2017	
	DETAILS		 Web Map
	Coordinate System: WGS 1984 Web Mercator Auxiliary Sphere Projection: Mercator Auxiliary Sphere Datum: WGS 1984		
test	SCALE	1:35,496	0    295    590    1,180 Yards 