

WW-7
8-30-06



West Virginia Department of Environmental Protection
Office of Oil and Gas

WELL LOCATION FORM: GPS

API: 47-039-01734 WELL NO.: Coll-Carpenter Unit #1
 FARM NAME: Cole - Carpenter
 RESPONSIBLE PARTY NAME: Troy M. Valasek
 COUNTY: Kanawha DISTRICT: Washington
 QUADRANGLE: St. Albans
 SURFACE OWNER: Robert K. Coll & Timothy F. Coll
 ROYALTY OWNER: Robert K. Coll & Timothy F. Coll
 UTM GPS NORTHING: 4241245.6
 UTM GPS EASTING: 426168.5 GPS ELEVATION: 651.91

The Responsible Party named above has chosen to submit GPS coordinates in lieu of preparing a new well location plat for a plugging permit or assigned API number on the above well. The Office of Oil and Gas will not accept GPS coordinates that do not meet the following requirements:

1. Datum: NAD 1983, Zone: 17 North, Coordinate Units: meters, Altitude: height above mean sea level (MSL) – meters.
2. Accuracy to Datum – 3.05 meters
3. Data Collection Method:

Survey grade GPS ____: Post Processed Differential ____

Real-Time Differential ____

Mapping Grade GPS ____: Post Processed Differential ____

Real-Time Differential ____

4. **Letter size copy of the topography map showing the well location.**

I the undersigned, hereby certify this data is correct to the best of my knowledge and belief and shows all the information required by law and the regulations issued and prescribed by the Office of Oil and Gas.


Signature

Sr. Landman


Title

10/13/20
Date

RECEIVED
Office of Oil and Gas

OCT 27 2020

WV Department of
Environmental Protection

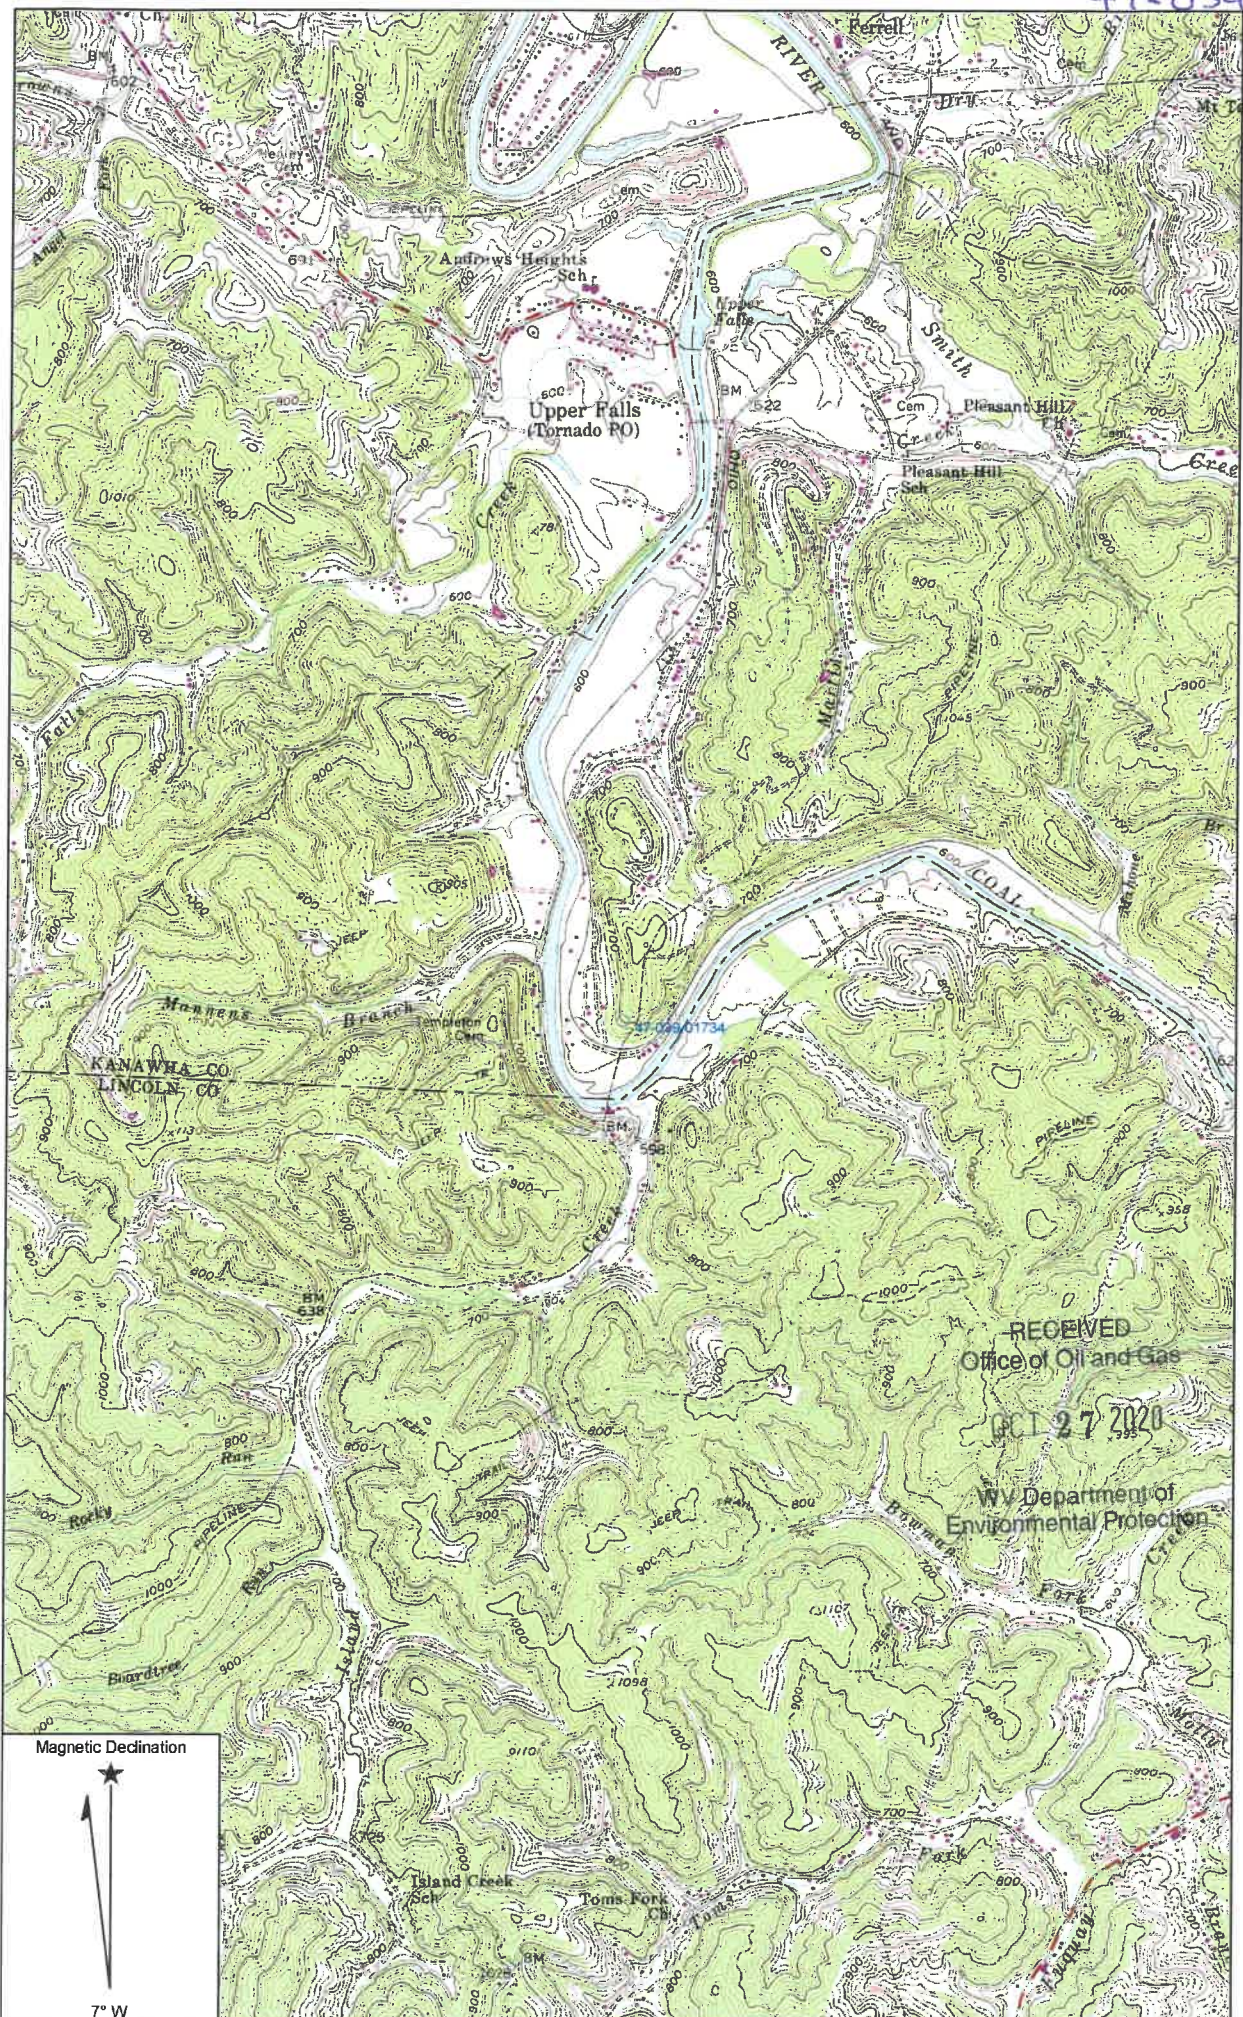

RECEIVED
Office of Oil and Gas
OCT 27 2020
WV Department of
Environmental Protection

